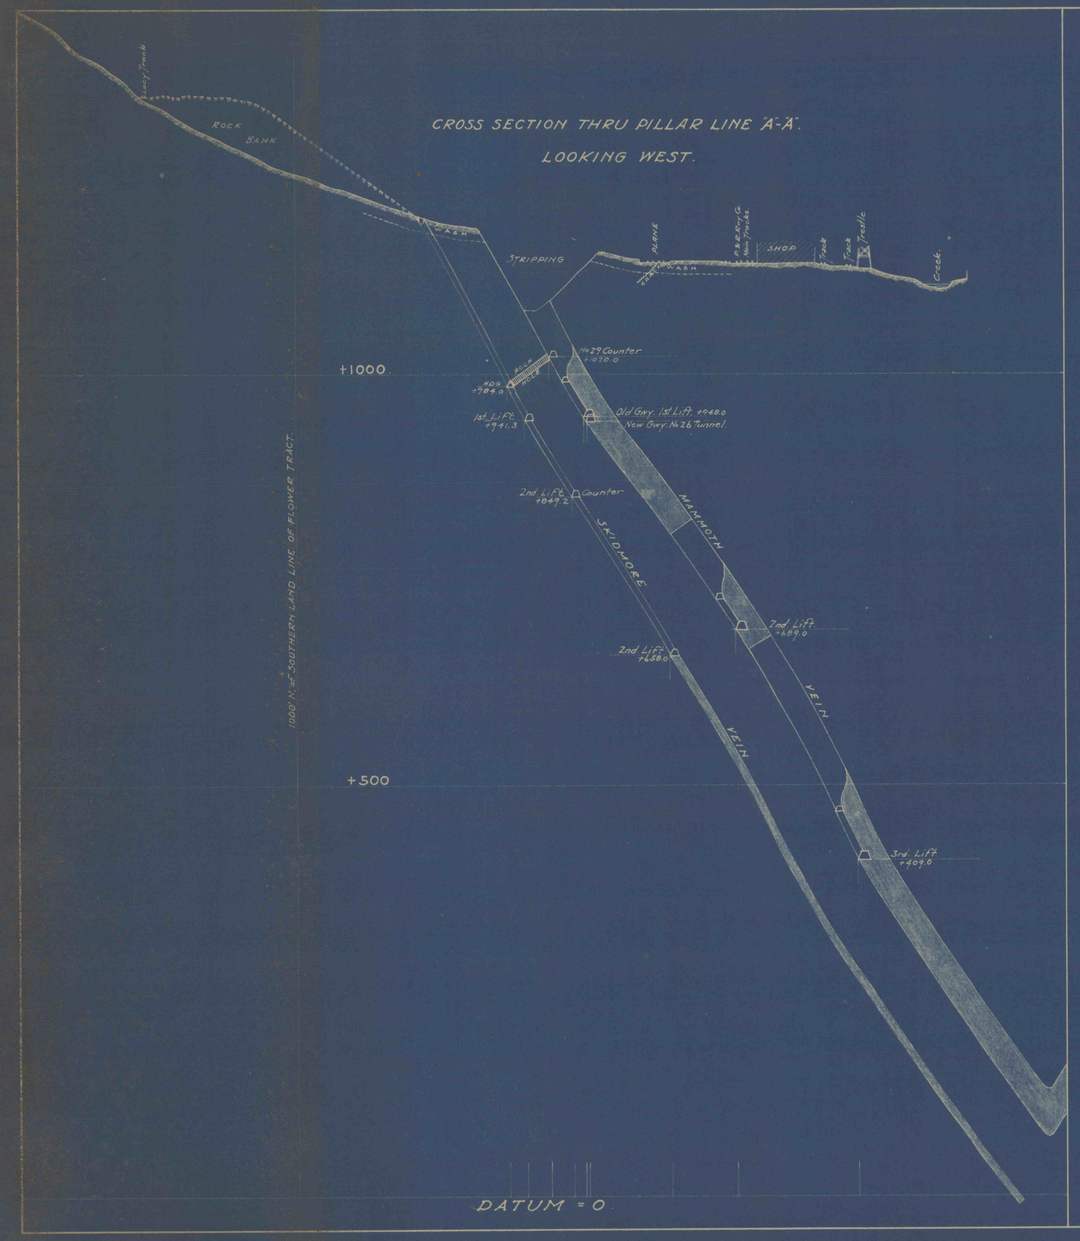

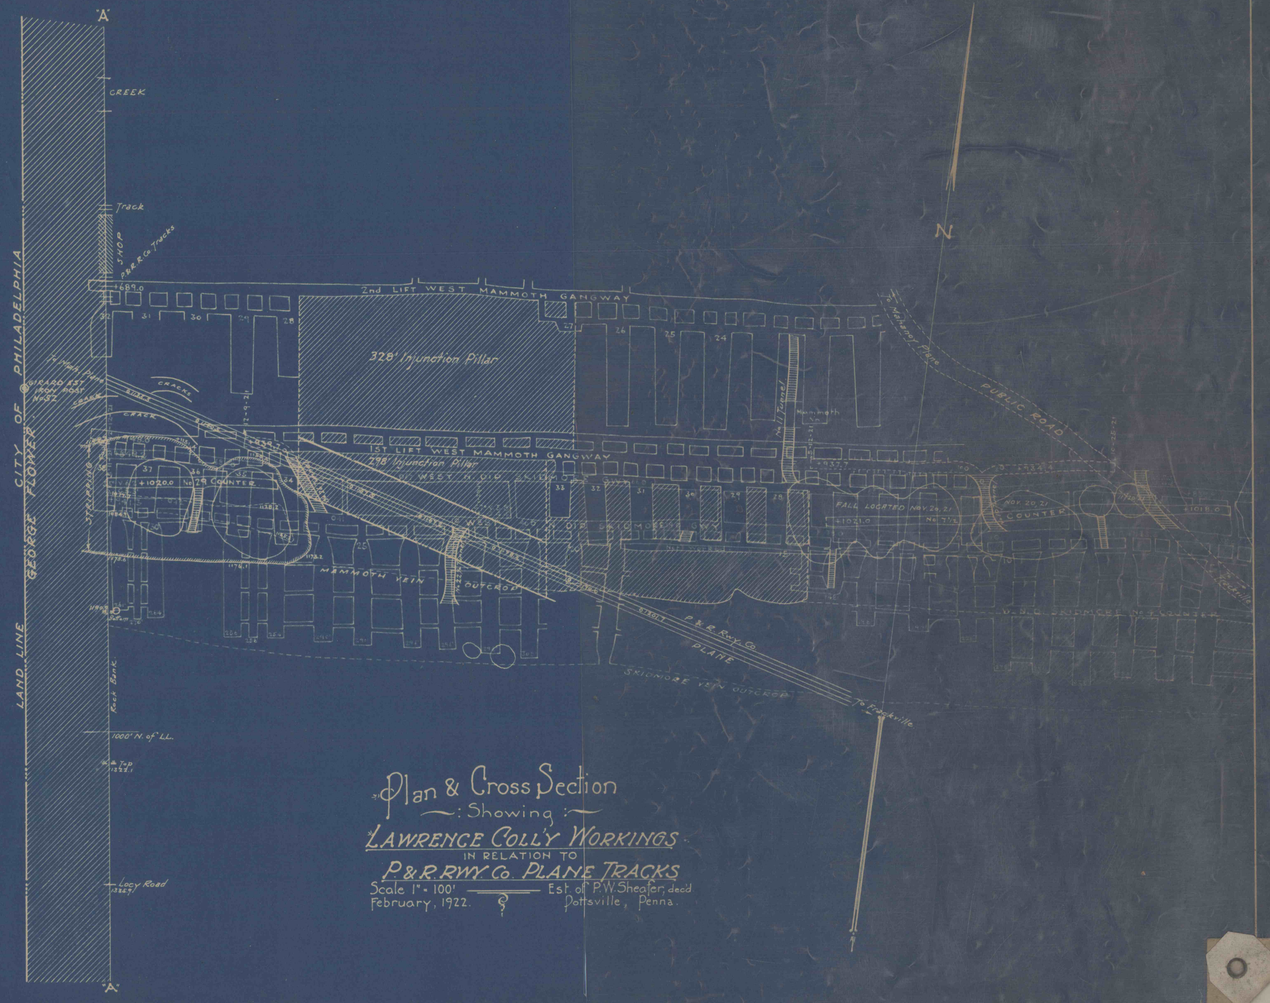

Plan & Cross Section
: Showing :
LAWRENCE COLLY WORKINGS
IN RELATION TO
P.&R.RWY. Co. PLANE TRACKS

Scale 1" = 100'
February, 1922.

Est. of P.W. Sheafer, decd
Pottsville, Penna.