


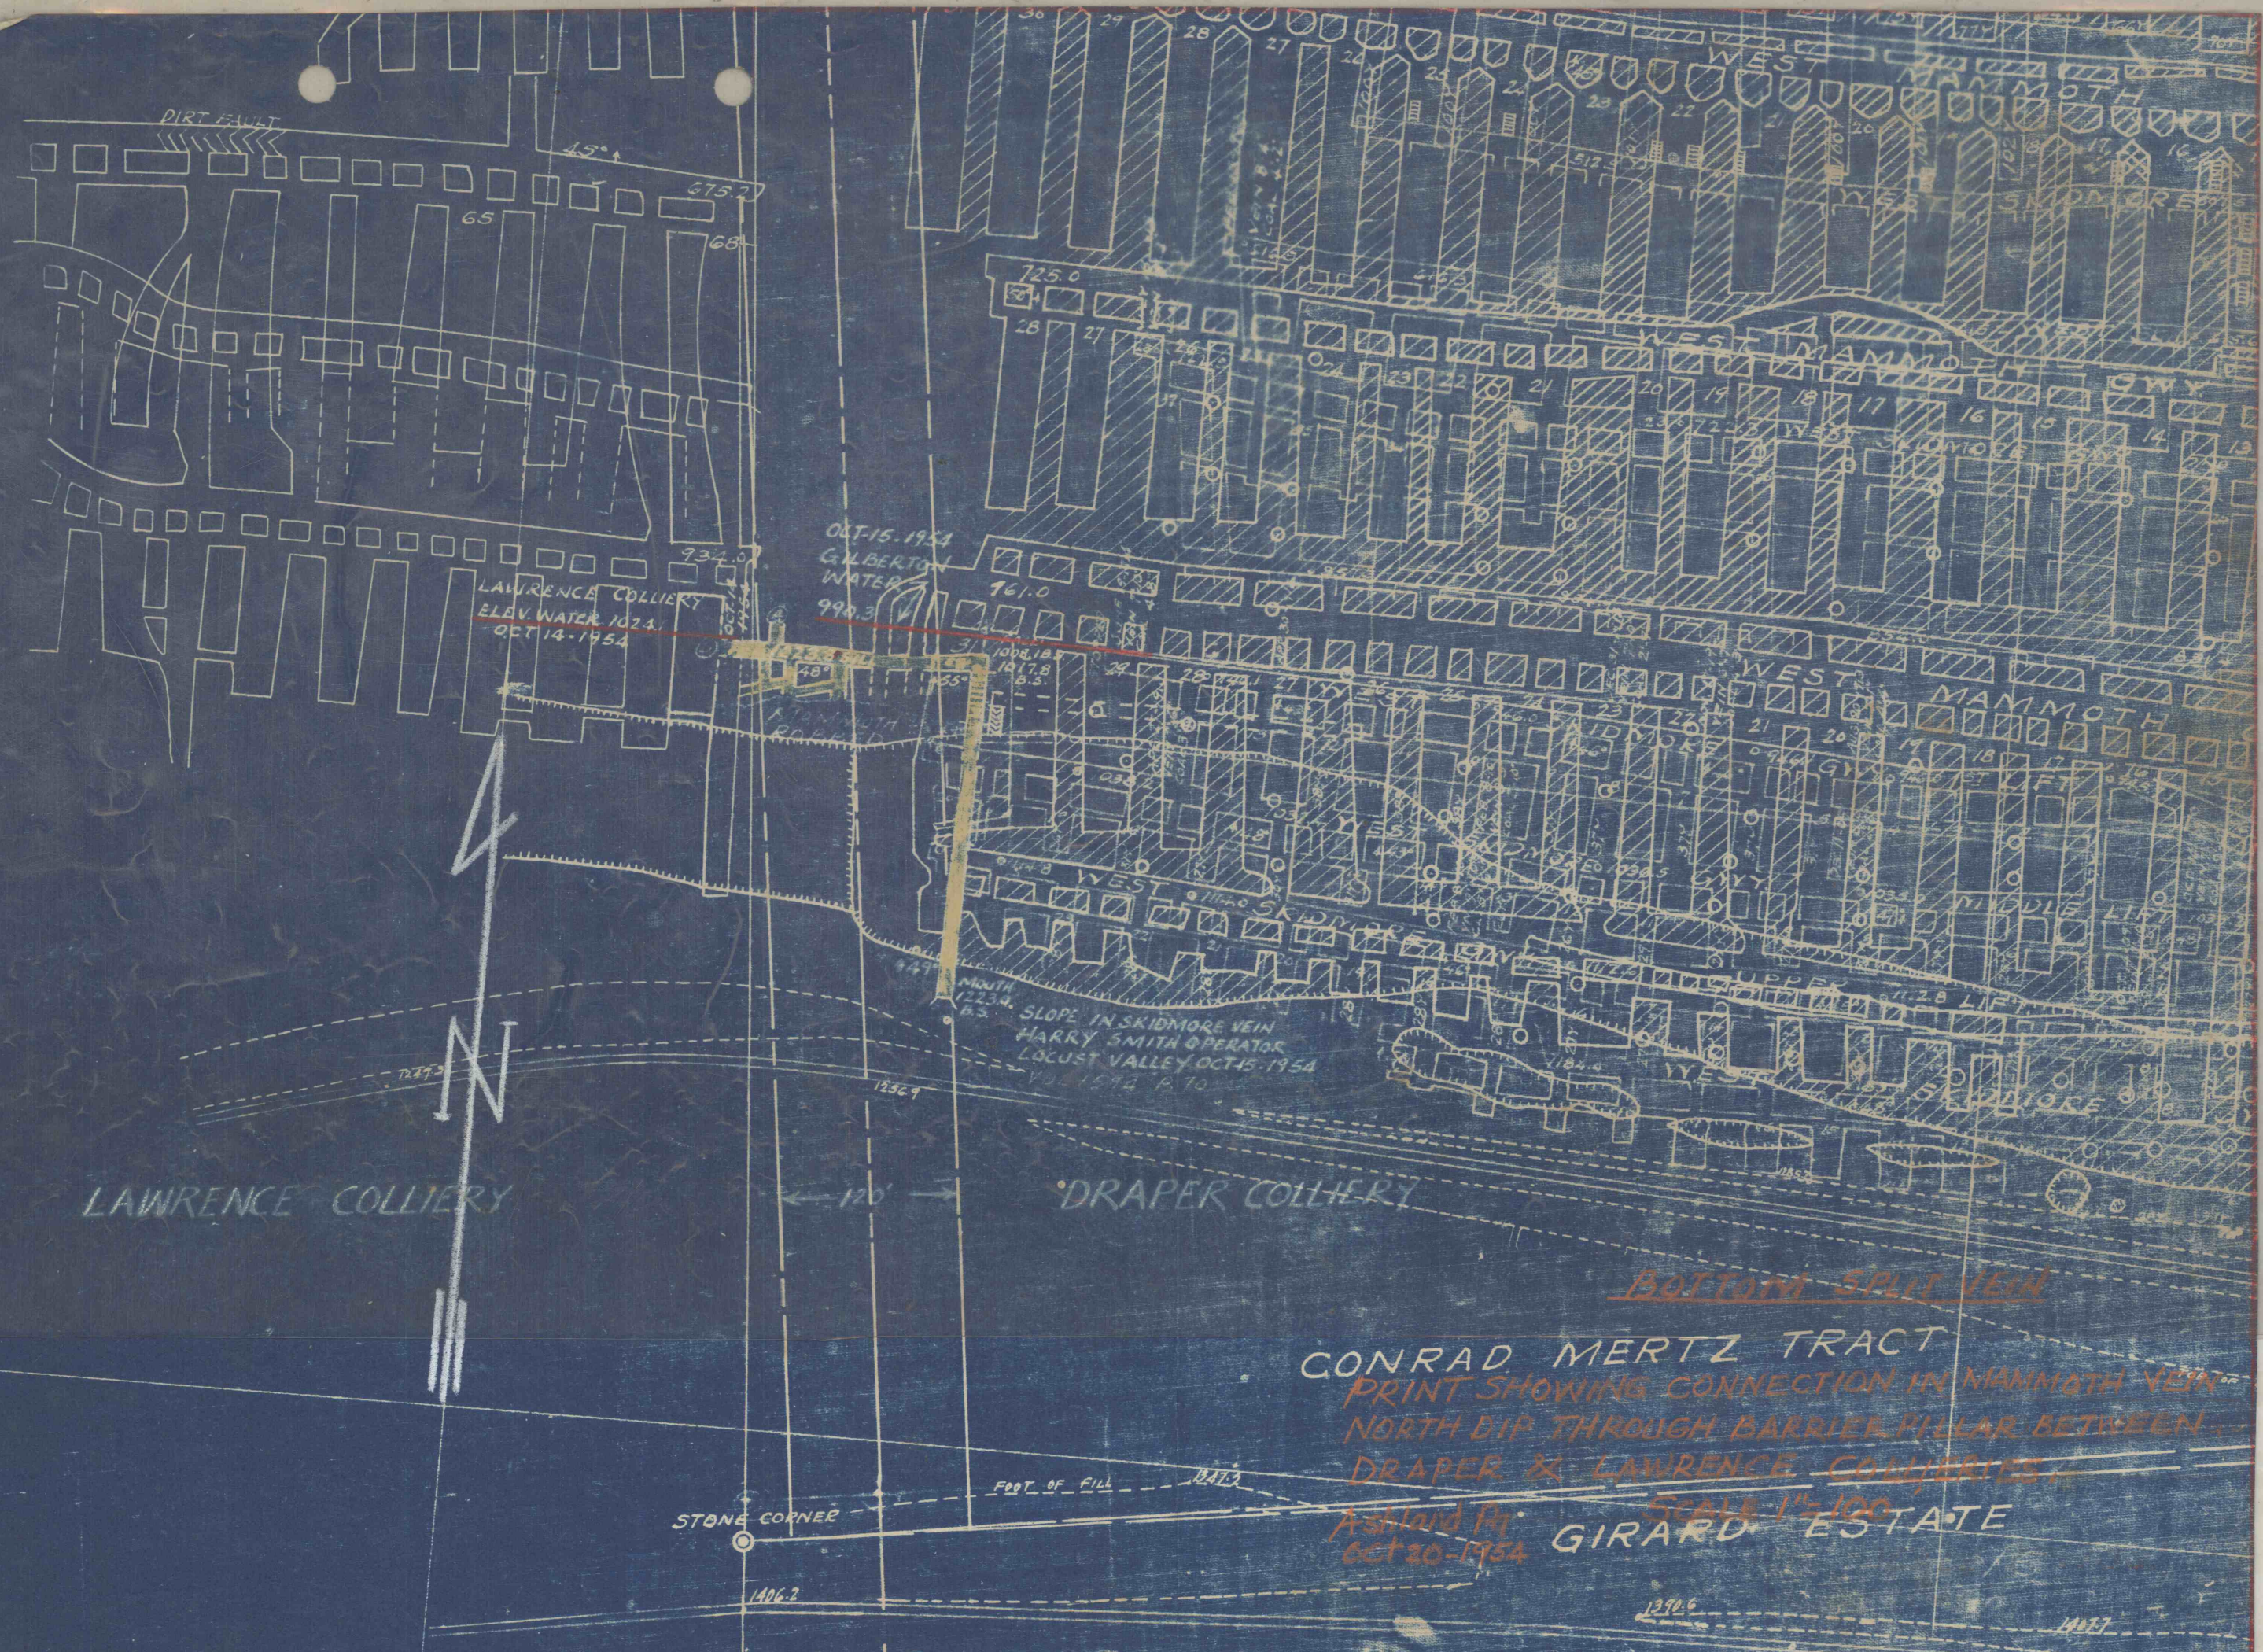

LAWRENCE COLLIERY

DRAPER COLLIERY

BOTTOM SPLIT VEIN
CONRAD MERTZ TRACT
PRINT SHOWING CONNECTION IN MAMMOTH VEIN
NORTH DIP THROUGH BARRIER PILLAR BETWEEN
DRAPER & LAWRENCE COLLIERIES.

Ashland Pk.
OCT 30, 1954
SCALE 1" = 100'
GIRARD ESTATE

STONE CORNER

FOOT OF FILL