


GIRARD COLLIERY "E"
CROSS SECTION ON COORDINATE LINE WEST 1500
SCALE 1"=100' ENGINEERING DEPT. OCT-17-1922
HAZLETON, PA.

NORTH

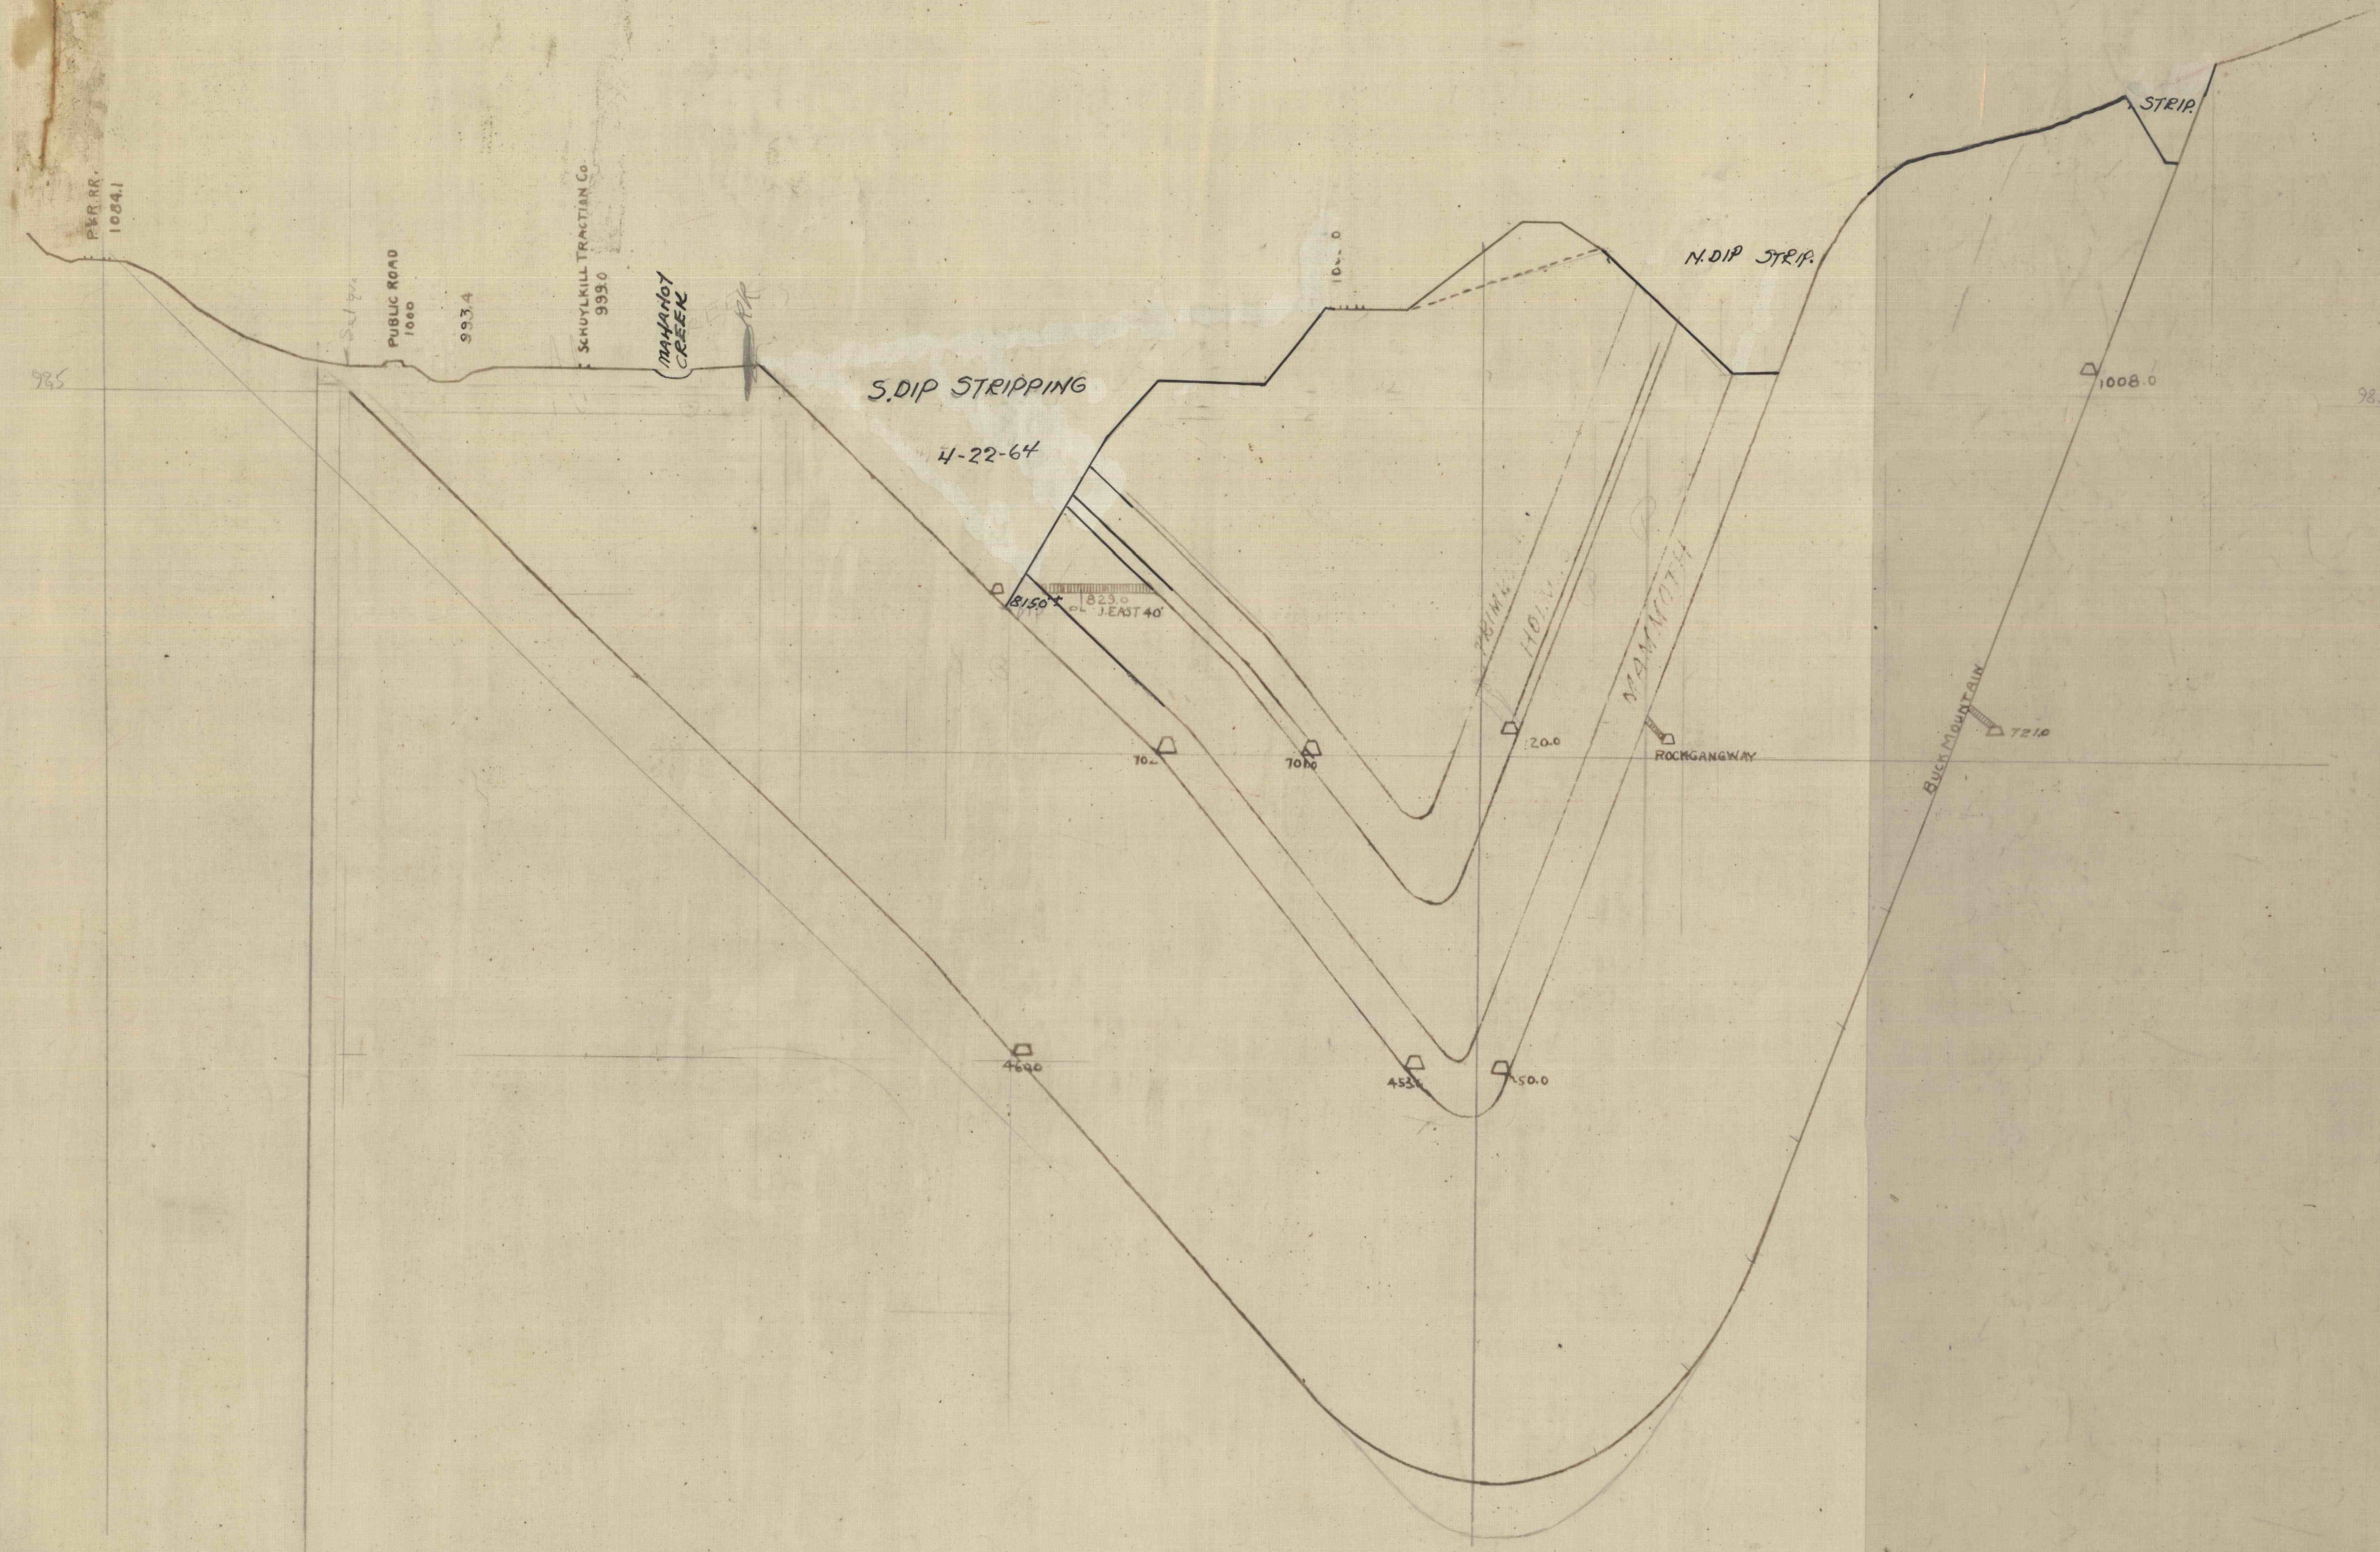

DATUM MEAN TIDE