


CROSS SECTION "F" ON COORDINATE LINE WEST 500

GIRARD COLLIERY
HAZLE BROOK COAL CO
Scale 1"=100' Eng. Department Feb. 26, 1929
Jeddo, Pa.

NORTH

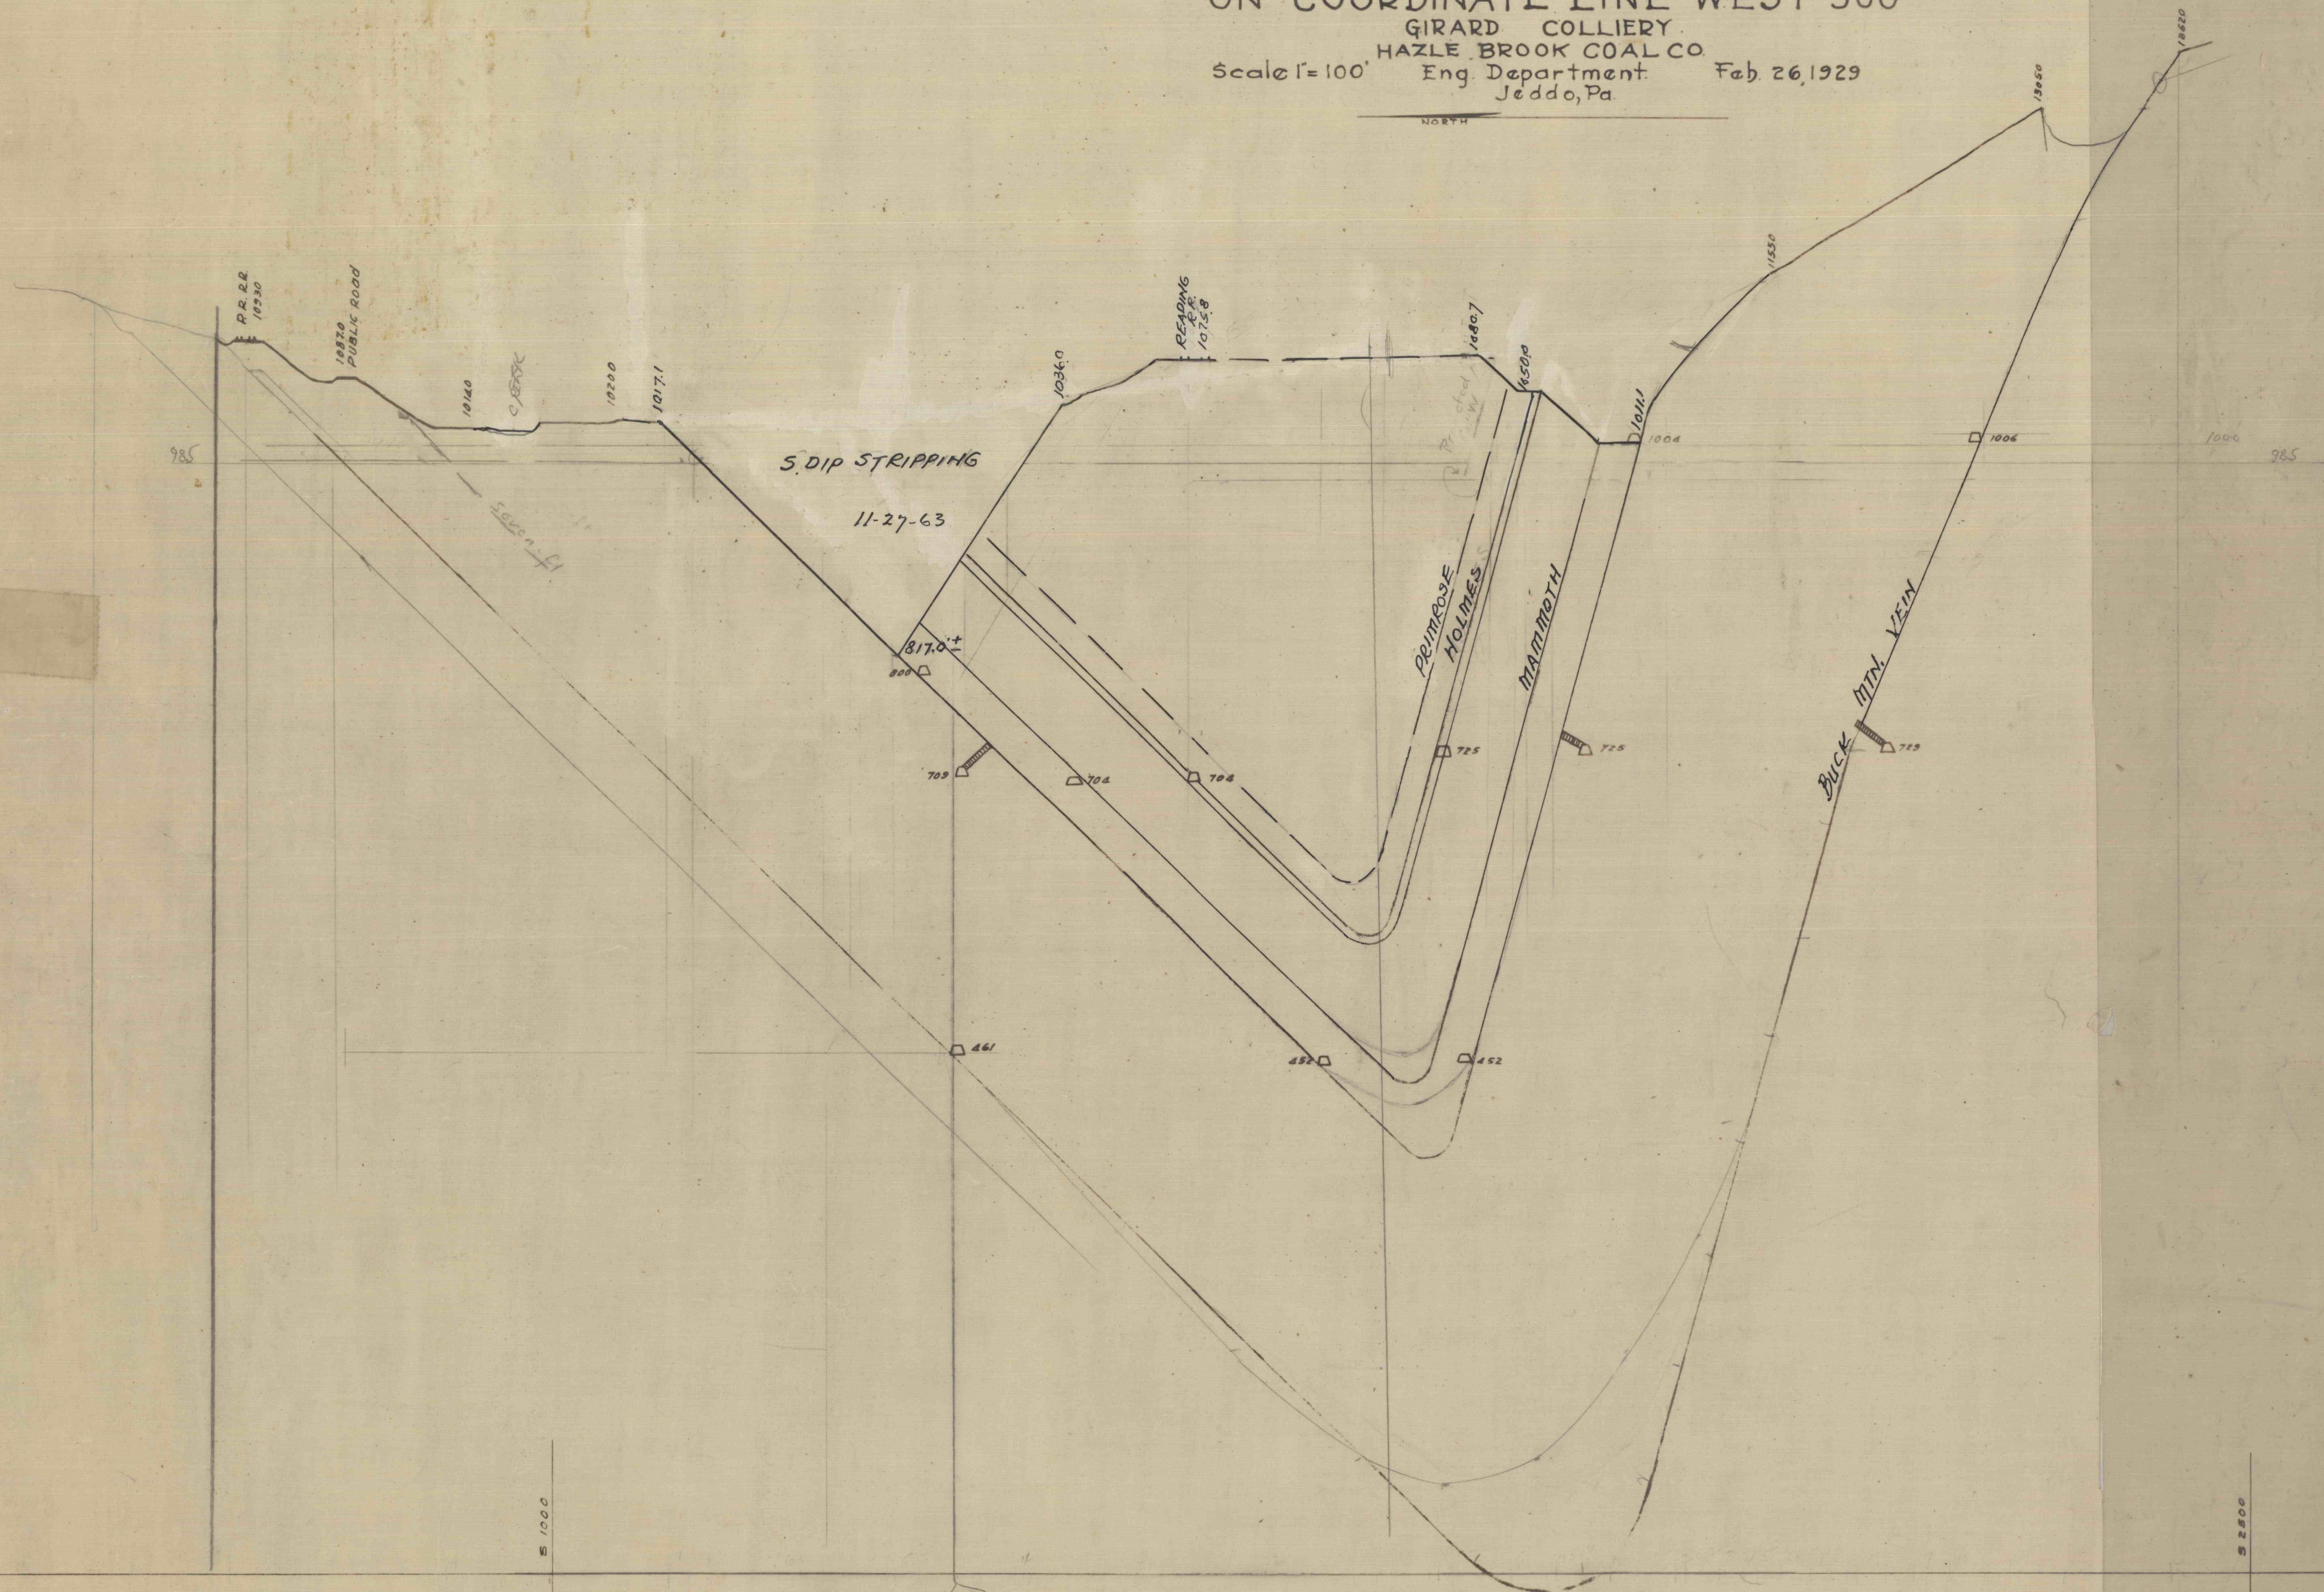

DATUM - MEAN TIDE