


Boudinot Estate.
 Tracts incorrectly located by May
 See Map - (blue print) by A. B. Cochran.
 H.S.I.

Contents of the several tracts of land contained on this Map

	As	715
1 Thomas Hamilton	531	140
2 William Gray	531	140
3 Robert Gray	531	140
4 William Brady	531	140
5 John Brady	531	140
6 Alexander Fulton	531	140
7 Joseph Wallace	560	100
8 Jeremiah Jackson	560	100
9 Thomas Reese	560	100
10 Daniel Reese	560	100
11 Samuel Ewing	244	60
12 Ann Ewing	278	
13 John Ewing	460	
14 Hanna Ewing	460	
15 William Ewing	425	
16 Washington Hall	460	
17 Henry Hall	460	
18 Samuel Chew	466	
19 Elisha J. Hall	508	80
20 Geo Ewing	168	
21 Francis Johnston	635	115
22 Thomas Grant	460	
23 John Barron	165	
24 William Wallace	455	
25 James Davidson	471	
26 William Davidson	528	
27 John Davidson	453	
28 Robert Davidson	299	118
29 James Ewing	354	
Thirteen thousand one	13185	13
hundred & eighty five acres and		
thirteen perches		

There is an improvement of about 20 acres cleared and cabin house on the Robert & John Davidson tracts, the property is claimed by Thomas Perry, who resides on the opposite side of the River in James Blunson County, there is no person residing on the premises at present. Perry claims under the improvement of one, Isaac Herington, who claimed by virtue of an improvement made by himself without a warrant or survey.

James Moore claims a part of the Robert Davidson, in right of James Hill, who improved it and lived on the land over 40 years ago, there is some 40 acres cleared, with a house and barn, which is now in the occupancy of one Huling as a rental.

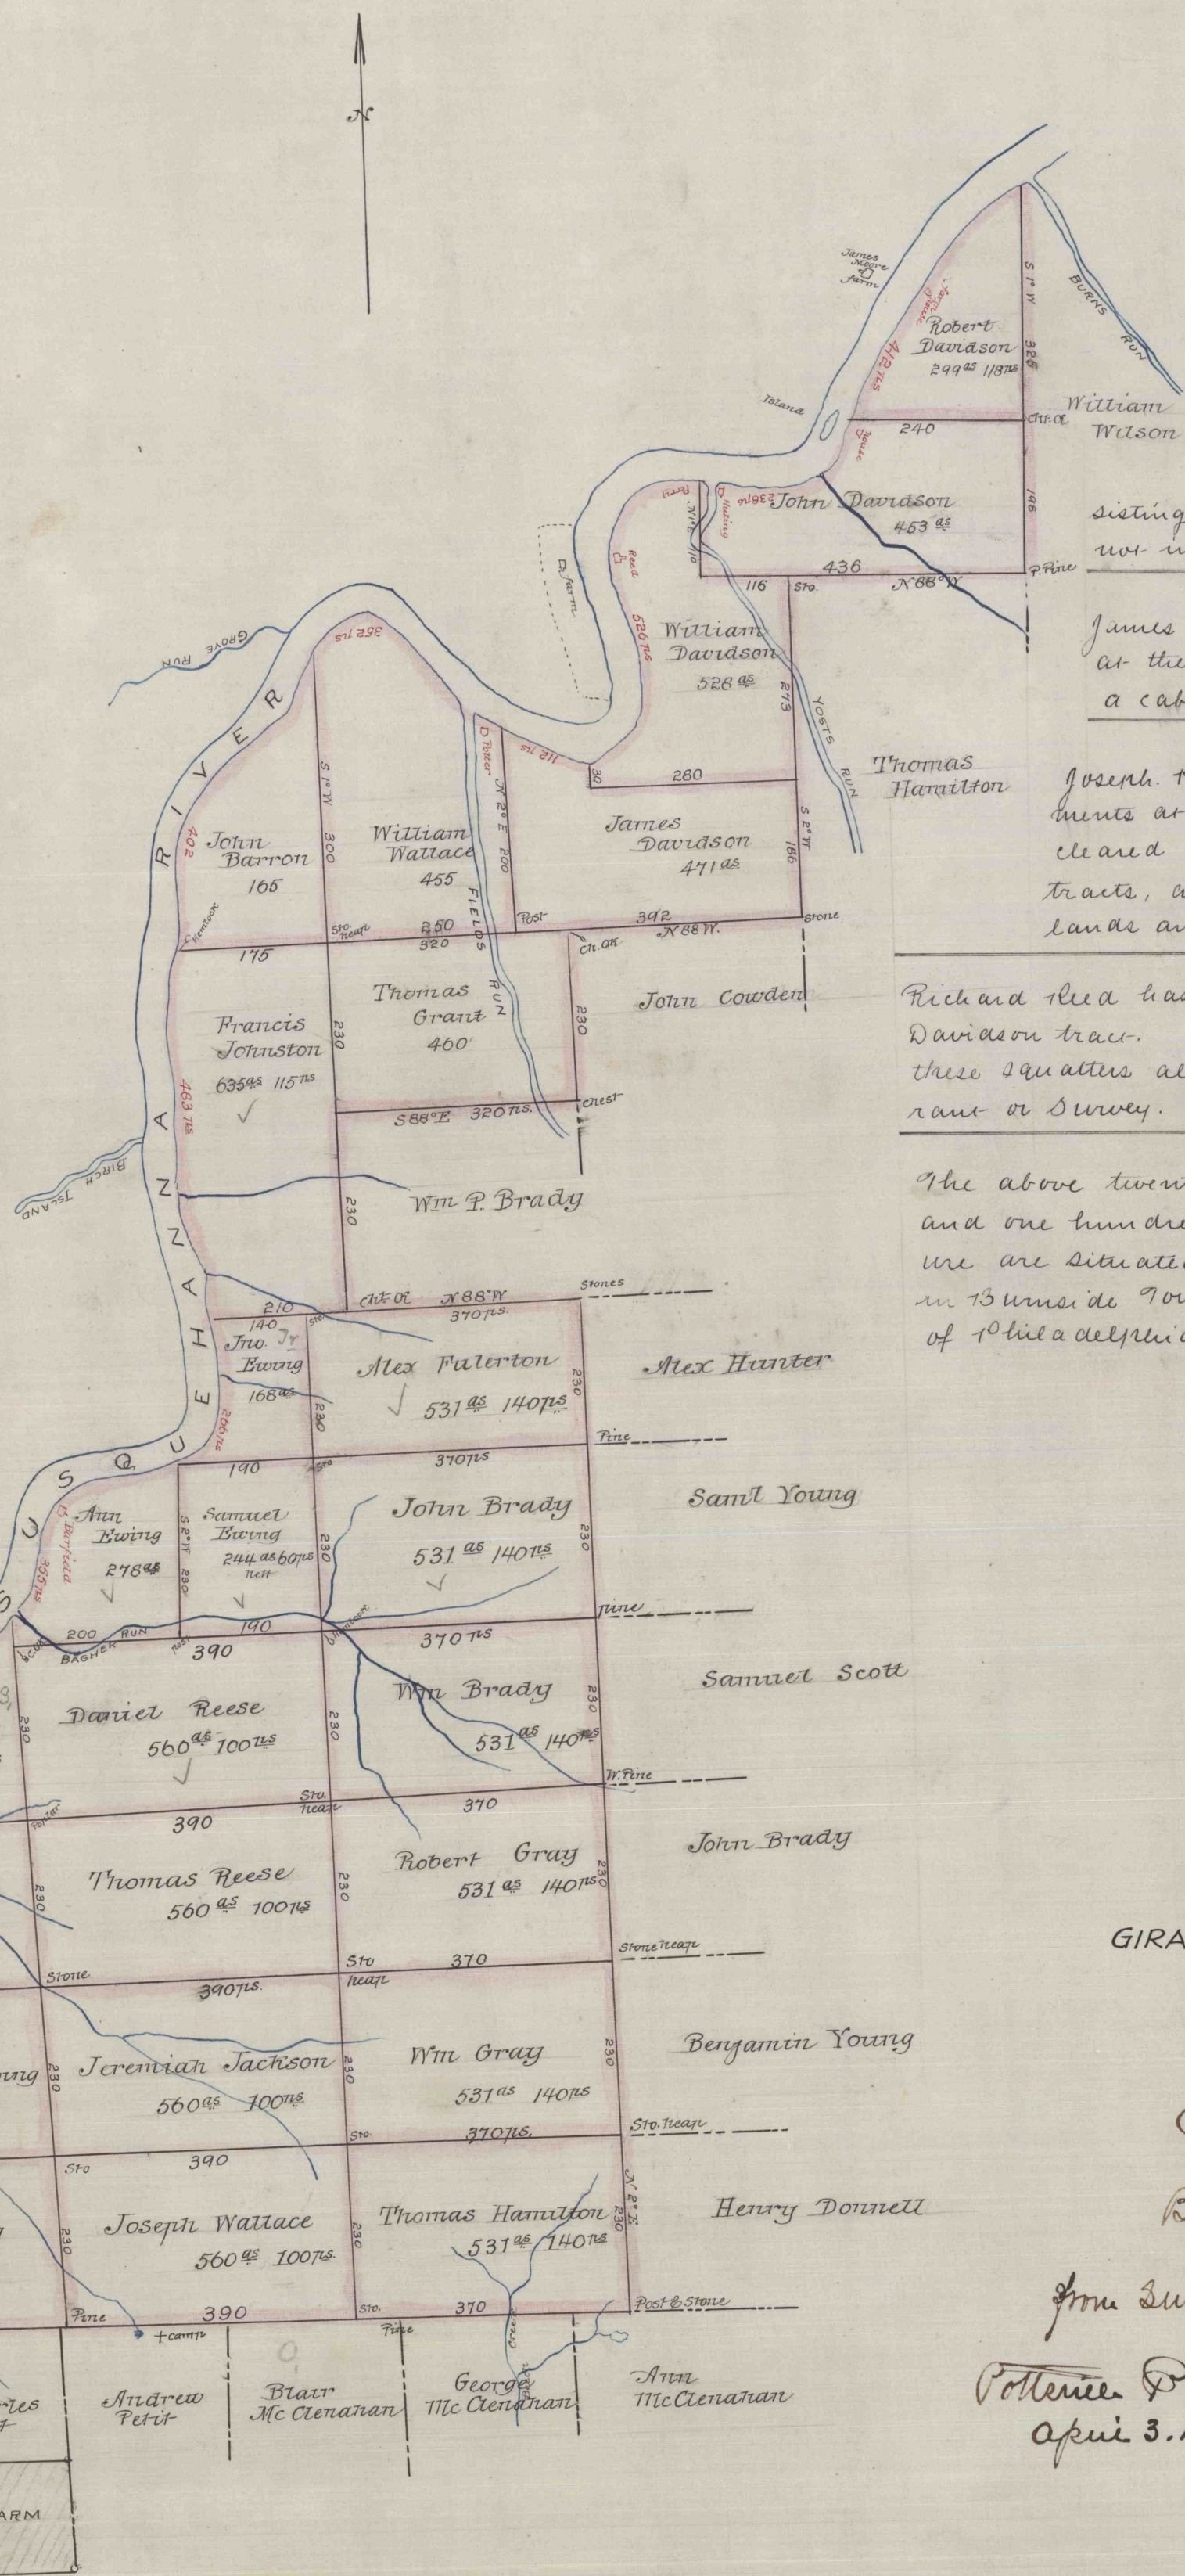

Note. George Barfield has a small improvement consisting of a cabin house and an acre or two cleared but not inclosed with fence, all upon the Ann Ewing tract.

James Potter (Colored) lives on the William Wallace tract at the mouth of Fields Run, he has a few acres cleared a cabin house &c

Joseph Perry and Samuel Huling have cabins and improvements at the mouth of Yotts Run, they have a few acres cleared on both the Wm Davidson and Geo Davidson tracts, and employ their time stealing timber from those lands and surrounding neighborhood.

Richard Reed has a cabin and small improvement on the William Davidson tract. these squatters all claim under improvements having neither Warrant or Survey.

The above twenty nine tracts of land, containing thirteen thousand one hundred and eighty five acres & 13 perches strictly measure are situated on the south side of the Susquehanna River in Bumside Township Centre County, resurveyed for the City of Philadelphia in September & October 1859.

By
 Sig. Jos. F. May
 Surveyor

GIRARD ESTATE MAP No. 629^H

Boudinot Estate Lands.
 of the
 City of Philadelphia. Formerly
 in
 Bumside Township Centre County -
 Pennsylvania -
 from Survey of Jos. F. May - A. 1859.
 Potomac Co.
 April 3. 1867 -
 Heber B. Thompson
 Engineer General Atlas