


B.M.
Spike in side of 12" Elm.
34' Rt. of Sta. 242+56-(Survey E).
Elev. 1279.315

Constr. P.I. 243+53.72
Angle = 196° 15'

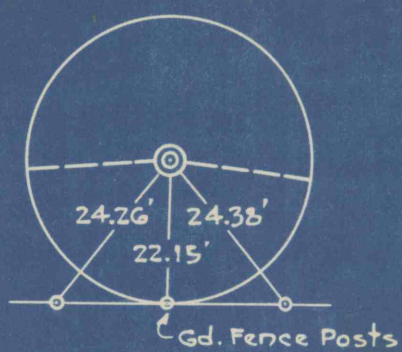

Survey P.I. 243+49.04
Angle = 191° 53'

