



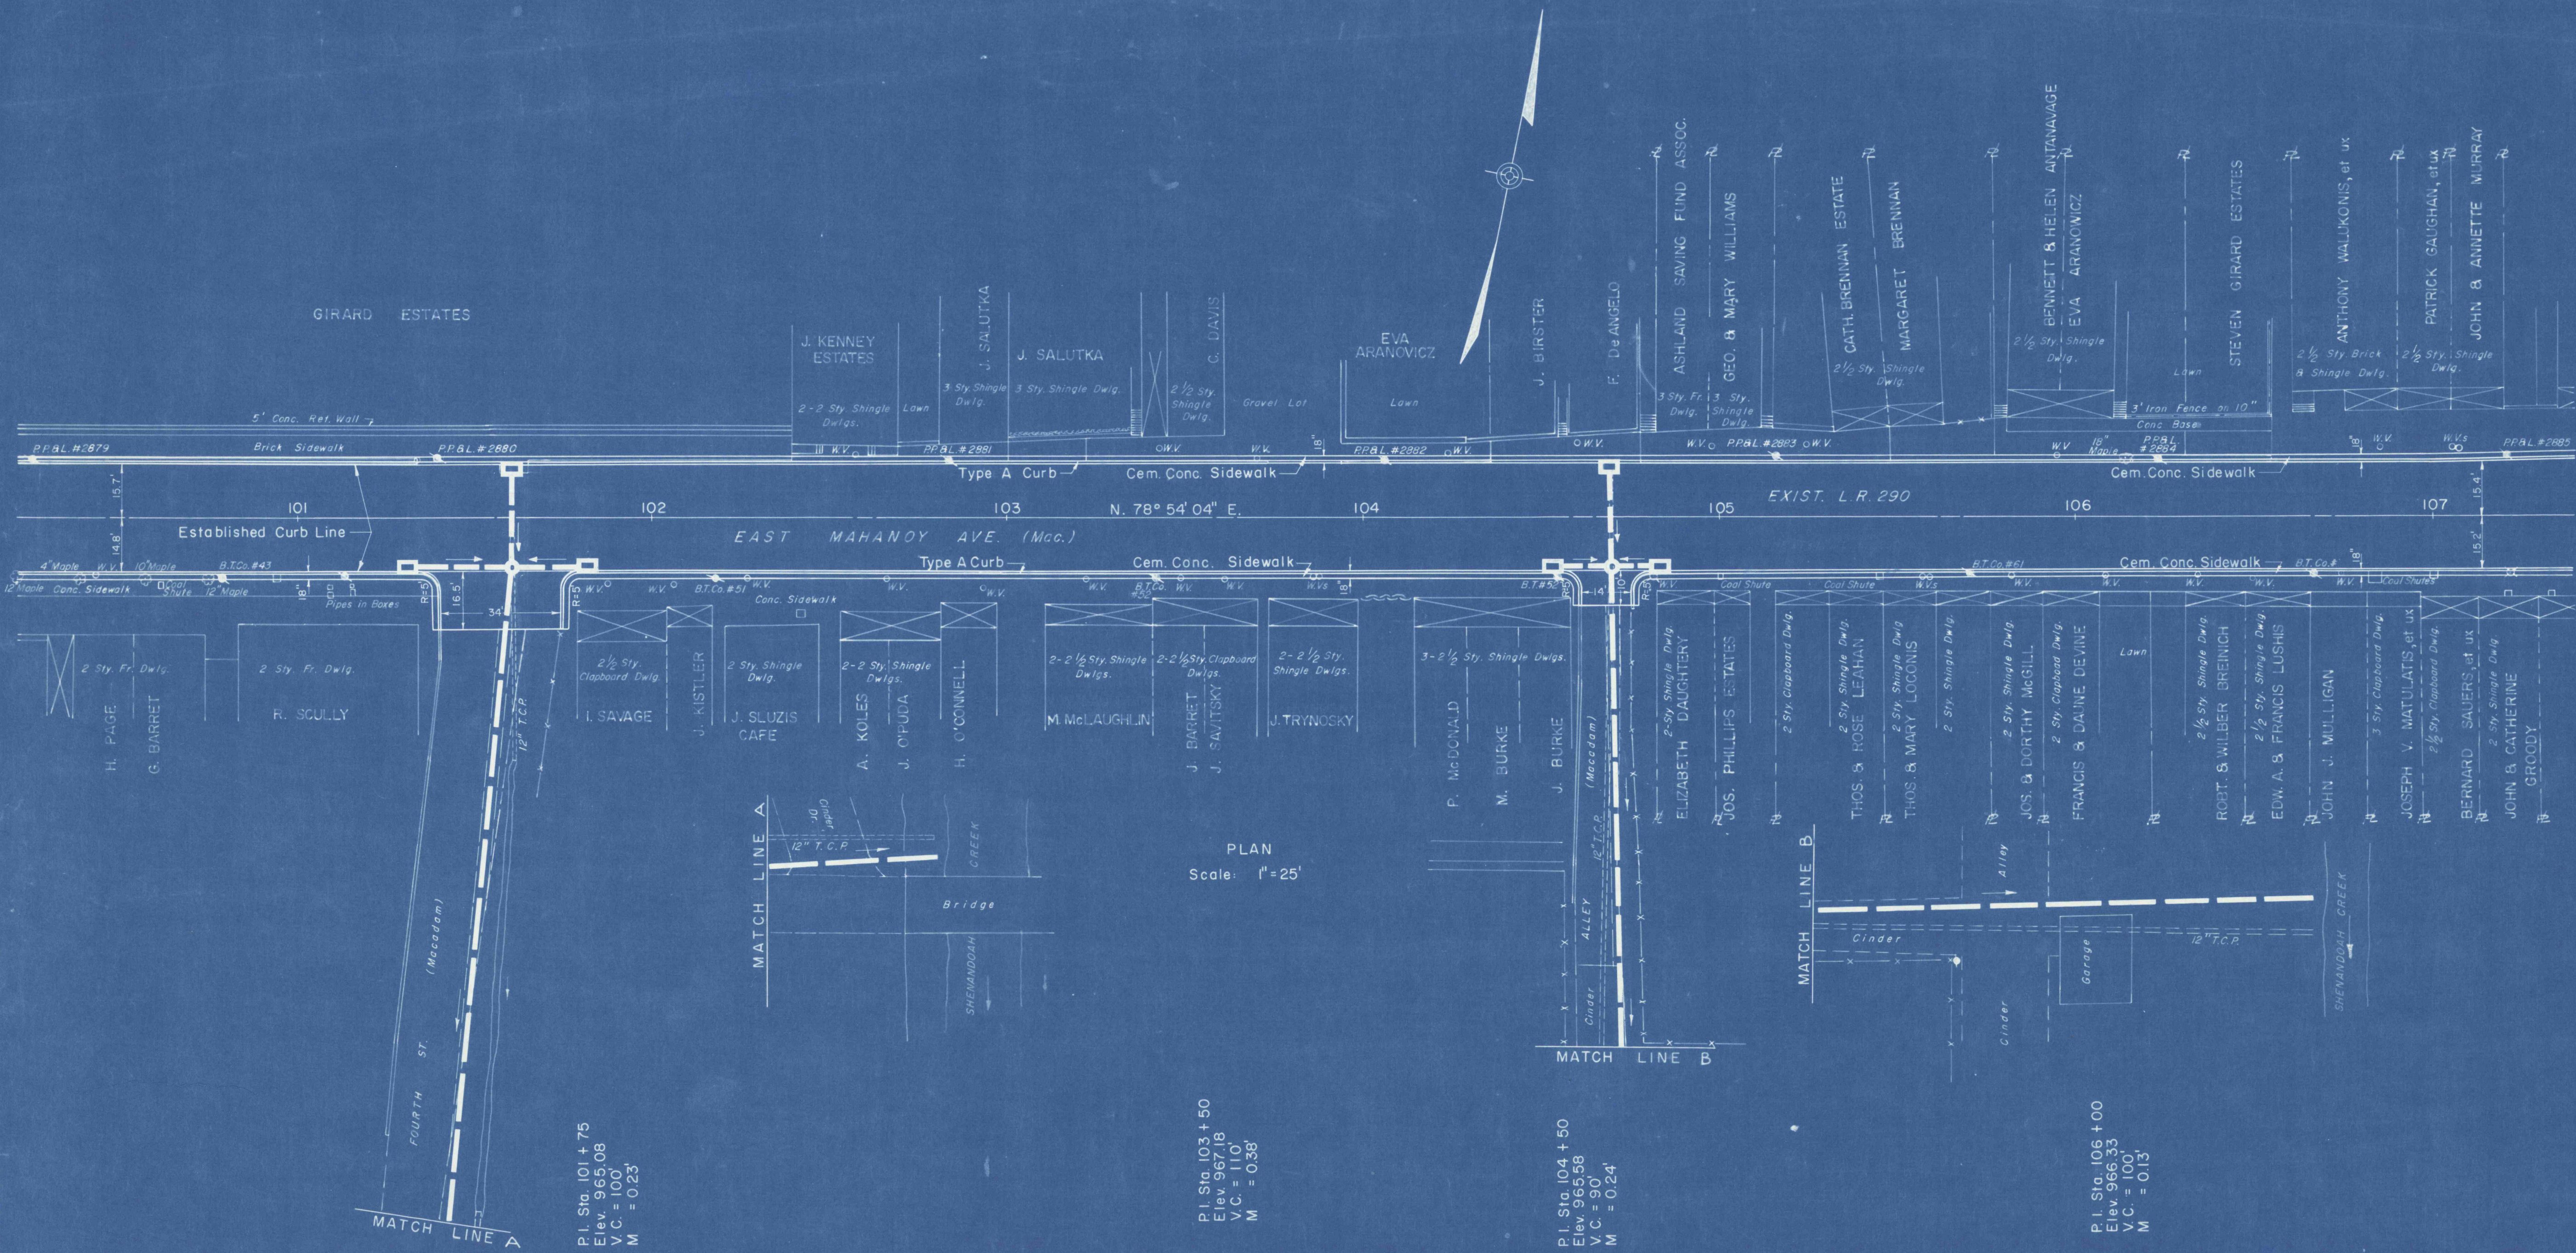

PLAN  
Scale: 1"=25'

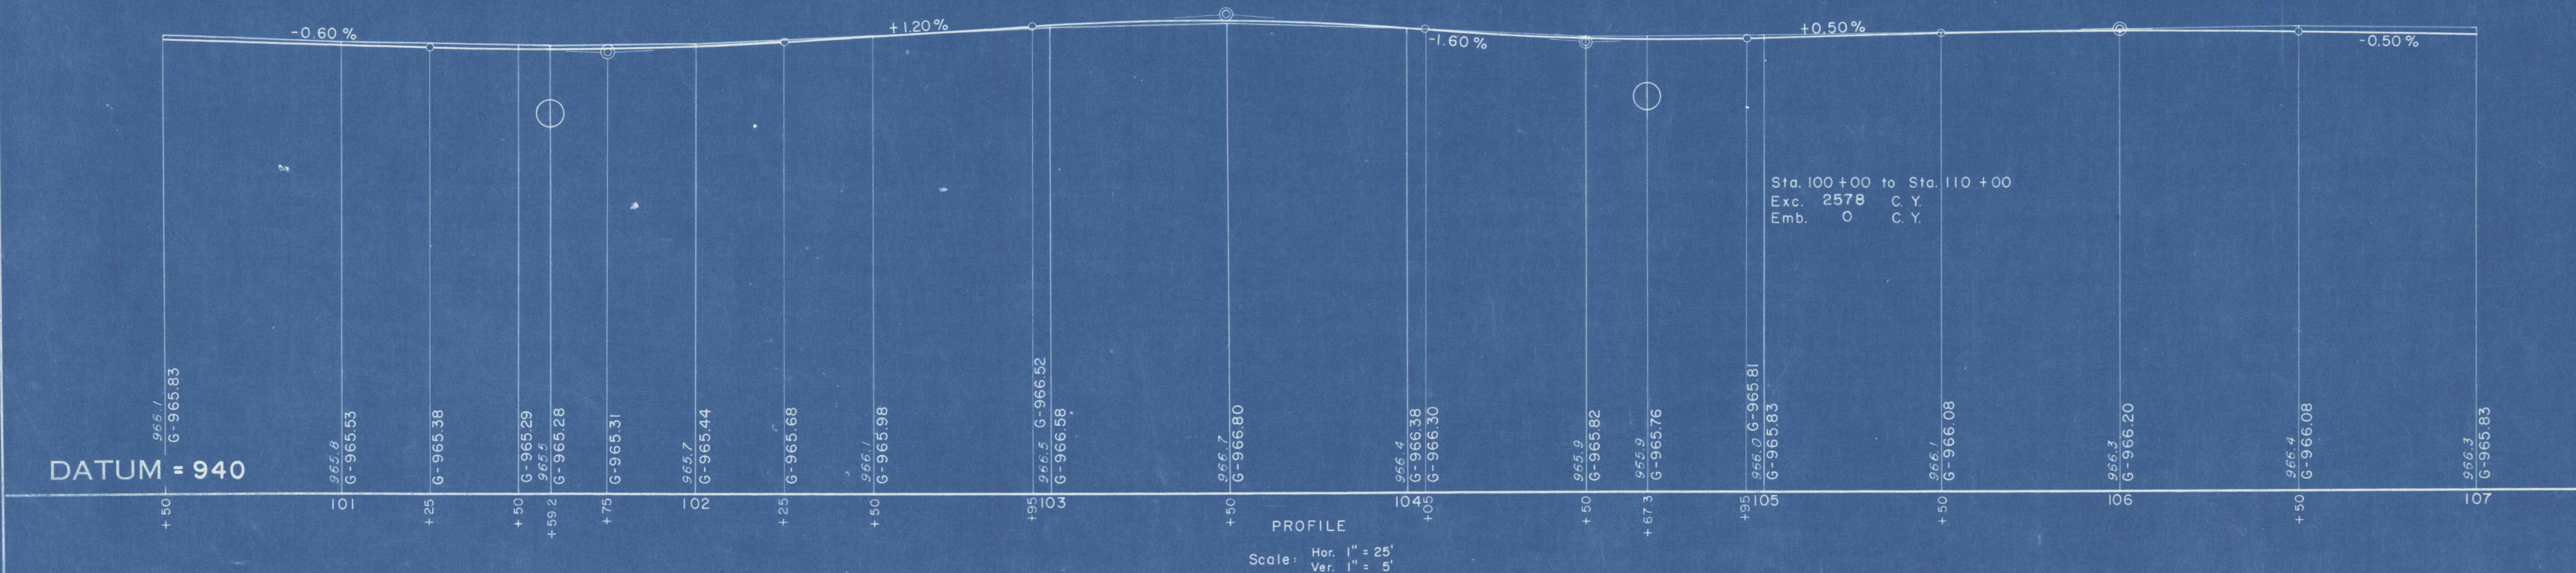

Sta. 100+00 to Sta. 110+00  
Exc. 2578 C.Y.  
Emb. 0 C.Y.

PROFILE  
Scale: Hor. 1"=25'  
Ver. 1"=5'

| DISTRICT                          | COUNTY   | ROUTE | SEC. | SHEET   |
|-----------------------------------|---|-------|------|---------|
| 5-0                               | SCHUYLKILL   | 290   | 19   | 8 of 33 |
| GIRARDVILLE BORO                  |   |       |      |         |
| FINAL<br>QUANTITIES               | REQUIRED LIST   |       |      |         |
|                                   | Sta. 101 + 31 , Rt.<br>1 Type 4' Special Inlet   |       |      |         |
|                                   | Sta. 101 + 33 to Sta. 101 + 80, Rt.<br>42 L.F. 18" A.C.C.M. Pipe Fully Coated<br>9 C.Y. Cl. 2 Exc. (Pipe)   |       |      |         |
|                                   | Sta. 101 + 59<br>26 L.F. 18" A.C.C.M. Pipe Fully Coated<br>1 Type 4' Special Inlet, Lt.<br>1 Type A Manhole, Rt.<br>6 C.Y. Cl. 2 Exc. (Pipe)<br>(Includes Removal of Exist. Pipe)   |       |      |         |
|                                   | Sta. 101 + 82 , Rt.<br>1 Type 4' Special Inlet   |       |      |         |
|                                   | Sta. 104 + 53 , Rt.<br>1 Type 4' Special Inlet   |       |      |         |
|                                   | Sta. 104 + 55 to Sta. 104 + 81, Rt.<br>22 L.F. 18" A.C.C.M. Pipe Fully Coated<br>4 C.Y. Cl. 2 Exc. (Pipe)   |       |      |         |
|                                   | Sta. 104 + 67<br>26 L.F. 18" A.C.C.M. Pipe Fully Coated<br>1 Type 4' Special Inlet, Lt.<br>1 Type A Manhole, Rt.<br>6 C.Y. Cl. 2 Exc. (Pipe)   |       |      |         |
|                                   | Sta. 104 + 83, Rt.<br>1 Type 4' Special Inlet   |       |      |         |
|                                   | Sta. 101 + 59<br>Fourth St. Approach , Rt.<br>64 S.Y. Bit. Surf. Crse. ID - 2 , 2 1/2" Depth<br>64 S.Y. Cr. Aggr. Base Crse. , Type AP, 12" Depth<br>64 S.Y. Subgrade<br>28 C.Y. Cl. 1 Exc.   |       |      |         |
|                                   | Sta. 101 + 59, Rt.<br>234 L.F. 18" A.C.C.M. Pipe Fully Coated<br>0.1 C.Y. Cl. B Conc. (Plug Exist Pipe)<br>108 C.Y. Cl. 2 Exc. (Pipe)<br>41 S.Y. Bit. Surf. Crse. ID - 2 (2 1/2" Depth)<br>41 S.Y. Cr. Aggr. Base Crse. , Type B , 8" Depth<br>41 S.Y. Subgrade<br>(For Detail Exist. Pavt. Replacement,<br>See Sheet No. 5)                                           |       |      |         |
|                                   | Sta. 101 + 73 to Sta. 104 + 61, Rt.<br>294 L.F. Pl. Cem. Conc. Curb, Type A<br>28 S.Y. Cem. Conc. S-walk (10" Width)<br>7 C.Y. Cl. 1 Exc.   |       |      |         |
|                                   | Sta. 104 + 67<br>Alley Approach, Rt.<br>17 S.Y. Bit. Surf. Crse. ID - 2 , 2 1/2" Depth<br>17 S.Y. Cr. Aggr. Base Crse. , Type AP, 12" Depth<br>17 S.Y. Subgrade<br>7 C.Y. Cl. 1 Exc.   |       |      |         |
|                                   | Sta. 104 + 67, Rt.<br>274 L.F. 18" A.C.C.M. Pipe Fully Coated<br>0.1 C.Y. Cl. B Conc. (Plug Exist. Pipe)<br>129 C.Y. Cl. 2 Exc. (Pipe)<br>36 S.Y. Bit. Surf. Crse. ID - 2 (2 1/2" Depth)<br>36 S.Y. Cr. Aggr. Base Crse. , Type B , 8" Depth<br>36 S.Y. Subgrade<br>4 C.Y. Sel. Mat'l. Surfgr. (4" Depth)<br>(For Detail Exist. Pavt. Replacement,<br>See Sheet No. 5) |       |      |         |
|                                   | Sta. 104 + 74 to Sta. 108 + 42, Rt.<br>376 L.F. Pl. Cem. Conc. Curb, Type A<br>35 S.Y. Cem. Conc. S-walk (10" Width)<br>8 C.Y. Cl. 1 Exc.   |       |      |         |
|                                   |   |       |      |         |
|                                   | Alignment Book No. 14461   |       |      |         |
| Topography Book No. 14464 , 14475 |   |       |      |         |
| Profile Book No. 14468 , 14475    |   |       |      |         |
| TRACED BY _____                   |   |       |      |         |
| FINAL BY _____                    |   |       |      |         |