FORM NO. 4228

DISTRICT	COUNTY	ROUTE	SEC.	SHEET
5-0	SCHUYLKILL	290	19	12 of 33
BUTLER TWP.				

FINAL QUANTITIES

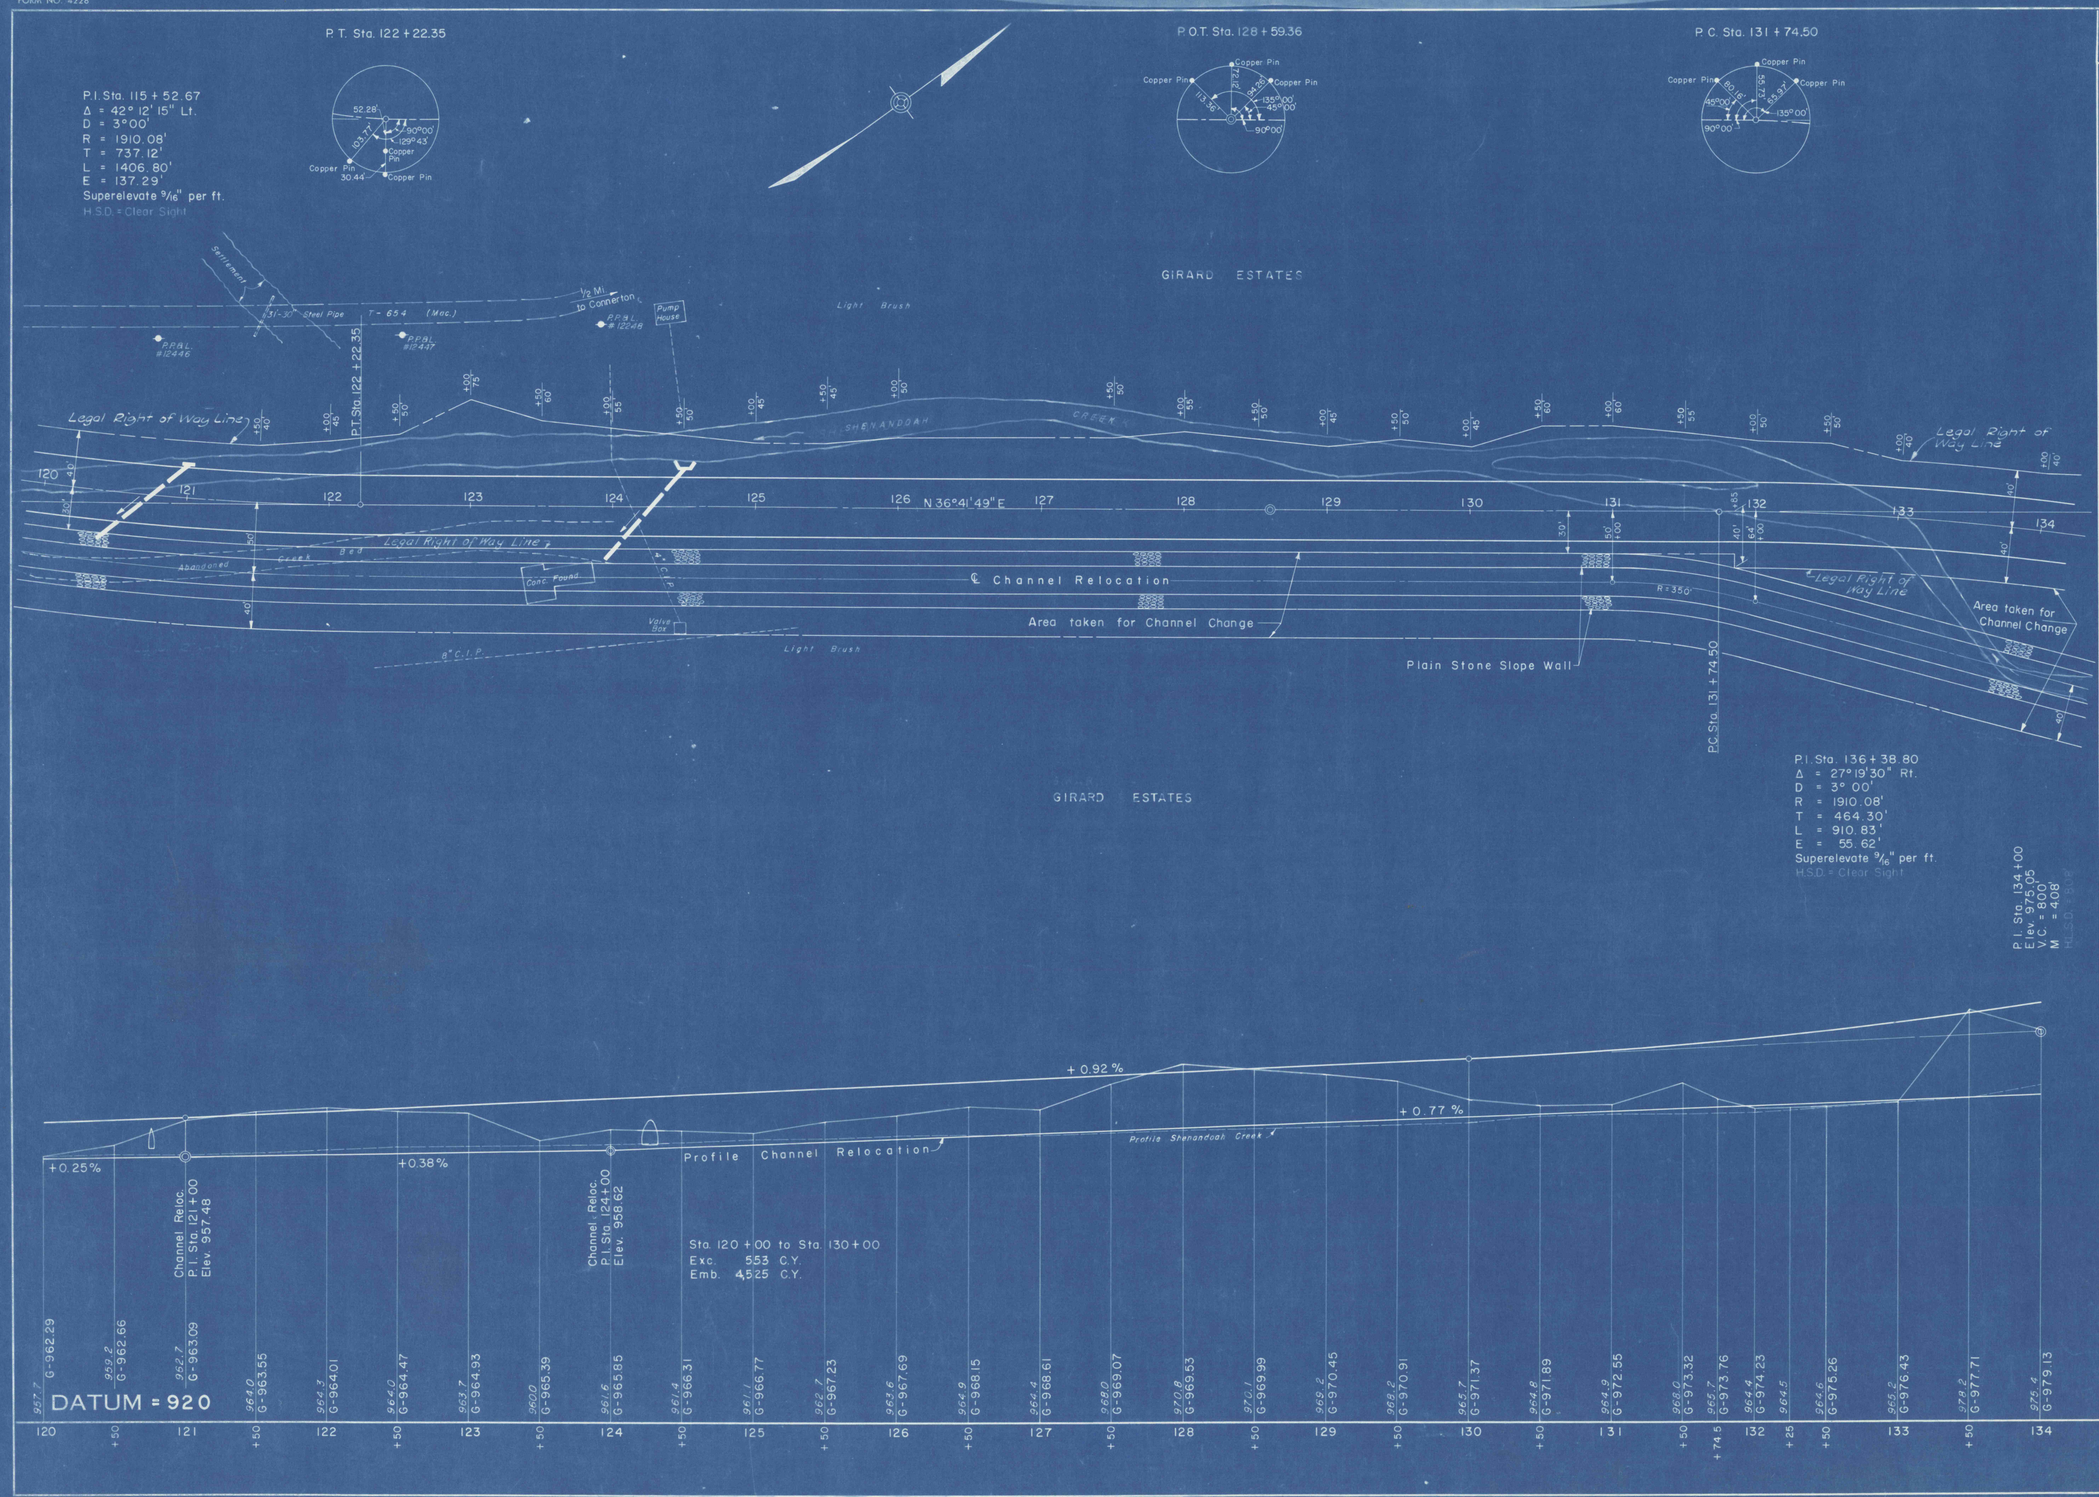

REQUIRED LIST

Sta. 120 + 74
84 L.F. 29" x 18" A.C.C.M. Pipe Arch
0.7 C.Y. Cl. B Conc. (Type D Edw., Lt.)
41 C.Y. Cl. 2 Exc. (Pipe & Edw.)

Sta. 123 + 50 to Sta. 128 + 50
Unsuitable Material
6794 C.Y. Cl. 1 Exc.
6622 C.Y. Emb. Backfill
(For Details See X-Sections)

Sta. 124 + 28
86 L.F. 65" x 40" A.C.C.M. Pipe Arch
3.7 C.Y. Cl. B Conc. (Type D W. Edw., Lt.)
146 C.Y. Cl. 2 Exc. (Pipe & Edw.)

Sta. 127 + 50 to Sta. 136 + 00
Pocket Fill, Lt.
69 C.Y. Emb.
(For Details See X-Sections)

Sta. 128 + 00 to Sta. 132 + 00
4' Overexc.
904 C.Y. Cl. 1 Exc.
904 C.Y. Emb. Backfill
(For Details See X-Sections)

Sta. 129 + 40 to Sta. 131 + 58
Widened Cut for Drainage, Rt.
23 C.Y. Cl. 1 Exc.

Sta. 130 + 00 to Sta. 133 + 25
Unsuitable Material
526 C.Y. Cl. 1 Exc.
526 C.Y. Emb. Backfill
(For Details See X-Sections)

Sta. 131 + 60 to Sta. 133 + 40
Pocket Fill, Rt.
124 C.Y. Emb.

Sta. 133 + 25 to Sta. 134 + 50
4' Overexc.
172 C.Y. Cl. 1 Exc.
172 C.Y. Emb. Backfill
(For Details See X-Sections)

Sta. 133 + 40 to Sta. 133 + 60
Widened Cut for Drainage, Rt.
4 C.Y. Cl. 1 Exc.

Sta. 133 + 50 to Sta. 136 + 50
Unsuitable Material
591 C.Y. Cl. 1 Exc.
591 C.Y. Emb. Backfill
(For Details See X-Sections)

Alignment	Book No.	14461
Topography	Book No.	14464, 14465
Profile	Book No.	14469

TRACED BY
FINAL BY