


DISTRICT	COUNTY	ROUTE	SEC.	SHEET
5-0	SCHUYLKILL	290	19	17 of 33
WEST MAHANoy TWP.				

FINAL
QUANTITIES

REQUIRED LIST

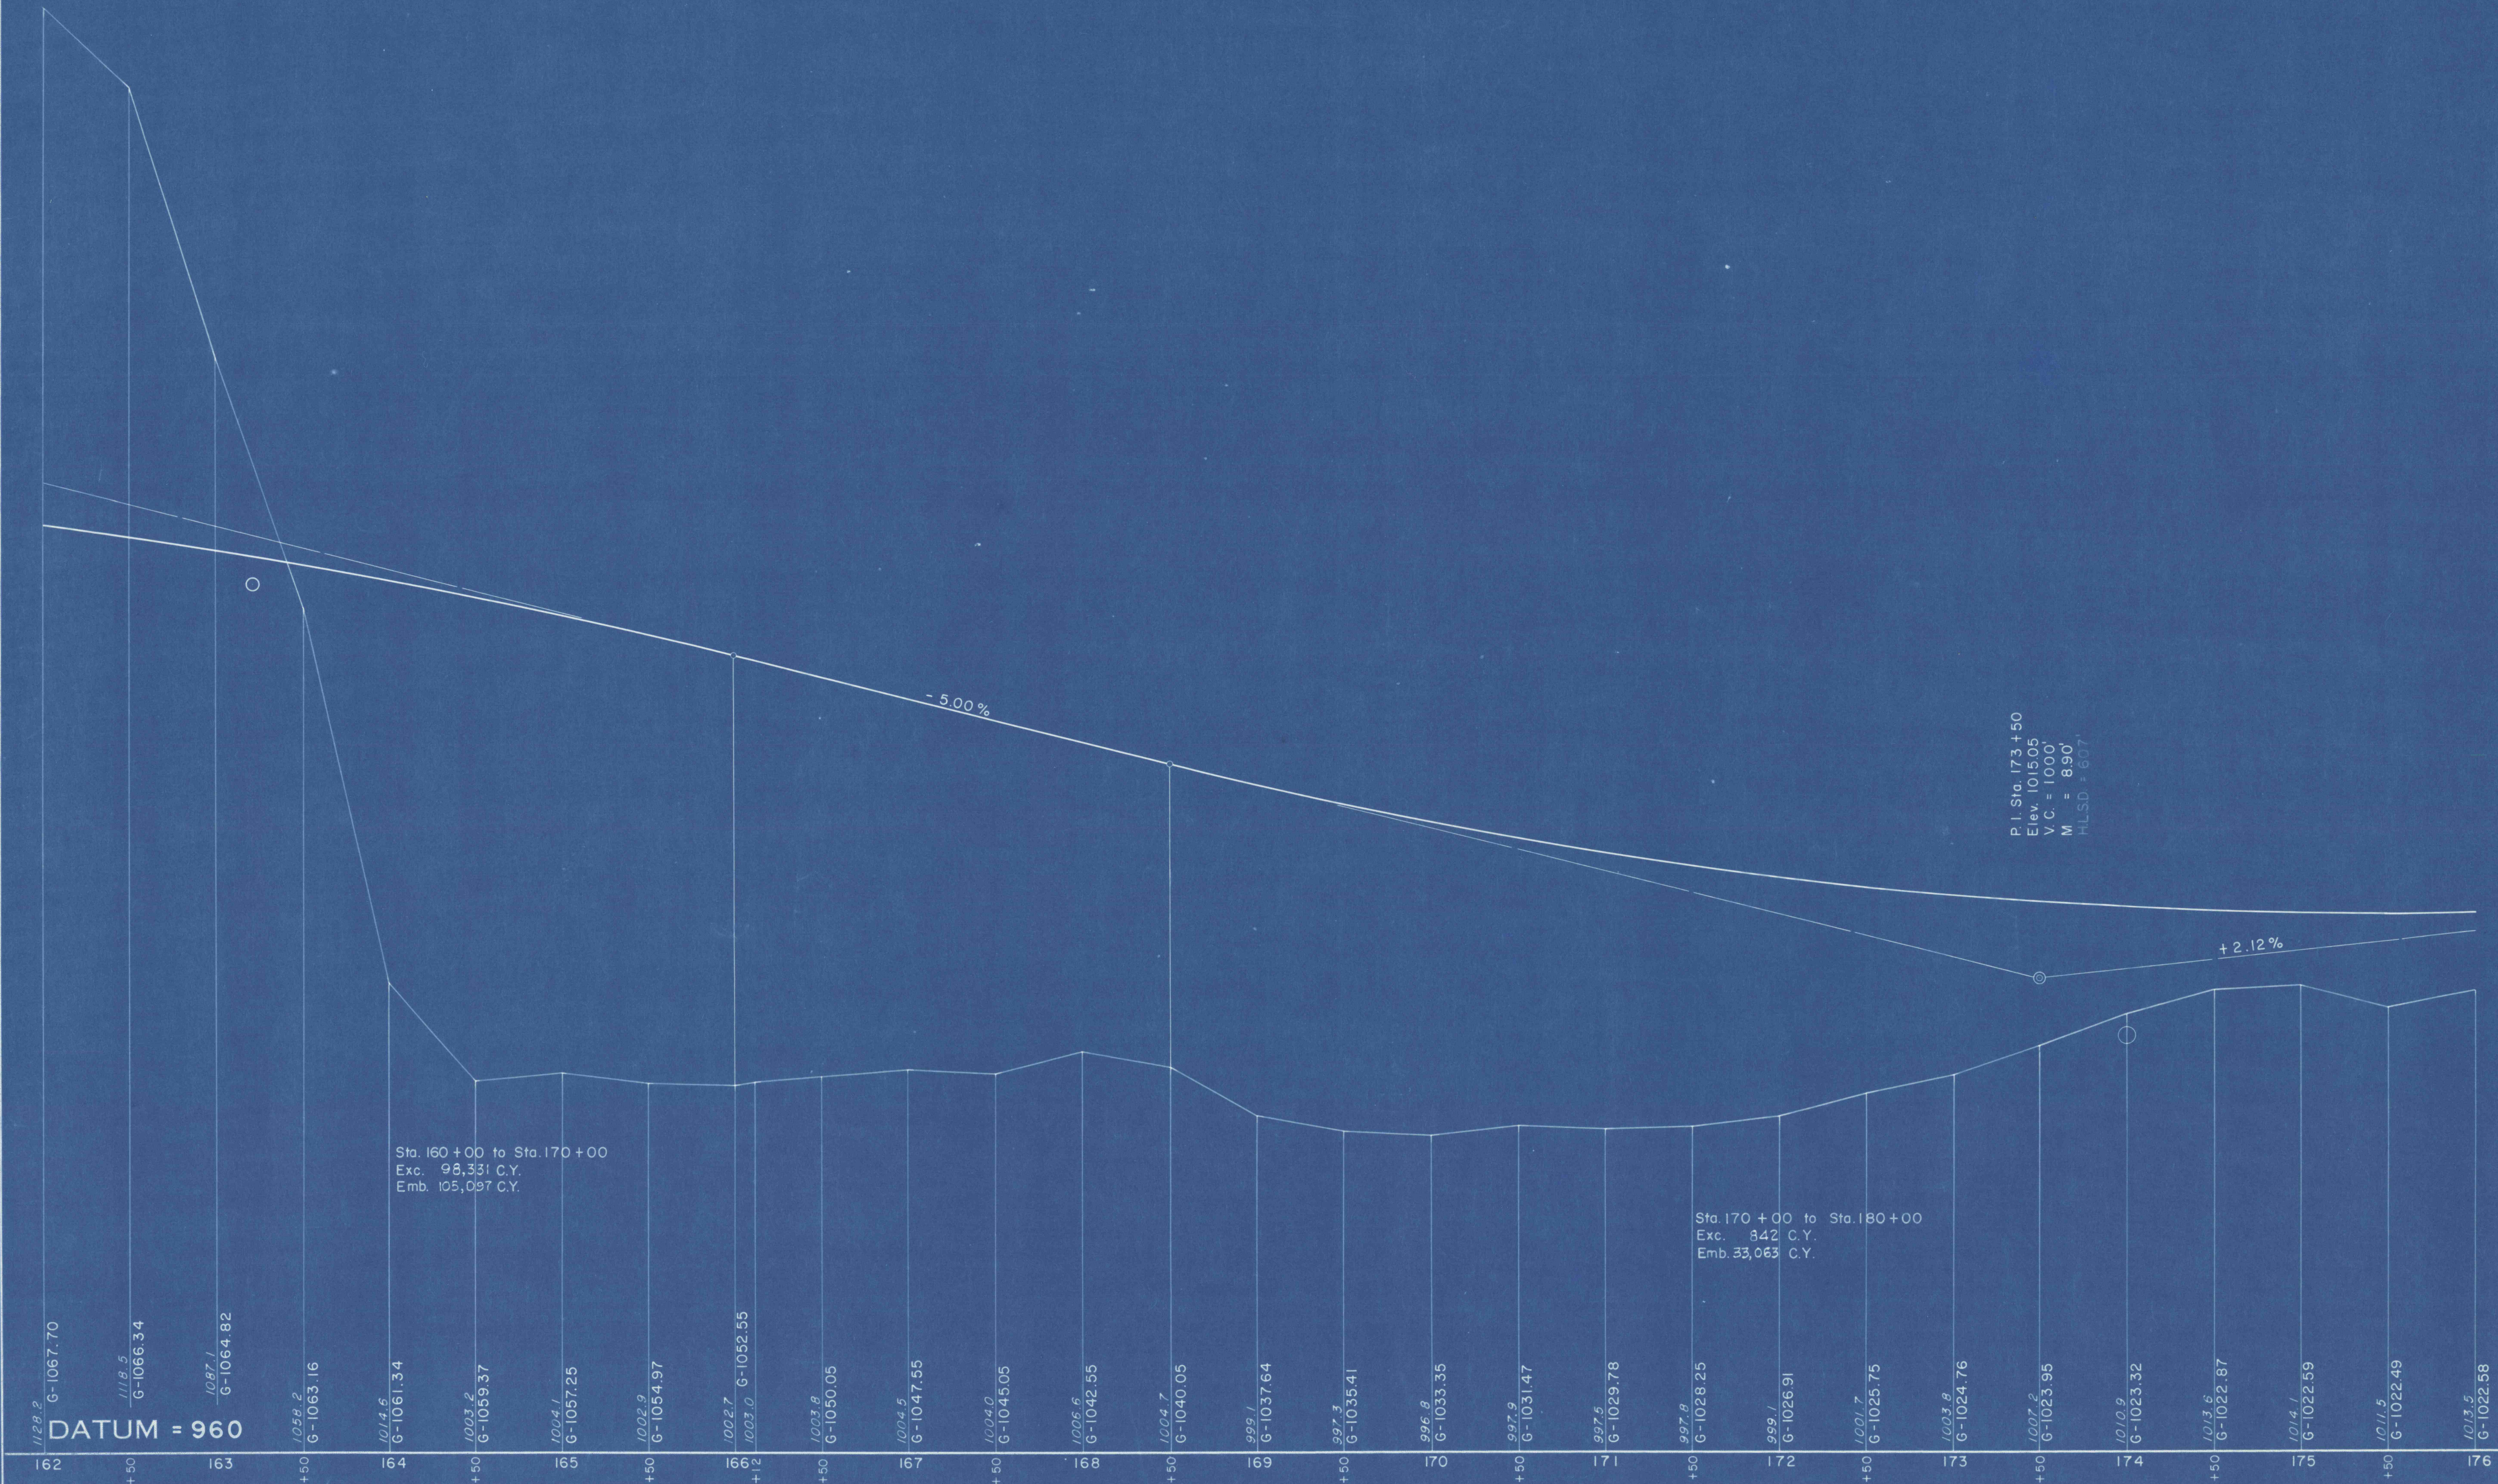

Profile Book No. 14469, 14470

TRACED BY
FINAL BY