FORM NO. 4228

DISTRICT	COUNTY	ROUTE	SEC.	SHEET
5-0	SCHUYLKILL	290	19	18 of 33

WEST MAHANOY TWP.

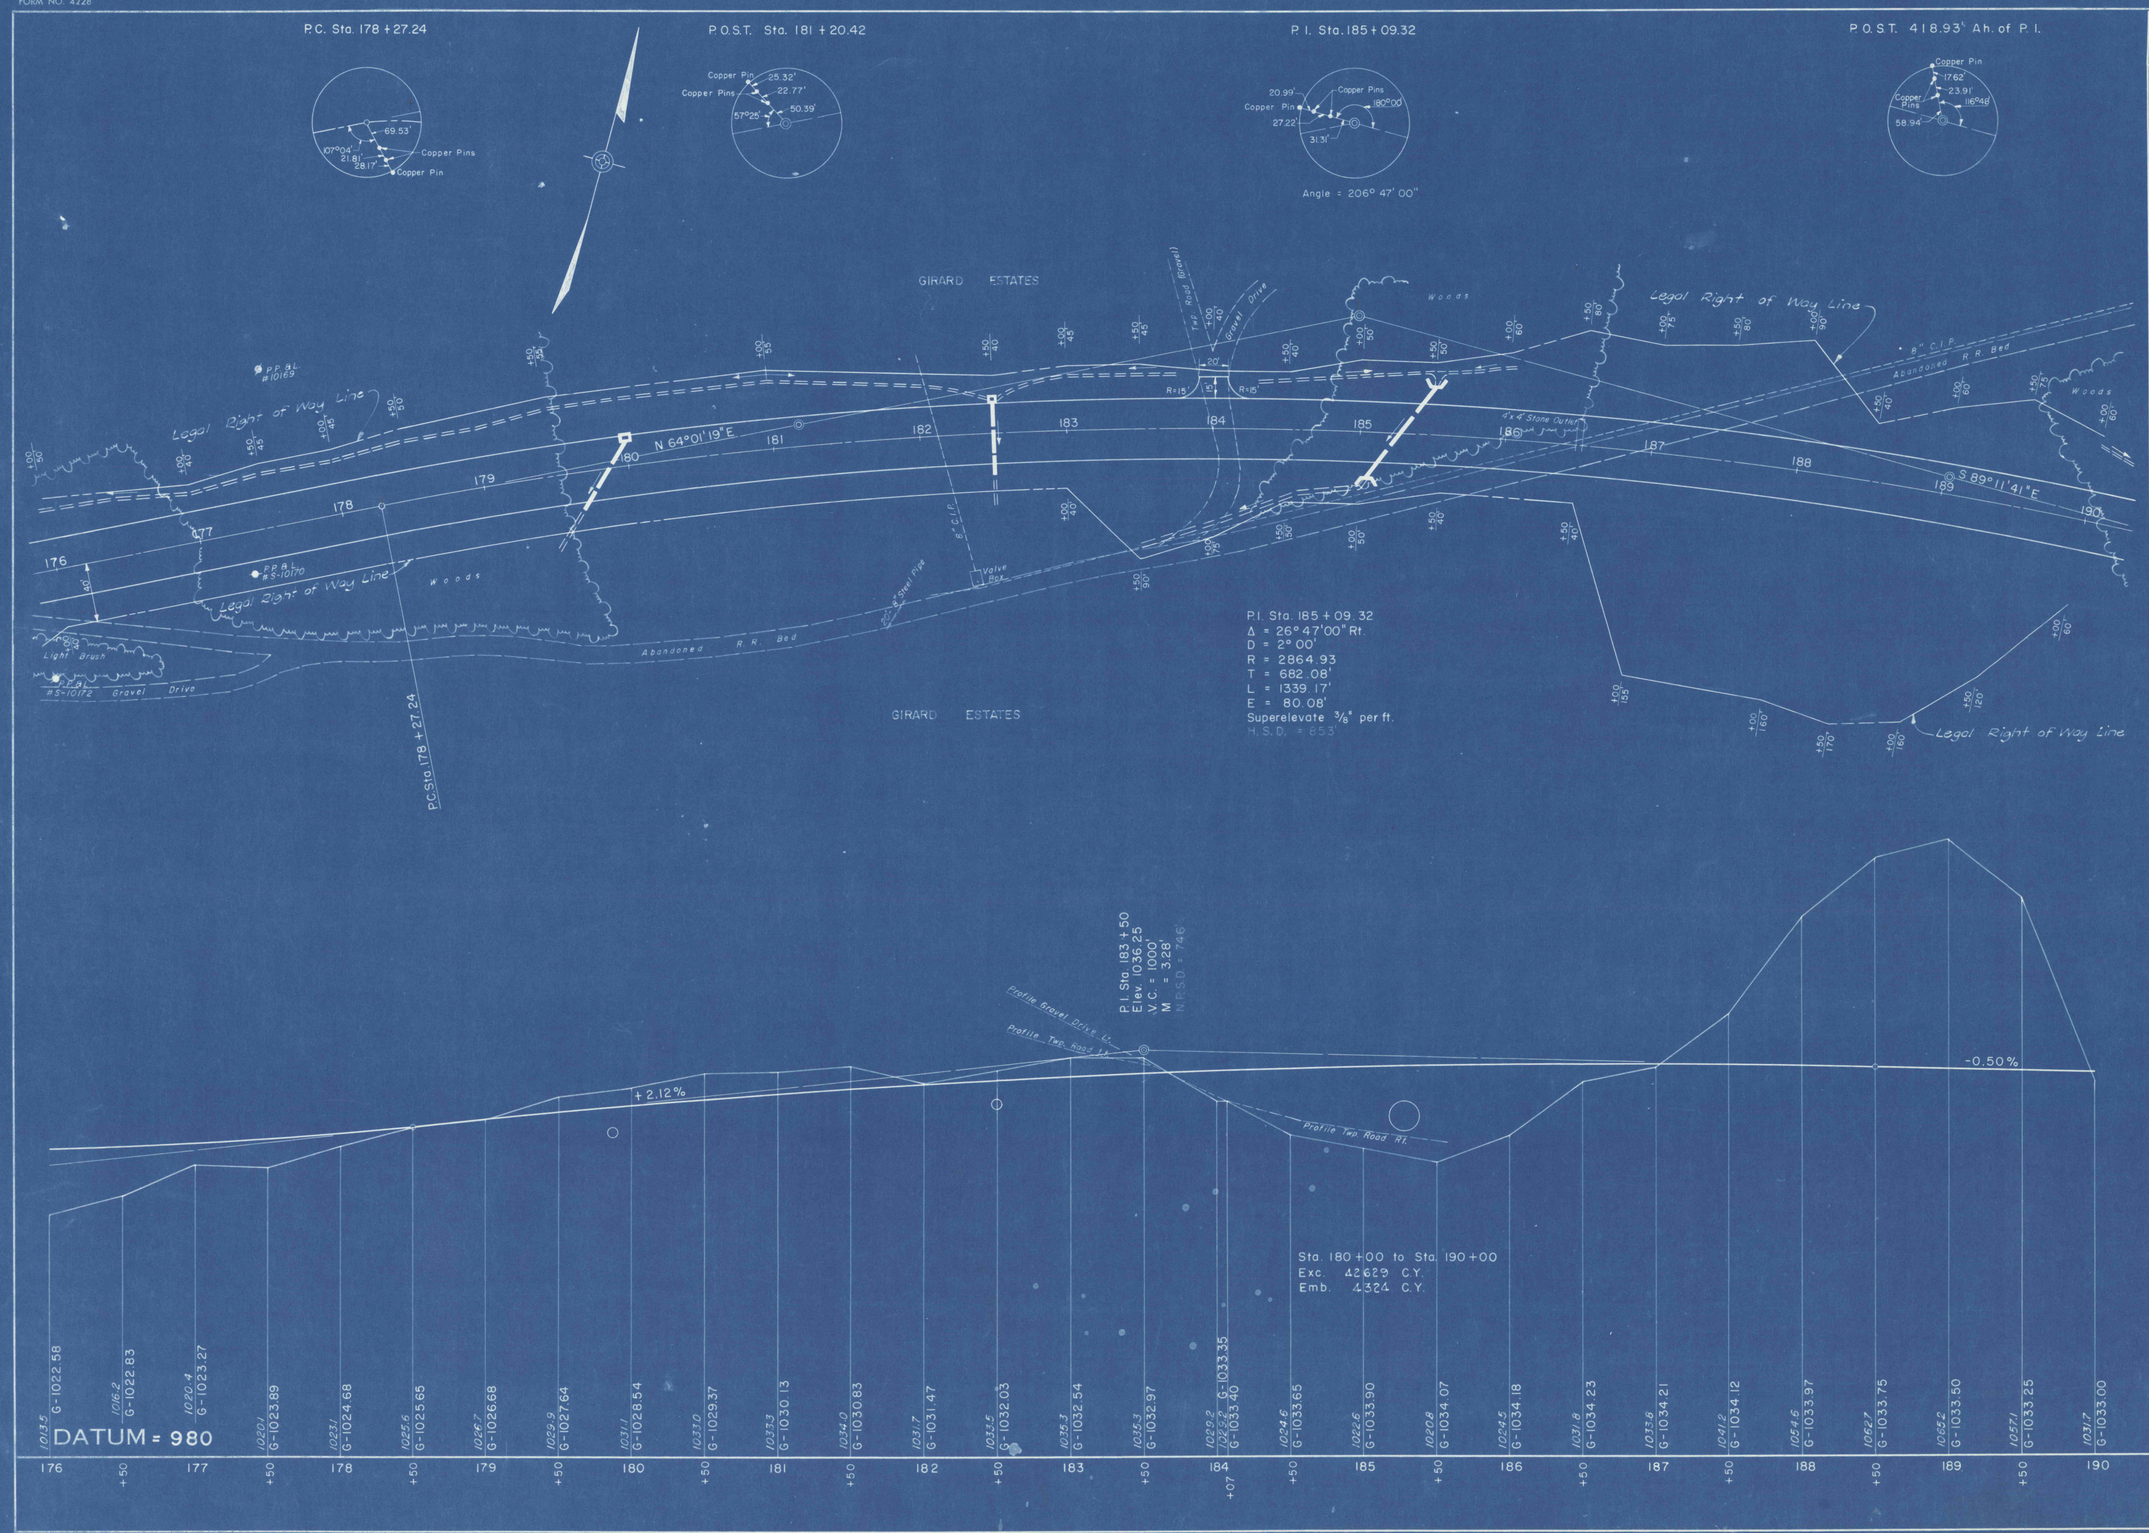

FINAL QUANTITIES

REQUIRED LIST

Sta. 176 + 50 to Sta. 184 + 30
4' Overexc.
3255 C.Y. Cl. 1 Exc.
3255 C.Y. Emb. Backfill
(For Details See X-Sections)

Sta. 179 + 87
58 L.F. 18" A.C.C.M. Pipe Fully Coated
1 Type H Inlet, Lt.
19 C.Y. Cl. 2 Exc. (Pipe)
35 C.Y. Cl. 2 Exc. (Outlet Ditch)

Sta. 182 + 50
48 L.F. 18" A.C.C.M. Pipe Fully Coated
2.2 C.Y. Cl. B Conc. (Type A Edw., Lt.)
17 C.Y. Cl. 2 Exc. (Pipe & Edw.)
30 C.Y. Cl. 2 Exc. (Outlet Ditch)

Sta. 183 + 50 to Sta. 185 + 05
Parallel Ditch, Rt. (4' Bottom)
43 C.Y. Cl. 2 Exc.

Sta. 184 + 00
Twp. Rd. Lt. (Graded Width 24')
4 C.Y. Sel. Mat'l. Surf'g. (4" Depth)
8 C.Y. Emb.

Sta. 184 + 25 to Sta. 186 + 10
Parallel Ditch, Lt. (18" Bottom)
34 C.Y. Cl. 2 Exc.

Sta. 184 + 25 to Sta. 188 + 10
Pocket Fill, Lt.
237 C.Y. Emb.

Sta. 184 + 25 to Sta. 185 + 60
Pocket Fill, Rt.
16 C.Y. Emb.

Sta. 185 + 28
80 L.F. 48" A.C.C.M. Pipe Fully Coated
6.2 C.Y. Cl. B Conc. (Type D-W Edws., Lt. & Rt.)
131 C.Y. Cl. 2 Exc. (Pipe & Edws.)

Sta. 185 + 90 to Sta. 188 + 00
4' Overexc.
659 C.Y. Cl. 1 Exc.
659 C.Y. Emb. Backfill
(For Details See X-Sections)

Sta. 187 + 20 to Sta. 188 + 20
Widened Cut for Drainage, Lt.
31 C.Y. Cl. 1 Exc.

Sta. 189 + 00 to Sta. 190 + 00
Pocket Fill, Lt.
22 C.Y. Emb.

Alignment Book No. 14461
Topography Book No. 14465, 14475
Profile Book No. 14470

TRACED BY
FINAL BY