FORM NO. 4228

DISTRICT	COUNTY	ROUTE	SEC.	SHEET
5-0	SCHUYLKILL	290	19	20 of 33

WEST MAHANOY TWP.

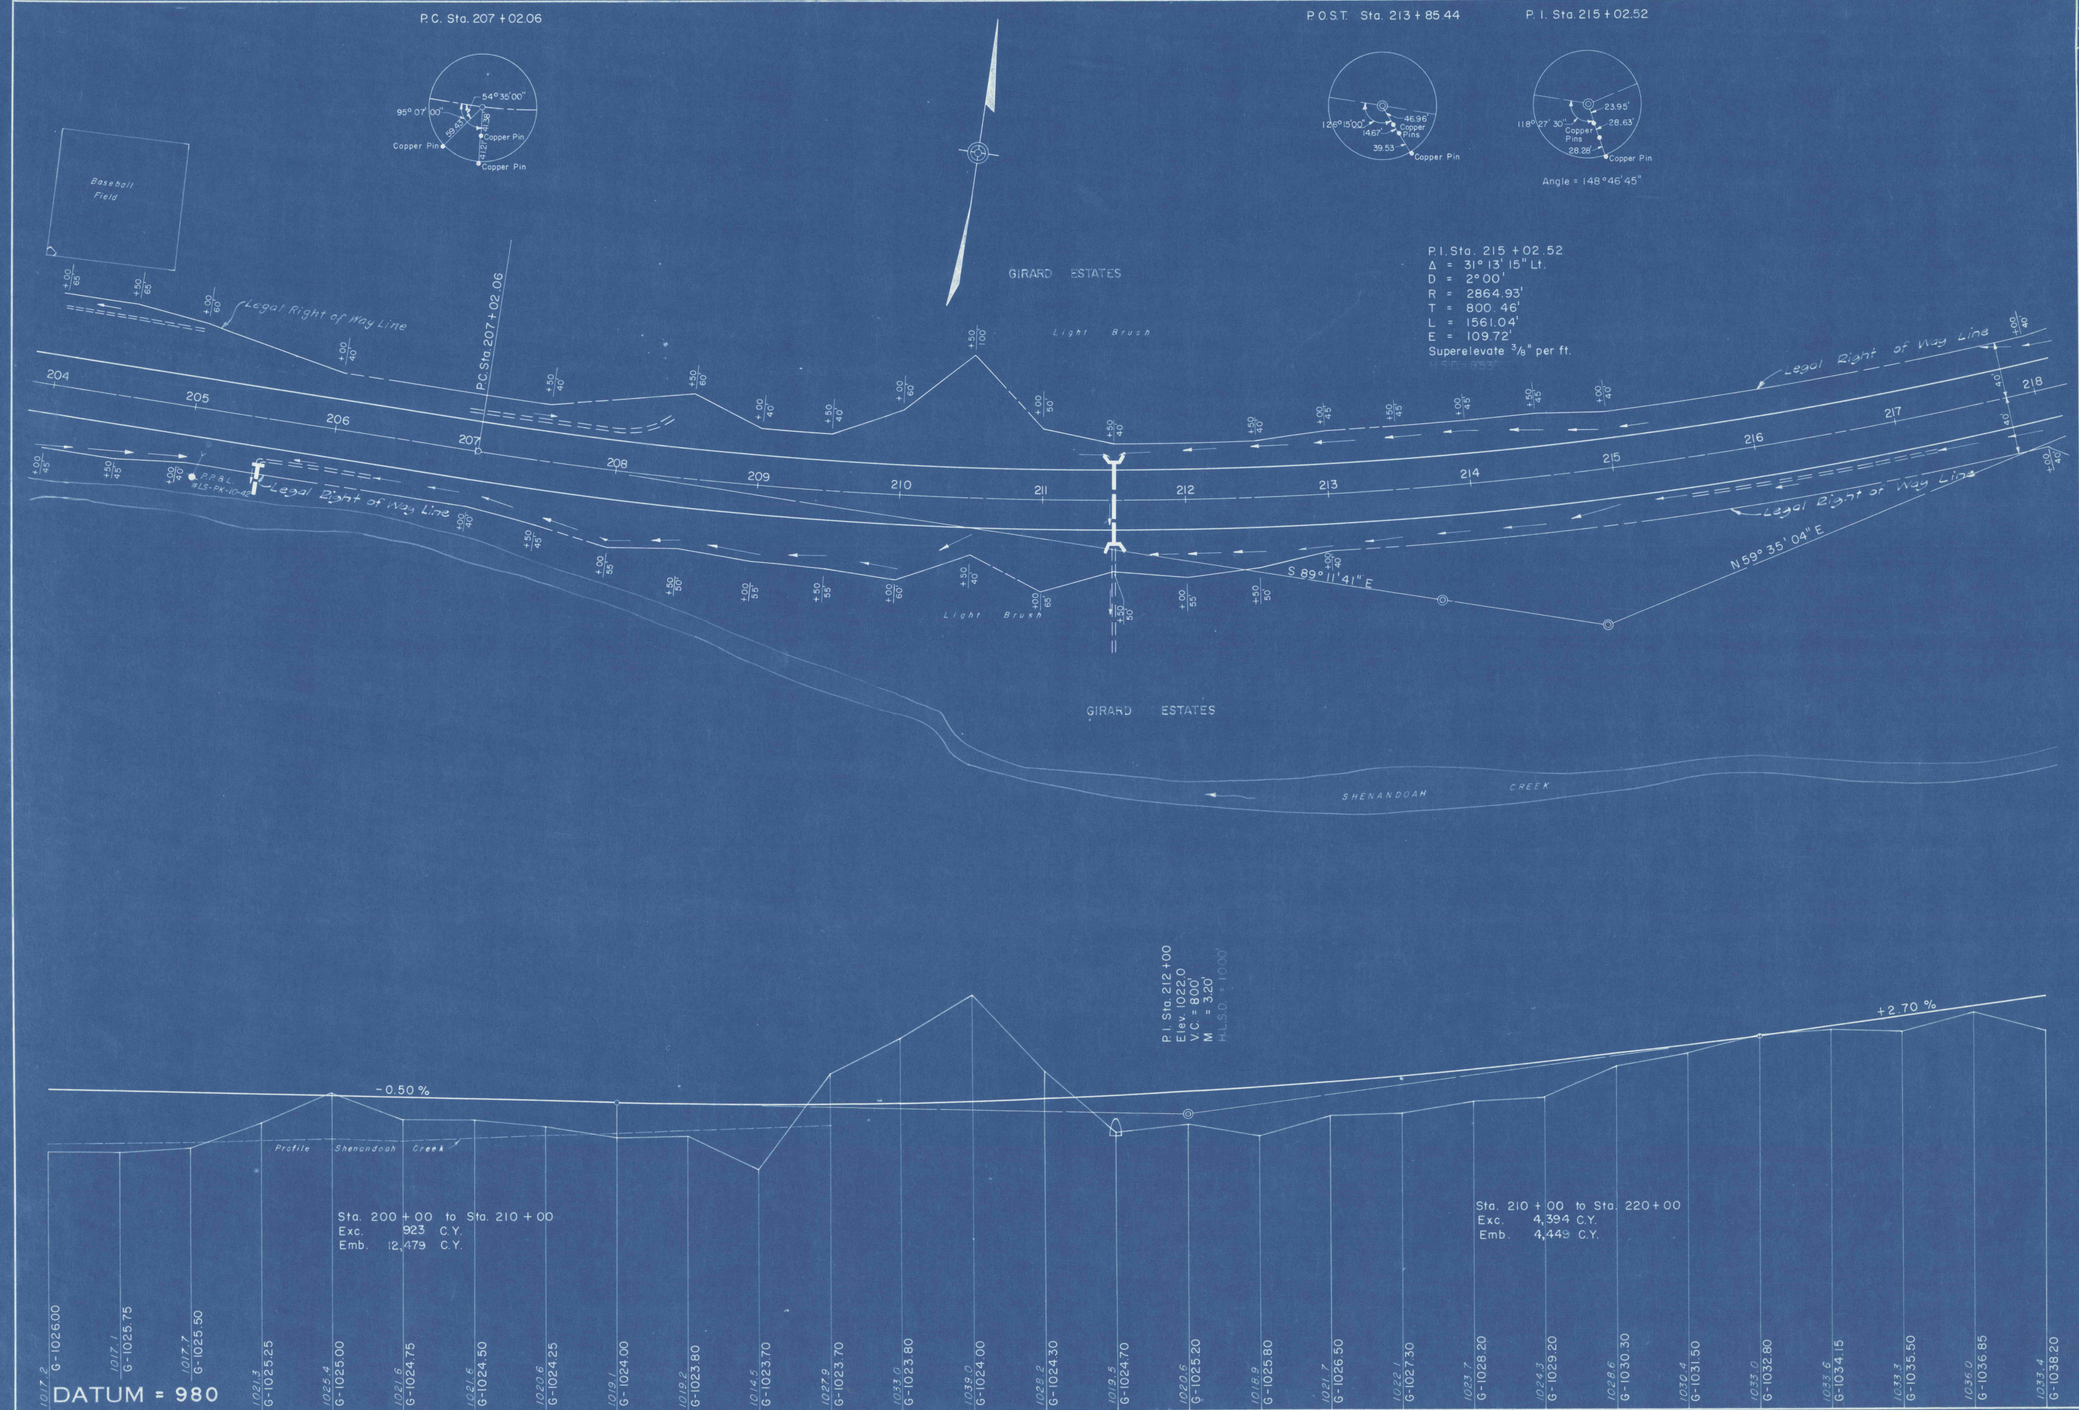

FINAL QUANTITIES

REQUIRED LIST

Sta. 205 + 50, Rt.
22 L.F. 18" A.C.C.M. Pipe Fully Coated
0.6 C.Y. Cl. B Conc. (Type D Edw.)
8 C.Y. Cl. 2 Exc. (Pipe & Edw.)

Sta. 205 +50 to Sta. 206 + 25, Rt.
9 C.Y. Cl. 2 Exc. (Parallel Ditch, 18" Bottom)
7 C.Y. Cl. 1 Exc. (Widened Cut)

Sta. 206 + 20 to Sta. 210 +50
Pocket Fill, Rt.
433 C.Y. Emb.

Sta. 206 + 90 to Sta. 208 + 40, Lt.
5 C.Y. Cl. 2 Exc. (Parallel Ditch, 18" Bottom)
86 C.Y. Cl. 1 Exc. (Widened Cut)

Sta. 208 + 20 to Sta. 209 + 00
Pocket Fill, Lt.
101 C.Y. Emb.

Sta. 210 + 75 to Sta. 226 + 50
Unsuitable Material
13,944 C.Y. Cl. 1 Exc.
1,941 C.Y. Emb., Backfill
(For Details, See X-Sections)

Sta. 211+50
56 L.F. 43"x 27" A.C.C.M. Pipe Arch
42 C.Y. Cl. B Conc. (Type DW Edws. Lt. & Rt.)
55 C.Y. Cl. 2 Exc. (Pipe & Edws.)
41 C.Y. Cl. 2 Exc. (Outlet Ditch)

Sta. 211 + 52 to Sta. 214 + 00
Pocket Fill, Rt.
22 C.Y. Emb.

Sta. 215 +60 to Sta. 217 + 20, Rt.
5 C.Y. Cl. 2 Exc. (Parallel Ditch, 18" Bottom)
36 C.Y. Cl. 1 Exc. (Widened Cut)

Sta. 217 + 60 to Sta. 219 +20
Pocket Fill, Rt.
181 C.Y. Emb.

Alignment	Book No.	14461
Topography	Book No.	14465
Profile	Book No.	14470

TRACED BY
FINAL BY