


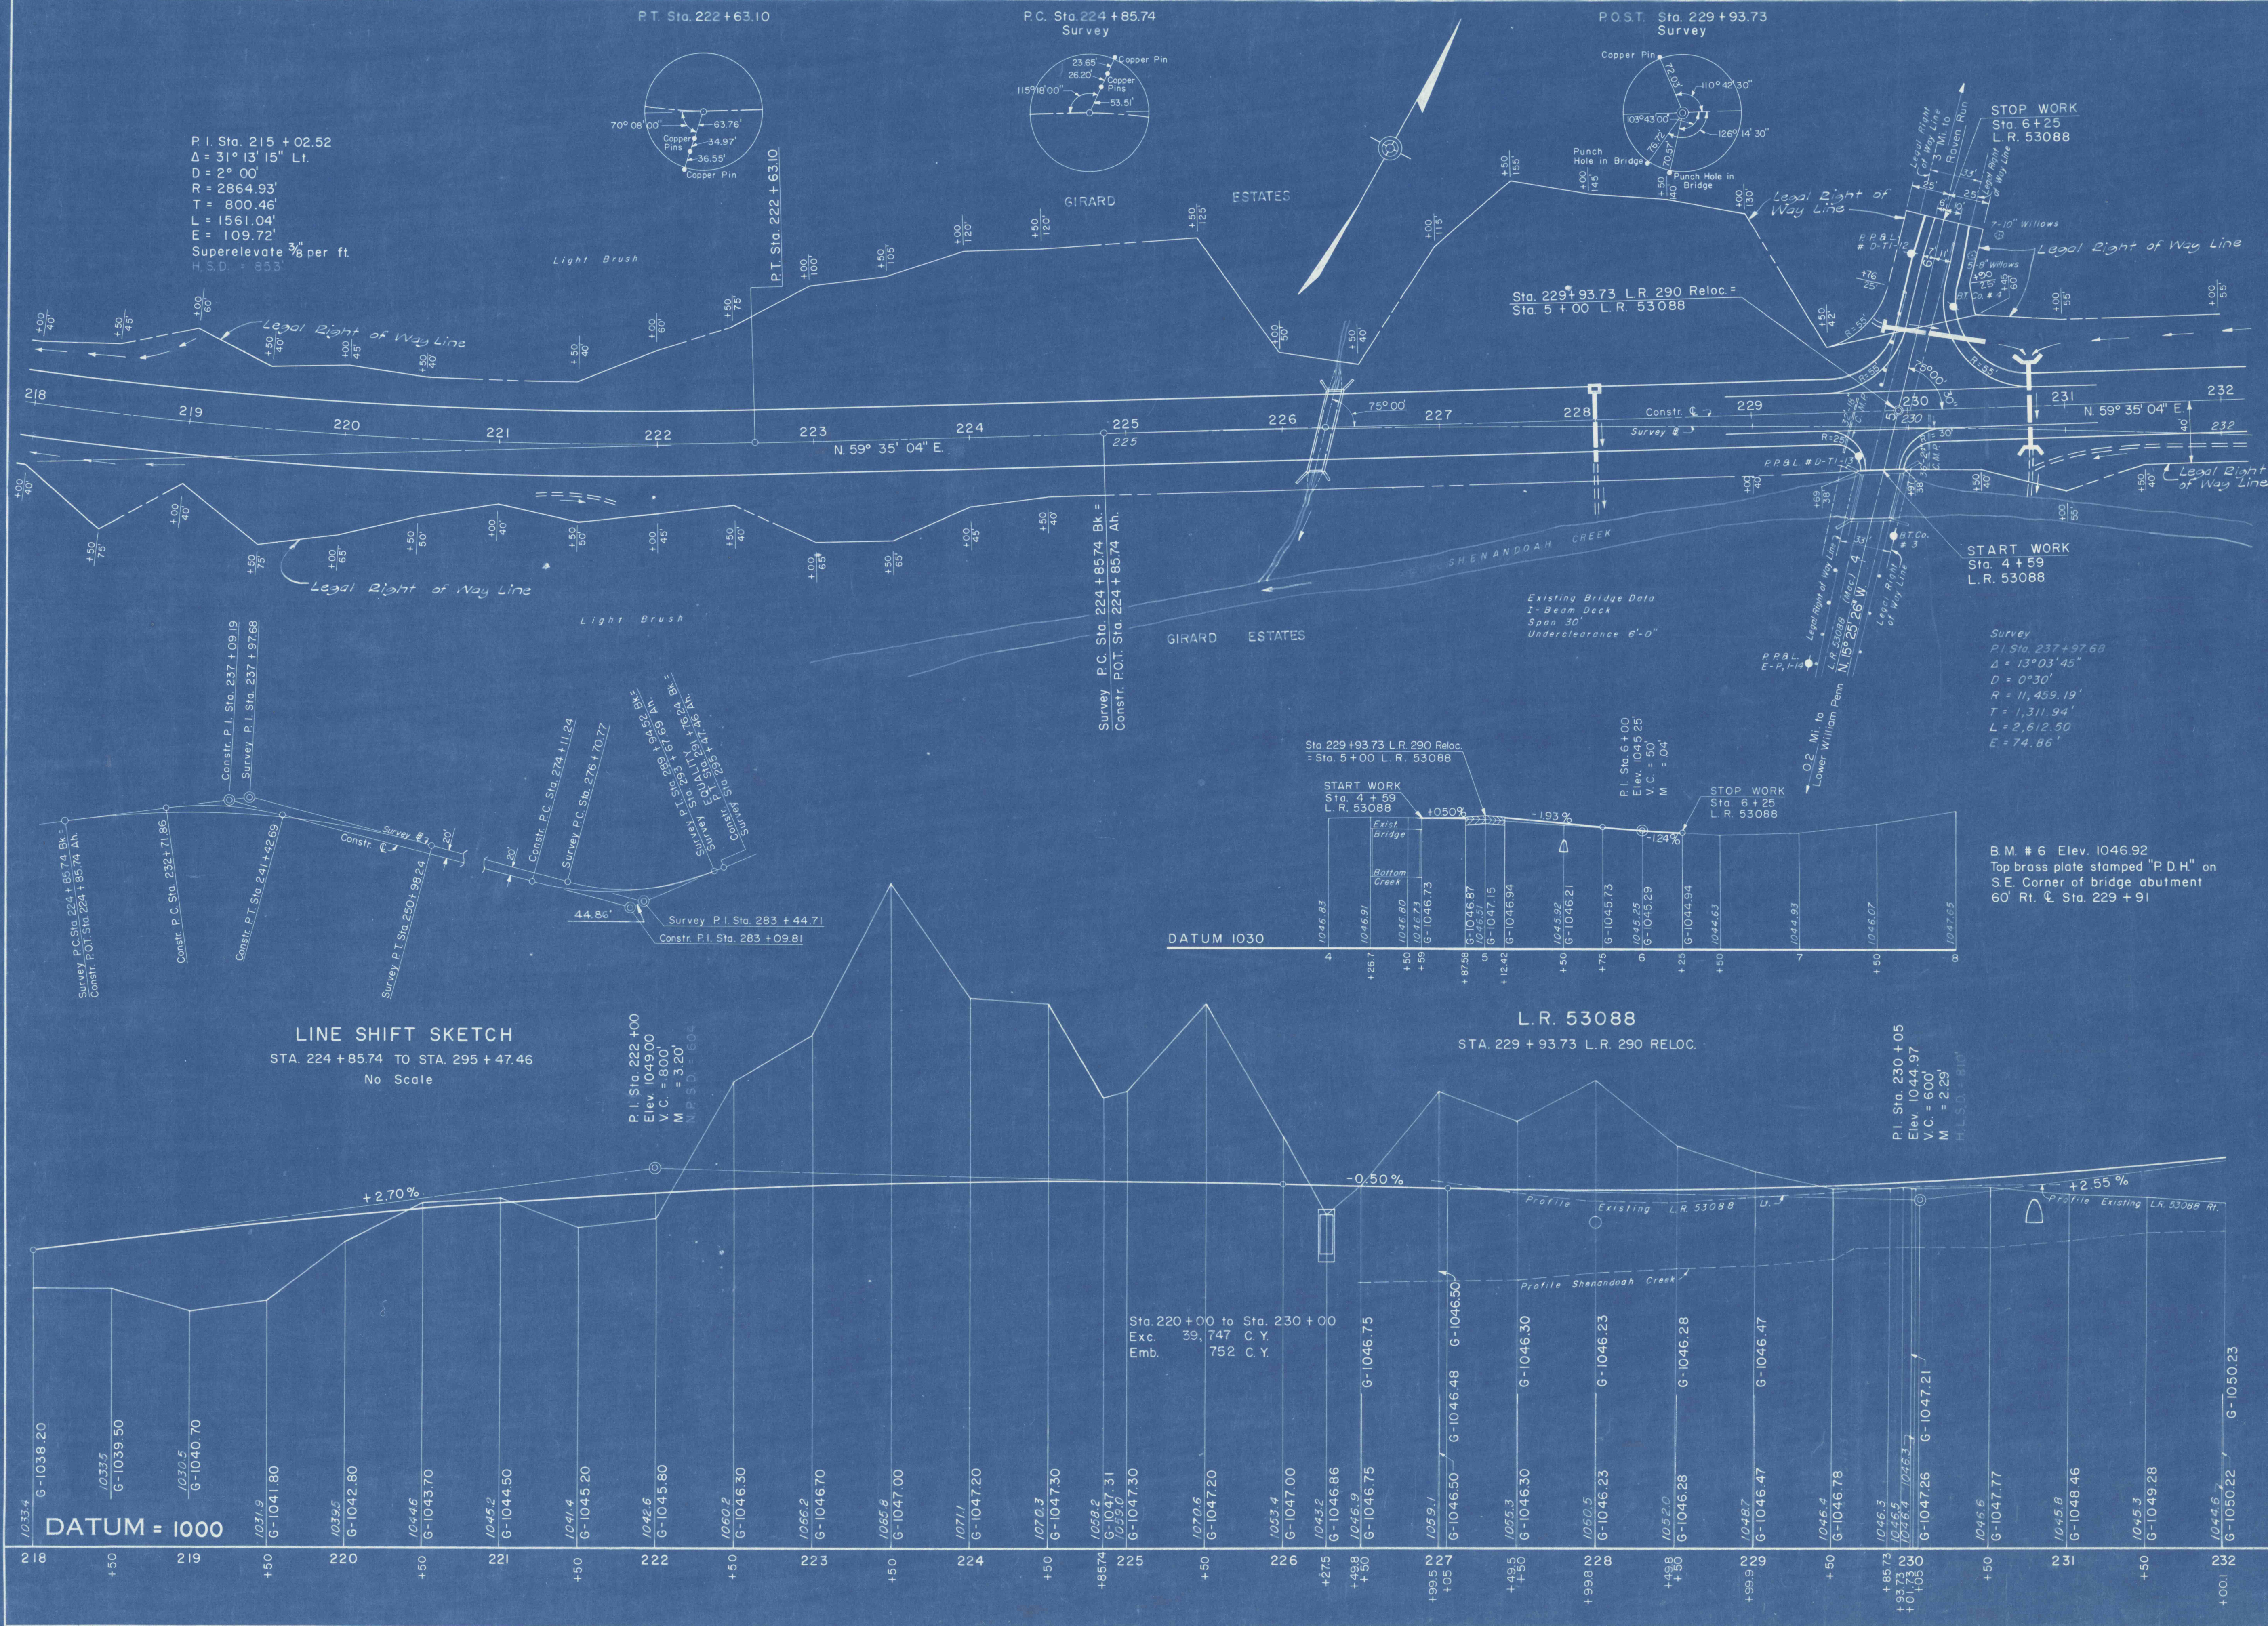

DISTRICT	COUNTY	ROUTE	SEC.	SHEET
5-0	SCHUYLKILL	290	19	21 of 33
WEST MAHANAY TWP.				
FINAL QUANTITIES	REQUIRED LIST			
	Sta. 218 + 25 to Sta. 219 + 60 Pocket Fill, Lt. 69 C.Y. Emb.			
	Sta. 219 + 25 to Sta. 221 + 50 4' Overexc. 580 C.Y. Cl. I Exc. 580 C.Y. Emb., Backfill (For Details, See X- Sections)			
	Sta. 220 + 25 to Sta. 220 + 60 Pocket Fill, Lt. 1 C.Y. Emb.			
	Sta. 221 + 25 to Sta. 221 + 75, Rt. 2 C.Y. Emb. (Pocket Fill) 19 C.Y. Cl. 2 Exc (Parallel Ditch, 18" Bottom)			
	Sta. 221 + 85 to Sta. 222 + 10, Lt. 4 C.Y. Emb. (Pocket Fill) 19 C.Y. Cl. I Exc. (Widened Cut for Drainage)			
	Sta. 225 + 75 to Sta. 228 + 50 4' Overexc. 1,066 C.Y. Cl. I Exc. 1,066 C.Y. Emb. Backfill (For Details, See X-Sections)			
	Sta. 226 + 10 to Sta. 226 + 75, Rt. 5 C.Y. Cl. I Exc. (Widened Cut for Drainage)			
	Sta. 227 + 75 to Sta. 229 + 60 Unsuitable Material 1,045 C.Y. Cl. I Exc. 834 C.Y. Emb. Backfill (For Details, See X-Sections)			
	Sta. 228 + 00 46 L.F. 18" ACCM. Pipe Fully Coated 1 Type H Inlet, Lt. 12 C.Y. Cl. 2 Exc. (Pipe) 24 C.Y. Cl. 2 Exc. (Outlet Ditch)			
Sta. 229 + 67 13 C.Y. Cl. 2 Exc. (Remove Exist. Pipe)				
L.R. 53088 - LT. & RT. STA. 229 + 93.73				
Sta. 4 + 59 to Sta. 6 + 25 476 S.Y. Bit. Surf. Crse., ID-2, 2½" Depth 497 S.Y. Cr. Aggr. Base Crse, Type B, 8" Depth 497 S.Y. Subgrade 54 L.F. Shoulders 118 C.Y. Cl. I Exc. 97 C.Y. Emb. (For Typical Section, See Sheet No. 5)				
Sta. 5 + 52 62 L.F. 29"x18" ACCM. Pipe Arch 07 C.Y. Cl. B Conc. (Type D Edw., Lt.) 22 C.Y. Cl. 2 Exc. (Pipe & Edw.) 2 C.Y. Cl. 2 Exc. (Inlet Ditch)				
Sta. 230 + 14 17 C.Y. Cl. 2 Exc. (Remove Exist. Pipe, Rt.)				
Sta. 230 + 15 to Sta. 236 + 50 Unsuitable Material 8,639 C.Y. Cl. I Exc. 8,400 C.Y. Emb. Backfill (For Details, See X-Sections)				
Sta. 230 + 15 to Sta. 231 + 50 4' Overexc. 119 C.Y. Cl. I Exc. 119 C.Y. Emb. Backfill (For Details, See X-Sections)				
Sta. 230 + 78 56 L.F. 58"x36" ACCM. Pipe Arch 62 C.Y. Cl. B Conc. (Type DW Edws., Lt. & Rt.) 91 C.Y. Cl. 2 Exc. (Pipe & Edws.) 25 C.Y. Cl. 2 Exc. (Inlet & Outlet Ditch)				
Sta. 230 + 80 to Sta. 232 + 30, Rt. 57 C.Y. Cl. 2 Exc. (Parallel Ditch, 18" Bottom) 127 C.Y. Cl. I Exc. (Widened Cut)				
Sta. 226 + 27.5 Reinf. Conc. Box - 54.75' long Span - 8', Min Act. Cl. - 5', Nom Cl. - 5', Skew - 75° Lt. 60 C.Y. Cl. I Exc. - Box 209 C.Y. Cl. I Exc. - Channel 55 C.Y. Cl. 2 Exc. 57 C.Y. Cl. A Conc. 22 C.Y. Cl. B Conc. 10,030 Lbs. Reinf. Bars 5-4234 Appr. 6-30-60				
Alignment Book No. 14461 Topography Book No. 14465, 14466 Profile Book No. 14470, 14471, 14475				
TRACED BY FINAL BY				