
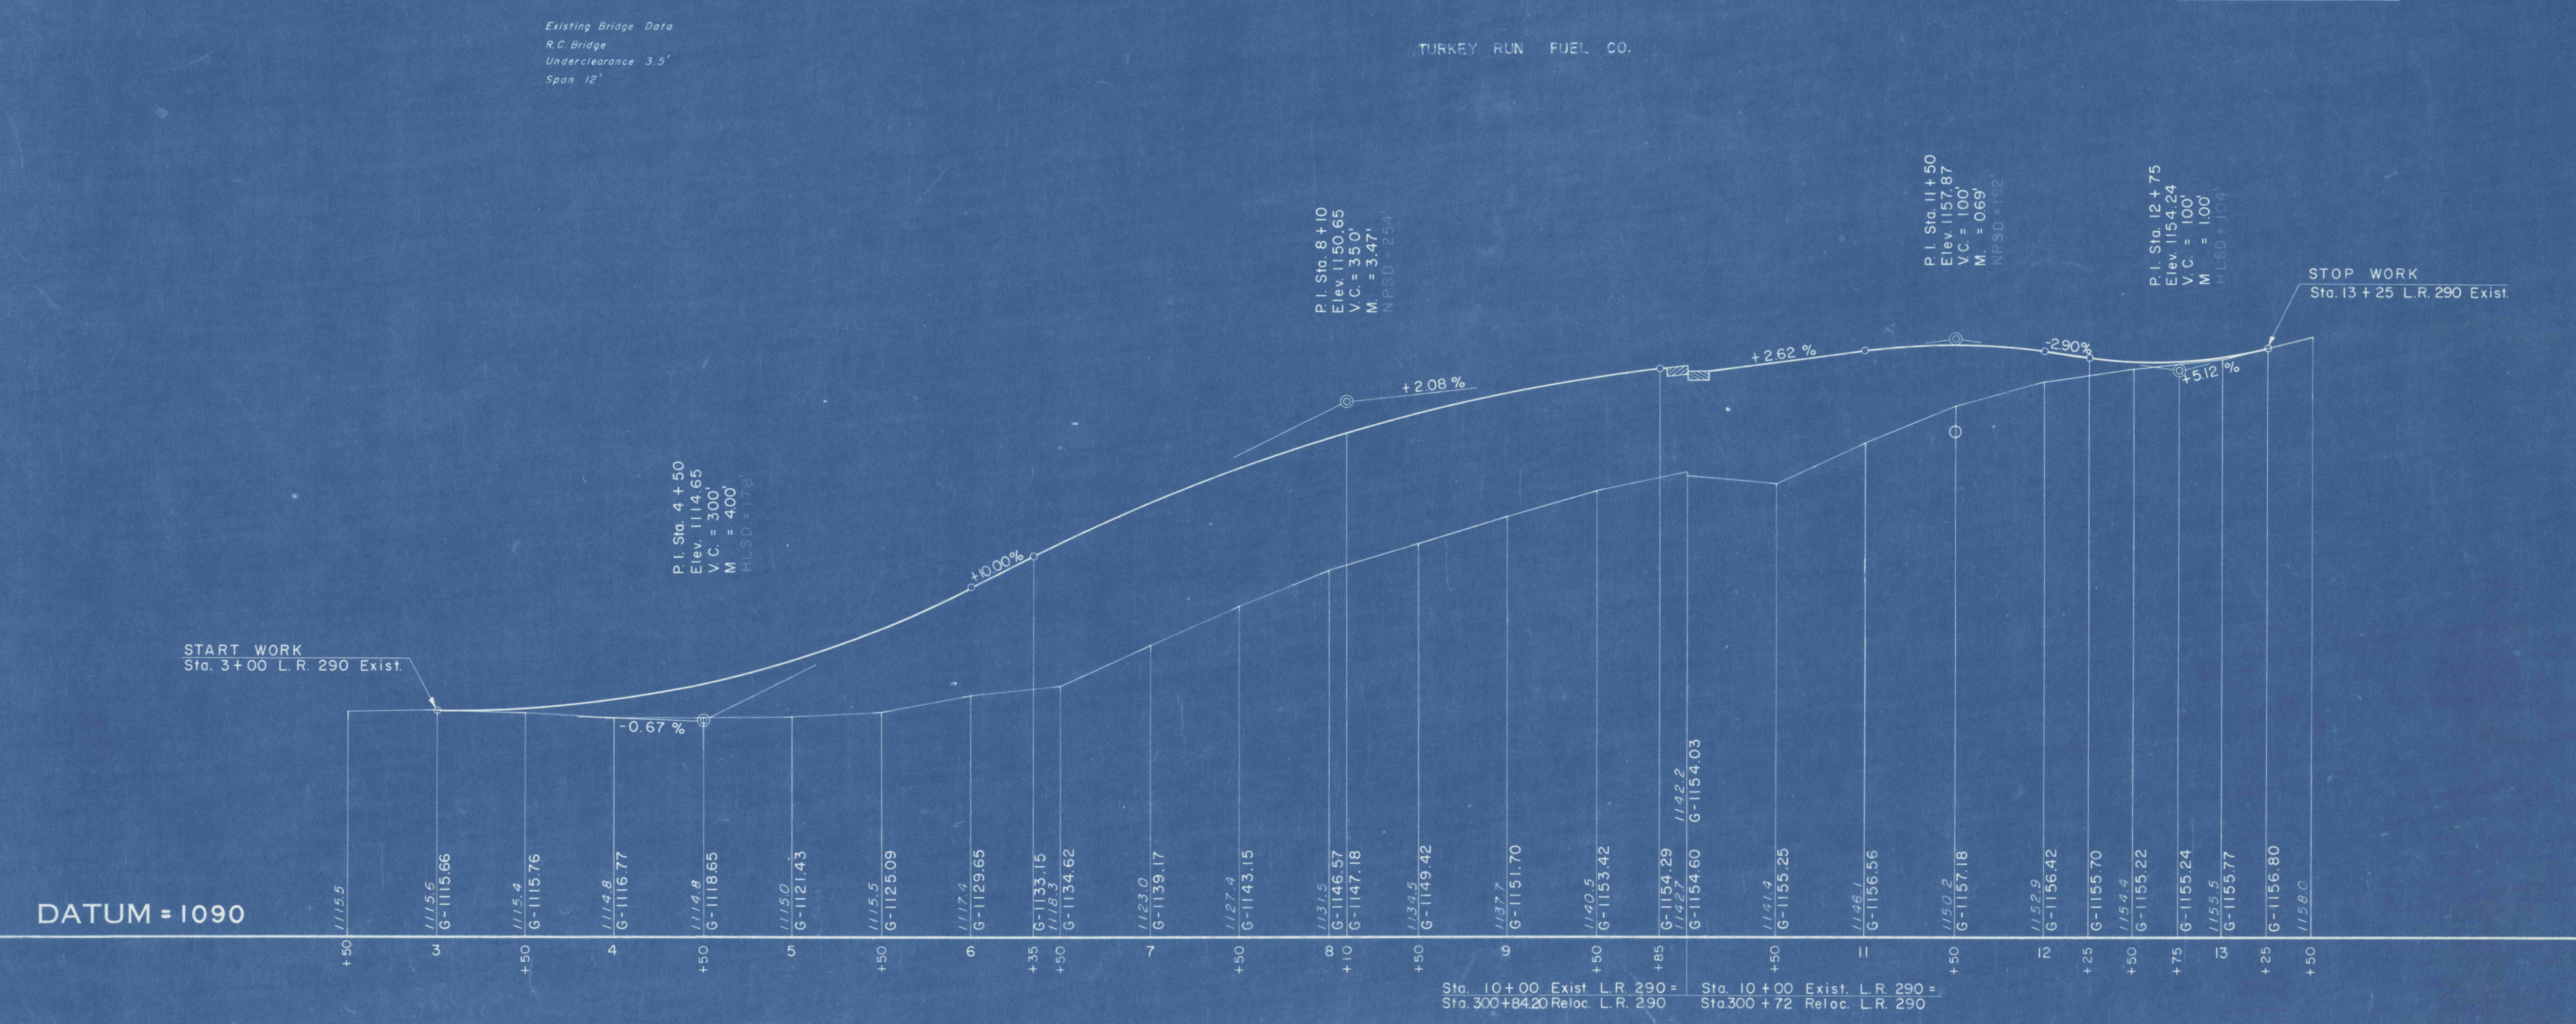


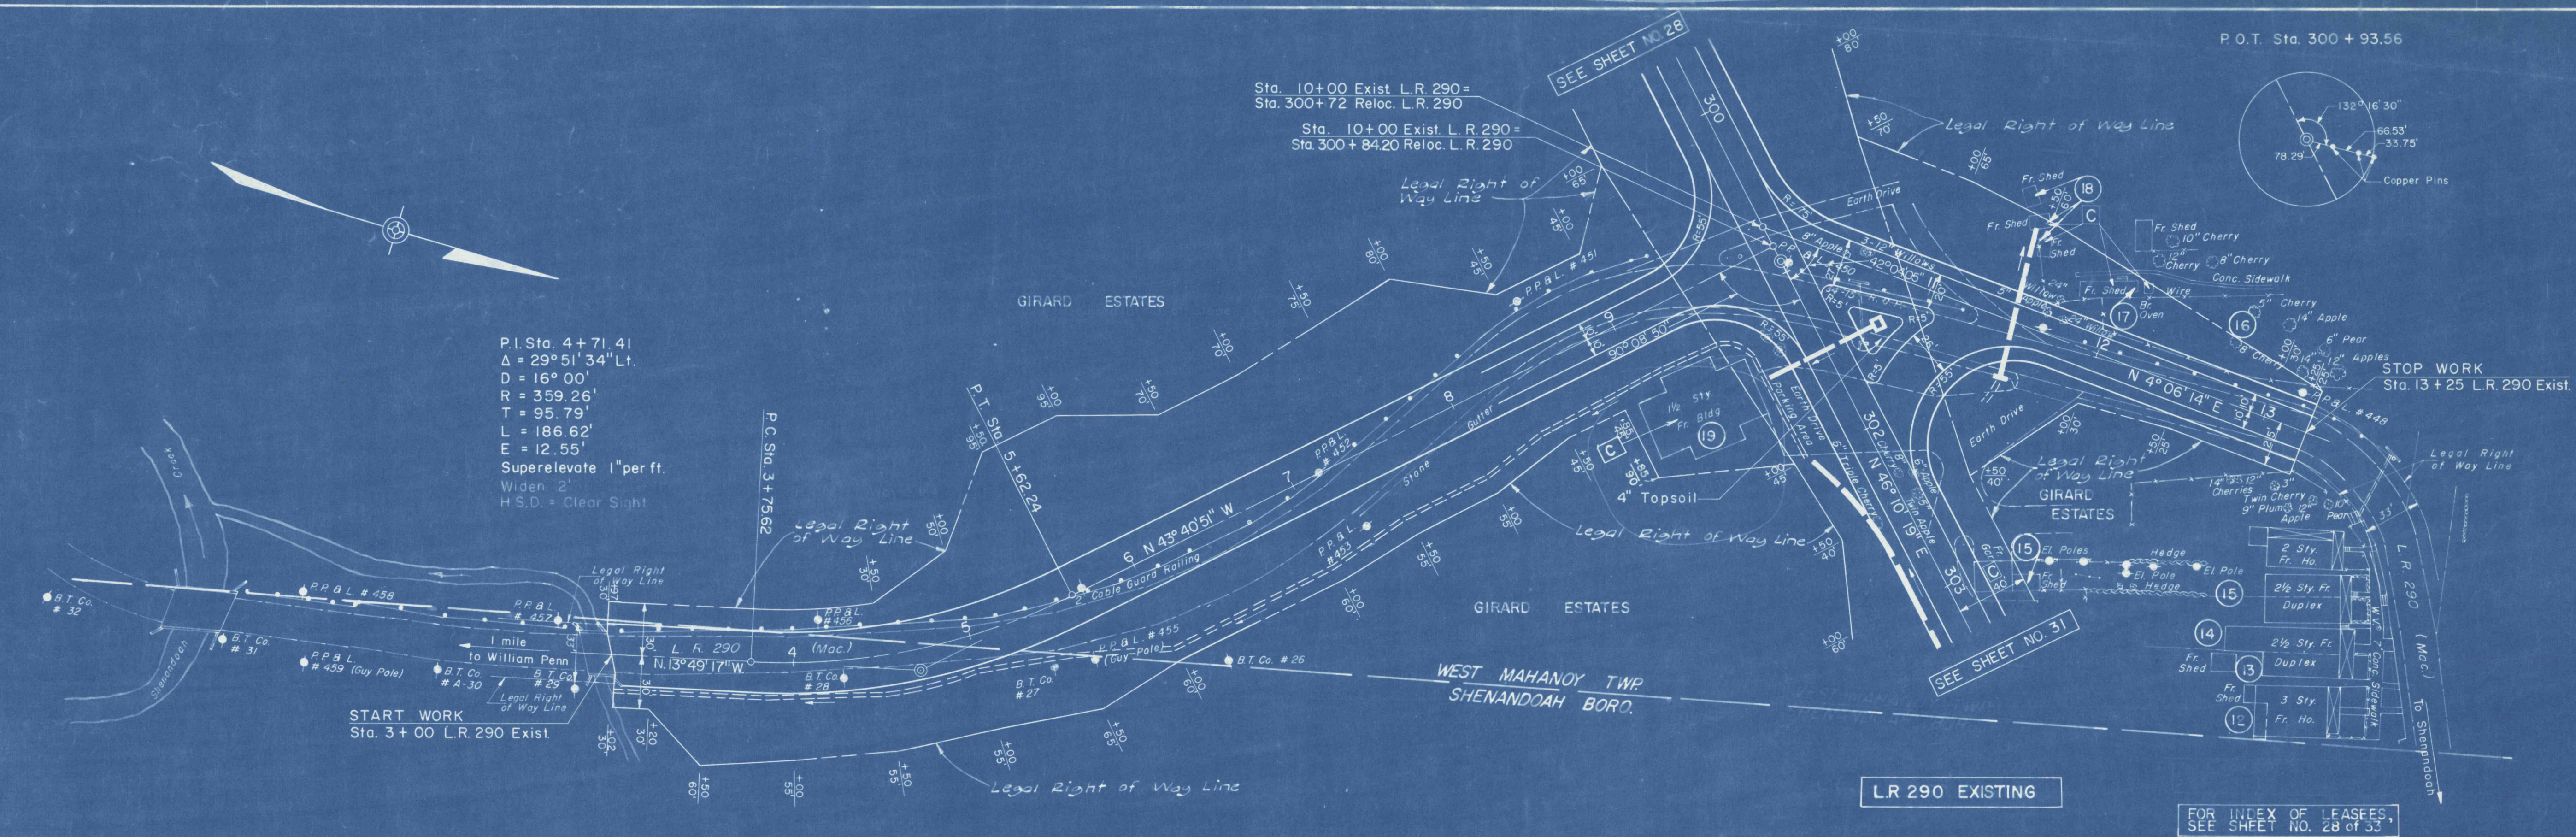

DISTRICT	COUNTY	ROUTE	SEC.	SHEET
5-0	SCHUYLKILL	290	19	30 of 33
WEST MAHANAY TWP.				
FINAL QUANTITIES	REQUIRED LIST			
	L.R. 290 Exist. Lt. Sta. 300+72 & Rt. Sta. 300+84.20 Sta. 3+00 to Sta. 13+25 "			
	2667 S.Y. Bit. Surf. Crse. ID-2, 2½ Depth			
	2780 S.Y. Cr. Aggr. Base Crse, Type B, 8" Depth			
	2780 S.Y. Subgrade			
	853 L.F. Shoulders			
	118 C.Y. Cl. 1 Exc.			
	21,807 C.Y. Emb.			
	(For Typical Section, See Sheet No. 5)			
	Sta. 3+00 to Sta. 302+00 M, Rt. 520 C.Y. Cl. 2 Exc. (Parallel Ditch, 2' Bottom) 212 C.Y. Cl. 1 Exc. (Widened Cut)			
Sta. 4+90 to Sta. 6+90 Pocket Fill, Lt. 34 C.Y. Emb.				
Sta. 5+75 to Sta. 9+64 Pocket Fill, Rt. 54 C.Y. Emb.				
Sta. 10+63 to Sta. 10+94 Island, Rt. 54 S.Y. 4" Topsoil				
Sta. 11+50 90 L.F. 18" ACCM. Pipe Fully Coated 06 C.Y. Cl. B Conc. (Type D Edw., Rt.) 27 C.Y. Cl. 2 Exc. (Pipe & Edw.) 2 C.Y. Cl. 2 Exc. (Inlet Ditch)				
Sta. 11+58 to Sta. 12+75 Pocket Fill, Rt 10 C.Y. Emb.				