


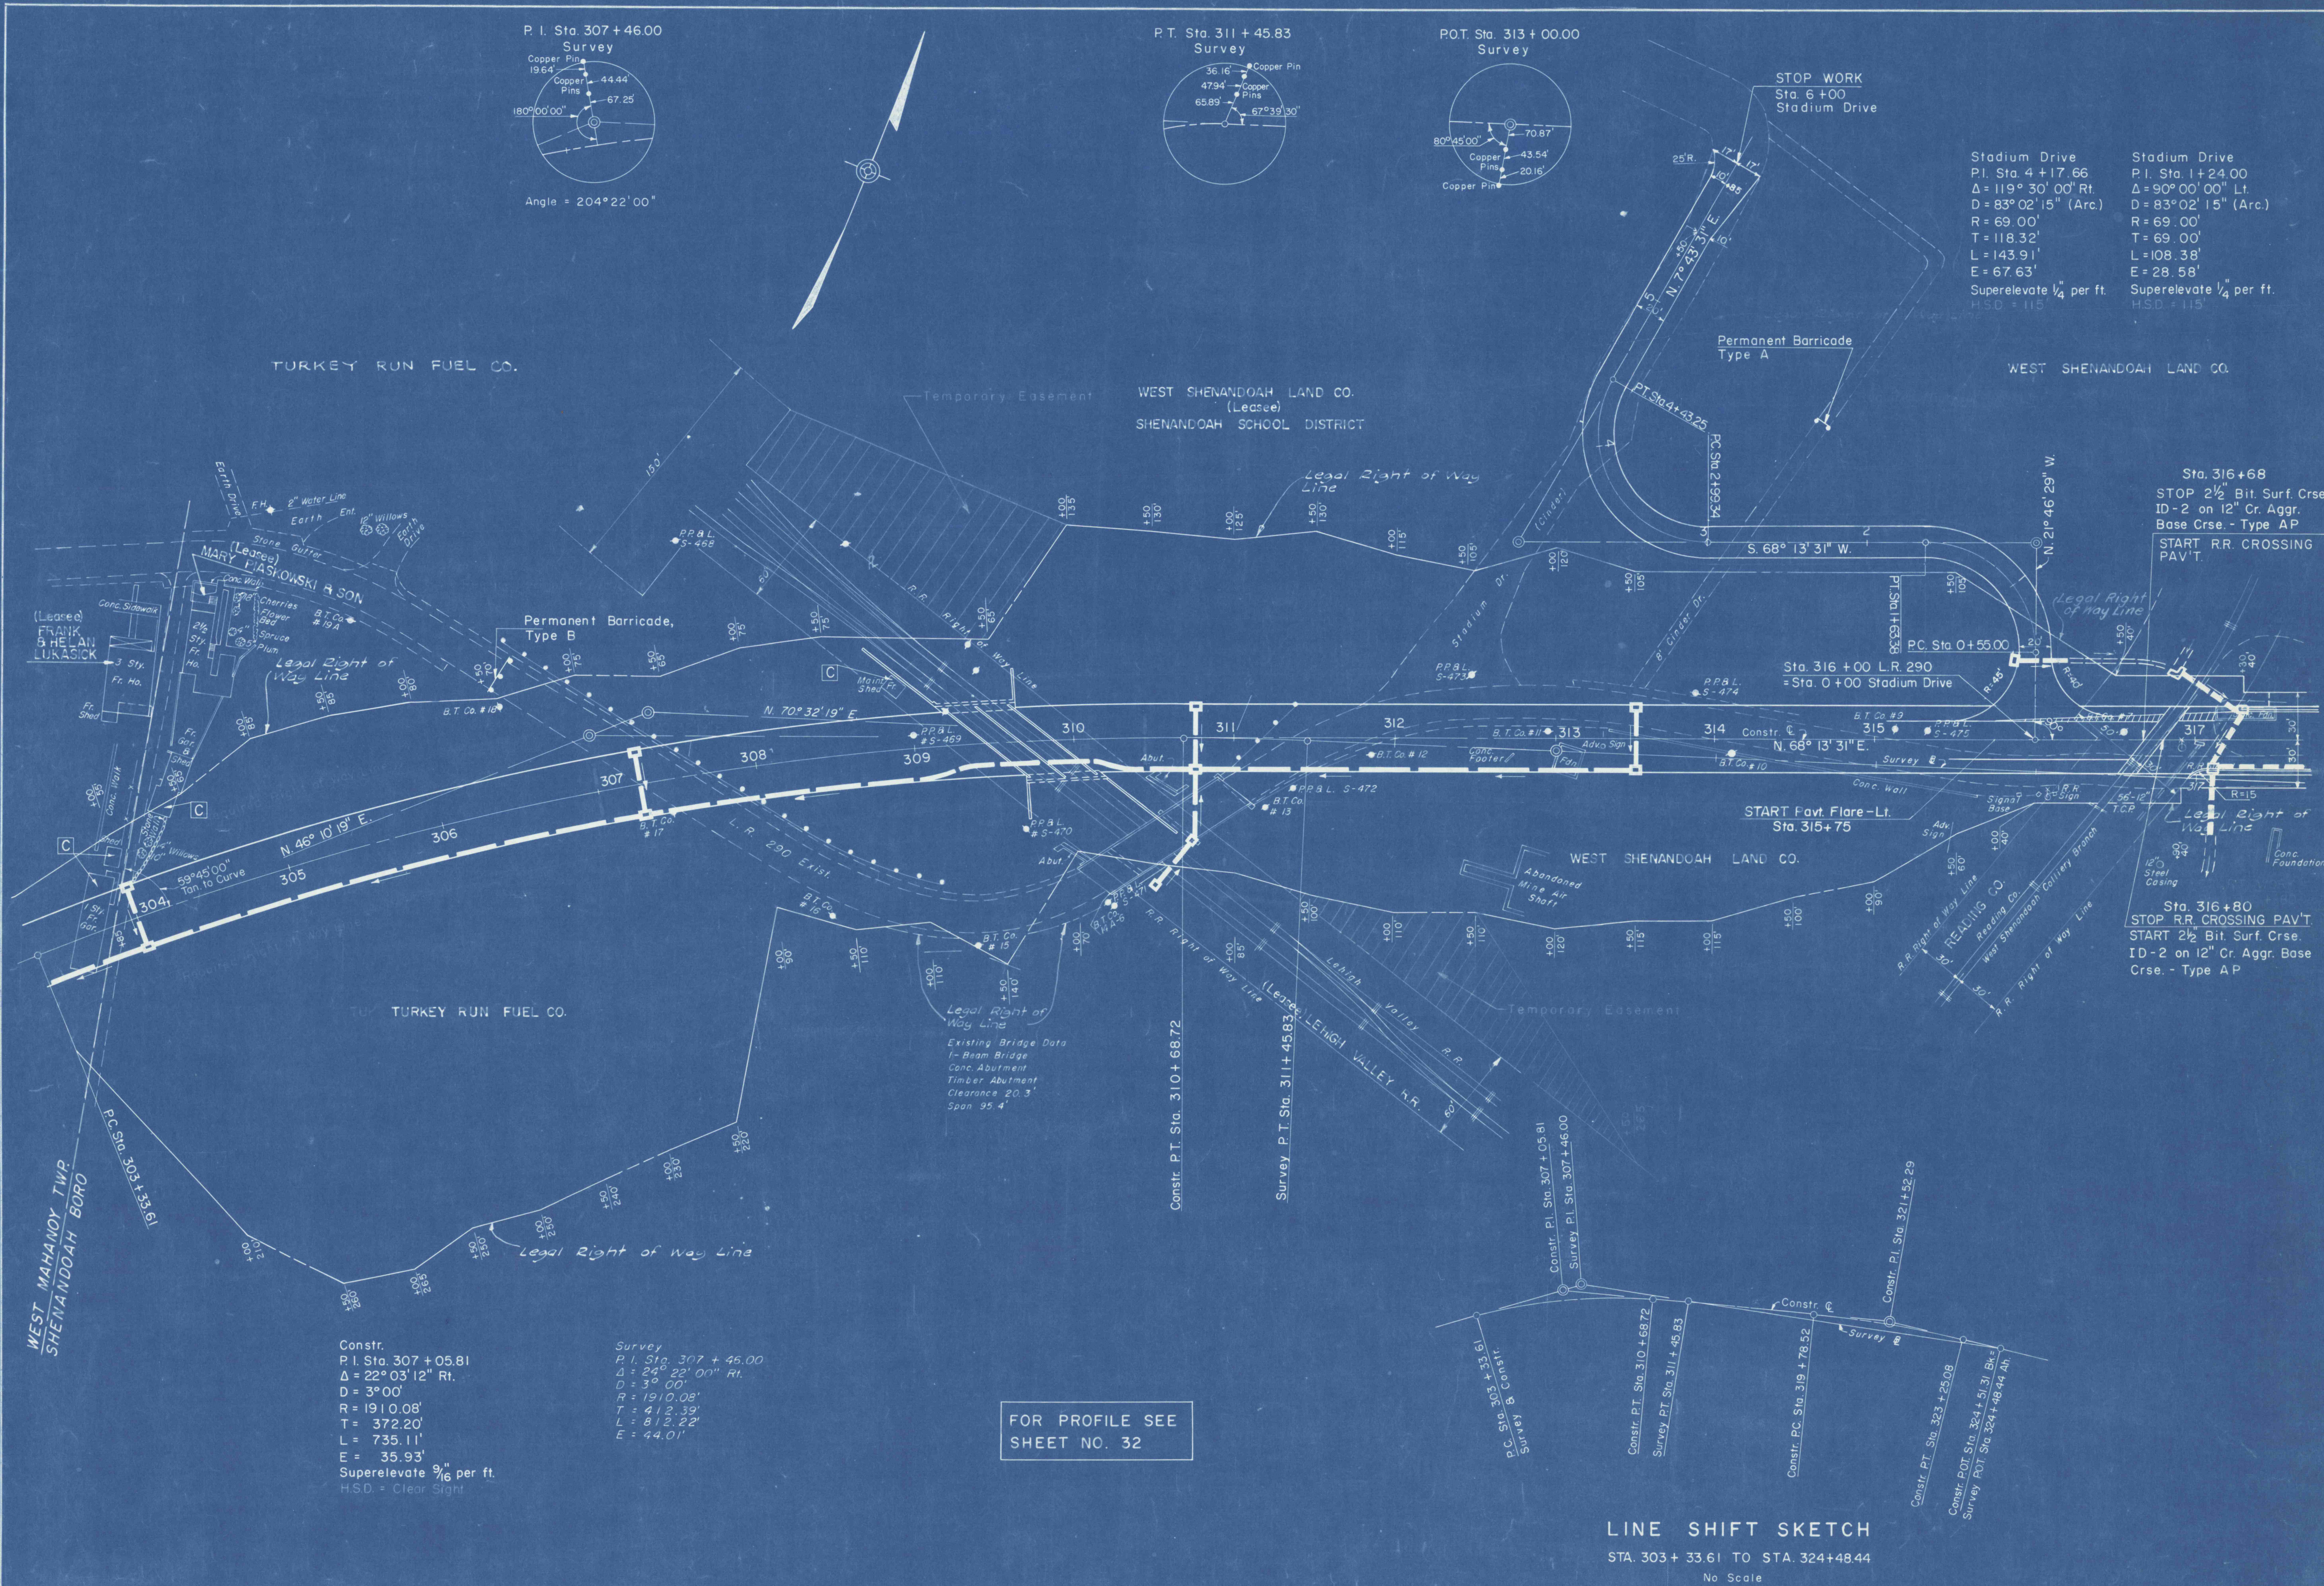

DISTRICT	COUNTY	ROUTE	SEC.	SHEET
5-0	SCHUYLKILL	290	19	31 of 33
WEST MAHANAY TWP., SHENANDOAH BORO				
FINAL QUANTITIES	REQUIRED LIST			
	Sta. 306 + 60 Lt.			
	24	L.F. Permanent Barricade, Type B		
	Sta. 307 + 26			
	36	L.F. 18" A.C.C.M. Pipe Fully Coated		
	2	Type H Inlets, Lt. & Rt.		
	9	C.Y. Cl. 2 Exc. (Pipe)		
	Sta. 310 + 25 to Sta. 315 + 00			
	157	C.Y. Cl. 1 Exc. (Rock below Subgrade)		
	157	C.Y. Emb. (Backfill)		
	Sta. 310 + 55 to Sta. 310 + 76, Rt.			
	32	L.F. 15" Cast Iron Pipe (Under R.R. Tracks)		
	52	C.Y. Cl. B Conc. (2 Type A Edws.)		
	31	C.Y. Cl. 2 Exc. (Pipe & Edws.)		
	Sta. 310 + 56, Rt.			
	Item 40- L.S. Removal of Existing Bridge Superstructure; No materials reserved by Dep't.			
	Sta. 310 + 76			
	36	L.F. 18" A.C.C.M. Pipe Fully Coated		
	2	Type H Inlets, Lt. & Rt.		
	15	C.Y. Cl. 2 Exc. (Pipe)		
	Sta. 310 + 76, Rt.			
	50	L.F. 18" A.C.C.M. Pipe Fully Coated		
	14	C.Y. Cl. 2 Exc. (Pipe)		
	Sta. 310 + 78 to Sta. 313 + 48, Rt. Comb. S.S. & Udrain.			
	270	L.F. 18" Extra Str. V.C. Pipe (Open Joints) or Perf. A.C.C.M. Pipe Fully Coated		
	24	C.Y. 2 B Crse. Aggr.		
	104	C.Y. Cl. 2 Exc. (Pipe)		
	Sta. 313 + 50			
	36	L.F. 18" A.C.C.M. Pipe Fully Coated		
	2	Type H Inlets, Lt. & Rt.		
	15	C.Y. Cl. 2 Exc. (Pipe)		
	STADIUM DRIVE, LT. STA. 316 + 00			
	Sta. 0 + 12 to Sta. 6 + 00 (Graded Width 24')			
	1405	S.Y. Bit. Surf. Crse., ID-2, 2½" Depth		
	1405	S.Y. Cr. Aggr. Base Crse., Type-B, (8" Depth)		
	1405	S.Y. Subgrade		
	19,351	C.Y. Cl. 1 Exc.		
	Sta. 0 + 50			
	28	L.F. 22" x 13" A.C.C.M. Pipe Arch		
	1	Type H Inlet, Lt.		
	7	C.Y. Cl. 2 Exc. (Pipe)		
	210	C.Y. Cl. 2 Exc. (Outlet Ditch)		
	Sta. 2 + 28			
	8	L.F. Permanent Barricade, Type-A		
	Sta. 316 + 68 to Sta. 316 + 80 Railroad Crossing			
	21	Tons Bit. Surf. Crse. ID-2		
	Sta. 316 + 90 to Sta. 317 + 25, Lt.			
	44	L.F. 24" Cast Iron Pipe (Under RR Tracks)		
	14	C.Y. Cl. B Conc. (Type DE Edw., Lt.)		
	46	C.Y. Cl. 2 Exc. (Pipe & Edw.)		
	5	C.Y. Cl. 2 Exc. (Inlet Ditch)		
	Sta. 317 + 12 to Sta. 320 + 32 Comb. S.S. & Udrain, Rt.			
	320	L.F. 18" Extra Str. V.C. Pipe (Open Joints) or Perf. A.C.C.M. Pipe Fully Coated		
	26	C.Y. 2 B Crse. Aggr.		
	77	C.Y. Cl. 2 Exc. (Pipe)		
	5	C.Y. Cl. 2 Exc. (Outlet Ditch)		
	Sta. 317 + 16 to Sta. 324 + 51- Lt. & Rt.			
	528	L.F. Shoulders		
	(CONTINUED ON PROFILE SHEET 32)			
	Alignment Book No. 14461, 1447			
	Topography Book No. 14466, 14467, 14475			