


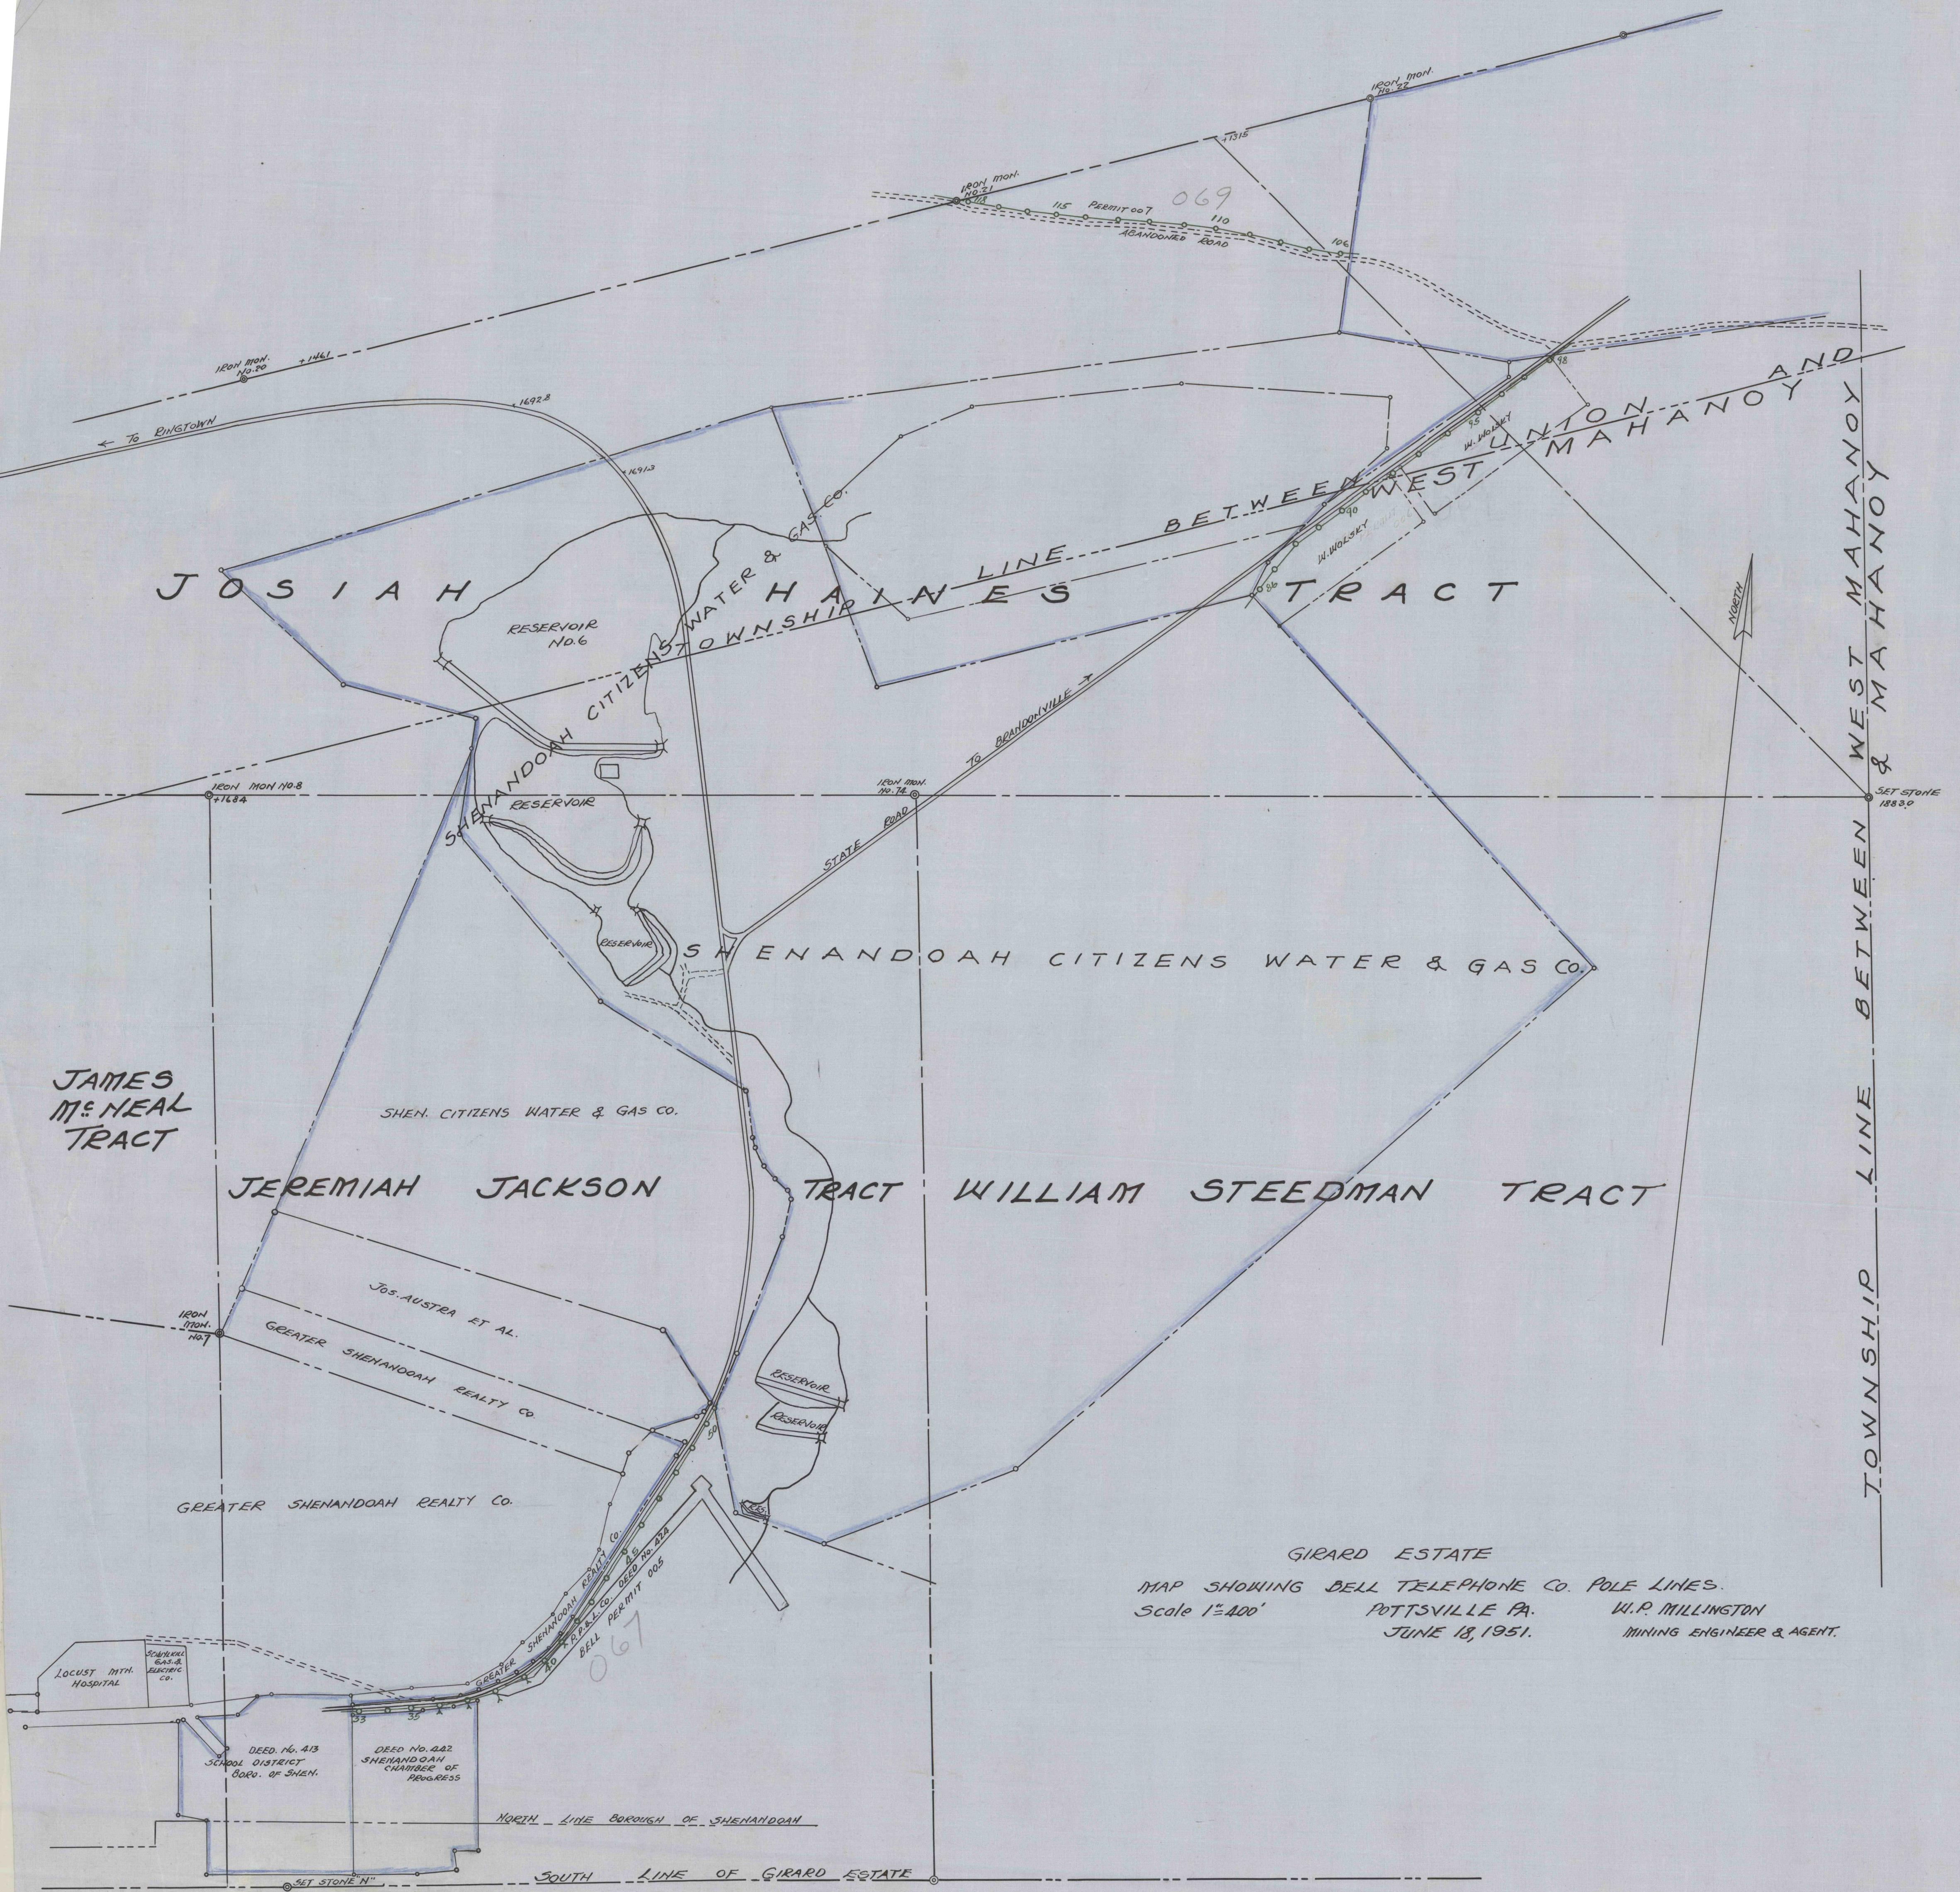

GIRARD ESTATE
MAP SHOWING BELL TELEPHONE CO. POLE LINES.
Scale 1"=400' POTTSVILLE PA. W.P. MILLINGTON
JUNE 18, 1951. MINING ENGINEER & AGENT.