


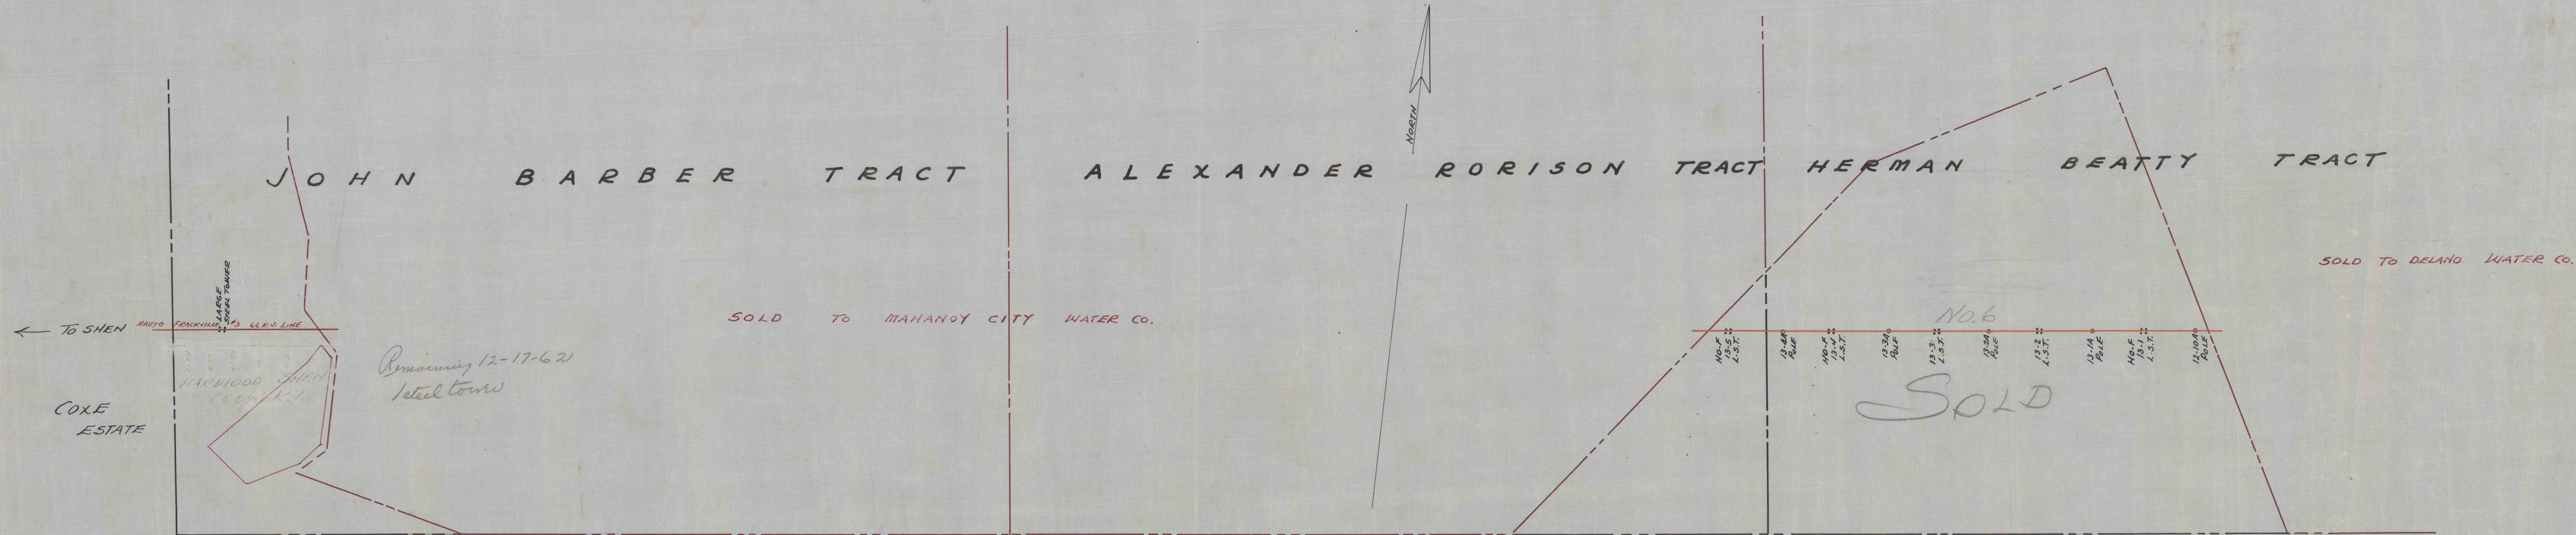

GIRARD ESTATE
MAP SHOWING P.P.&L. POLE LINES IN
VICINITY OF MAHANAY CITY & GIRARD WATER CO.
Scale 1"=300' MAY 2, 1951 REVISED DEC. '62.