


B.M. Spike in Trunk of 24' Oak
30' Rt. of Sta 130+00
Elev 1519.426

B.M. Spike in Root of 14' Oak
40' Lt. of Sta 137+15
Elev 1465.002

Dir.	County	Route	App.	Sheet
5	Schuylkill	755	6615	8 of 15
Union Twp.				

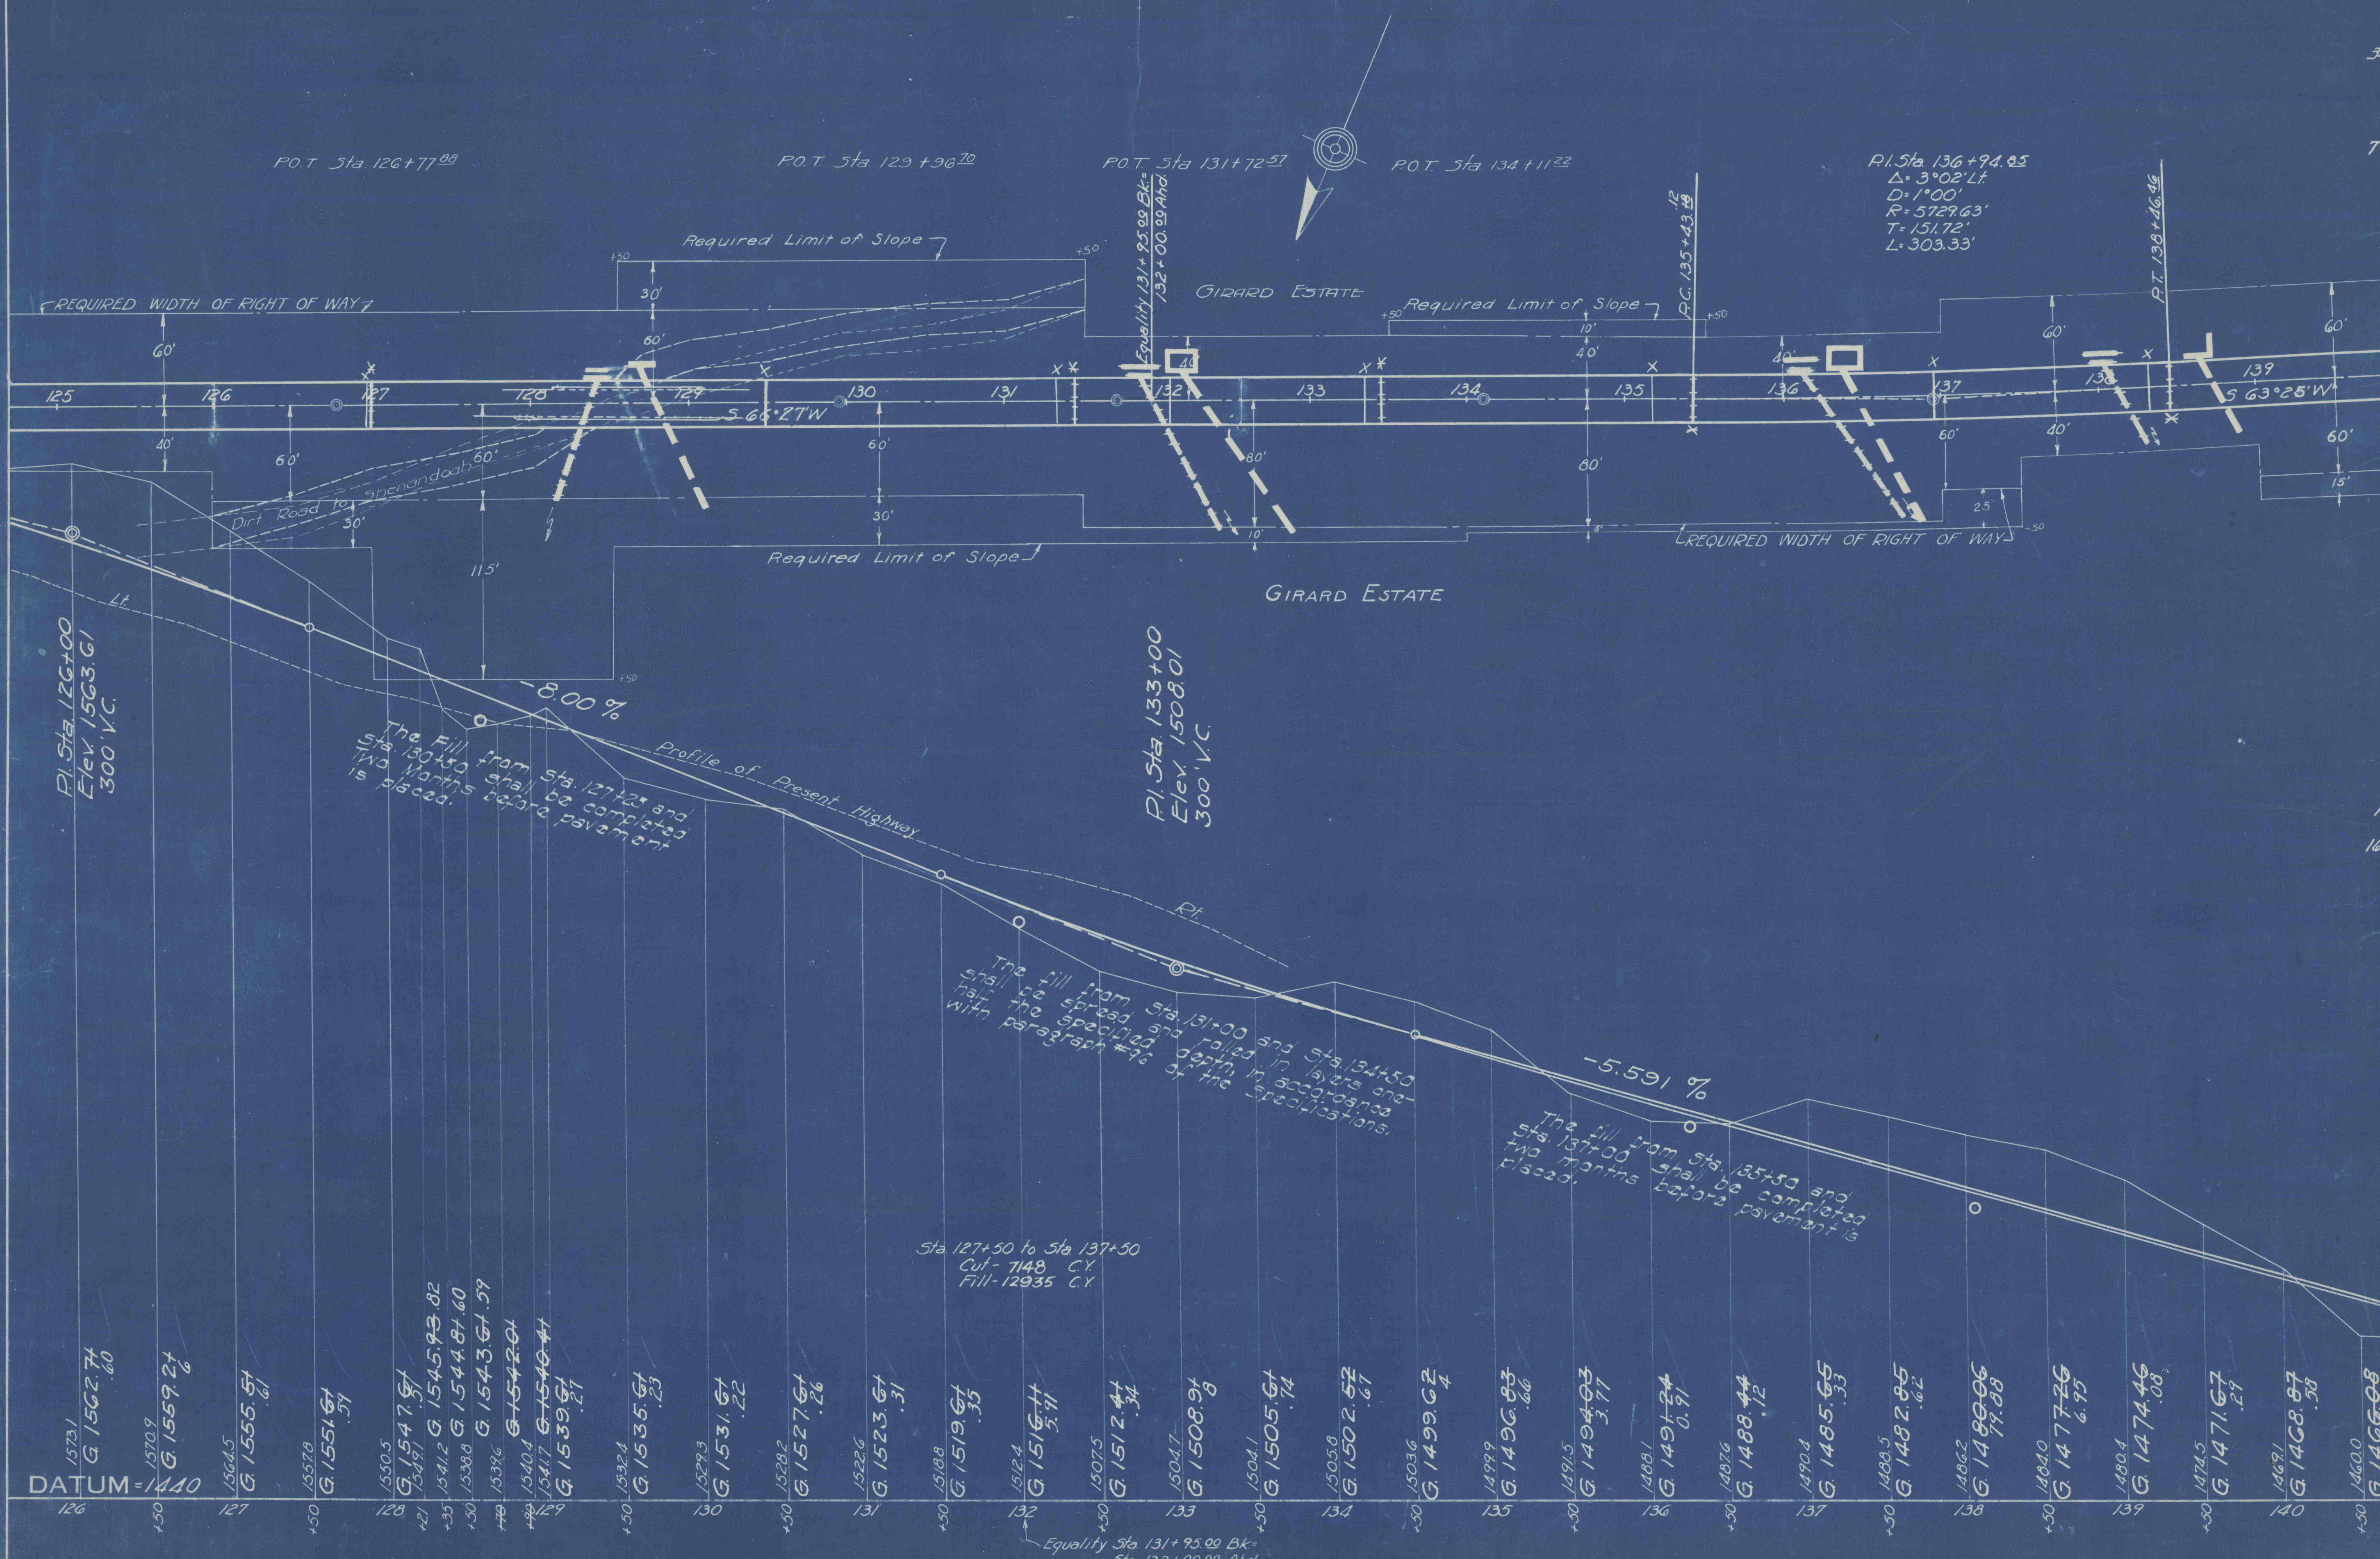

REQUIRED LIST				
Sta. 126+00 to Sta. 128+45	3411	2494	Cu. Yds. fill to Grade Road to Rt.	
Sta. 128+45 to Sta. 131+50	775	2326	C.Y. Excav. to grade Road to Lt.	
Sta. 128+00			10.82 Cu. ft. "B" Conc.	
Sta. 132+00			107.29 Cu. ft. "B" Conc.	
Sta. 136+00			40.42 Cu. ft. "B" Conc.	
Sta. 138+00			16.79 Cu. ft. "B" Conc.	
Sta. 127+00 to Sta. 137+50	1601.9	667	C.Y. Excav. for benching slopes on Rt.	
Sta. 128+00 to 128+74			Place 2.5 Y. Plain conc. for conc. apron on Rt. (1' x 8')	
Sta. 128+75 to 128+77			Place 2.5 Y. Plain cem. conc. for cont. apron on Lt. (1' x 8')	
Sta. 128+00			1.3 C.Y. Boulder Excav.	
Sta. 136+50			1.8 C.Y. Boulder Excav.	