Div.	Dist.	County	Route	Sec.	Sheet
3	5	Schuylkill	755	C	4 of 7

West Mahanoy Twp.

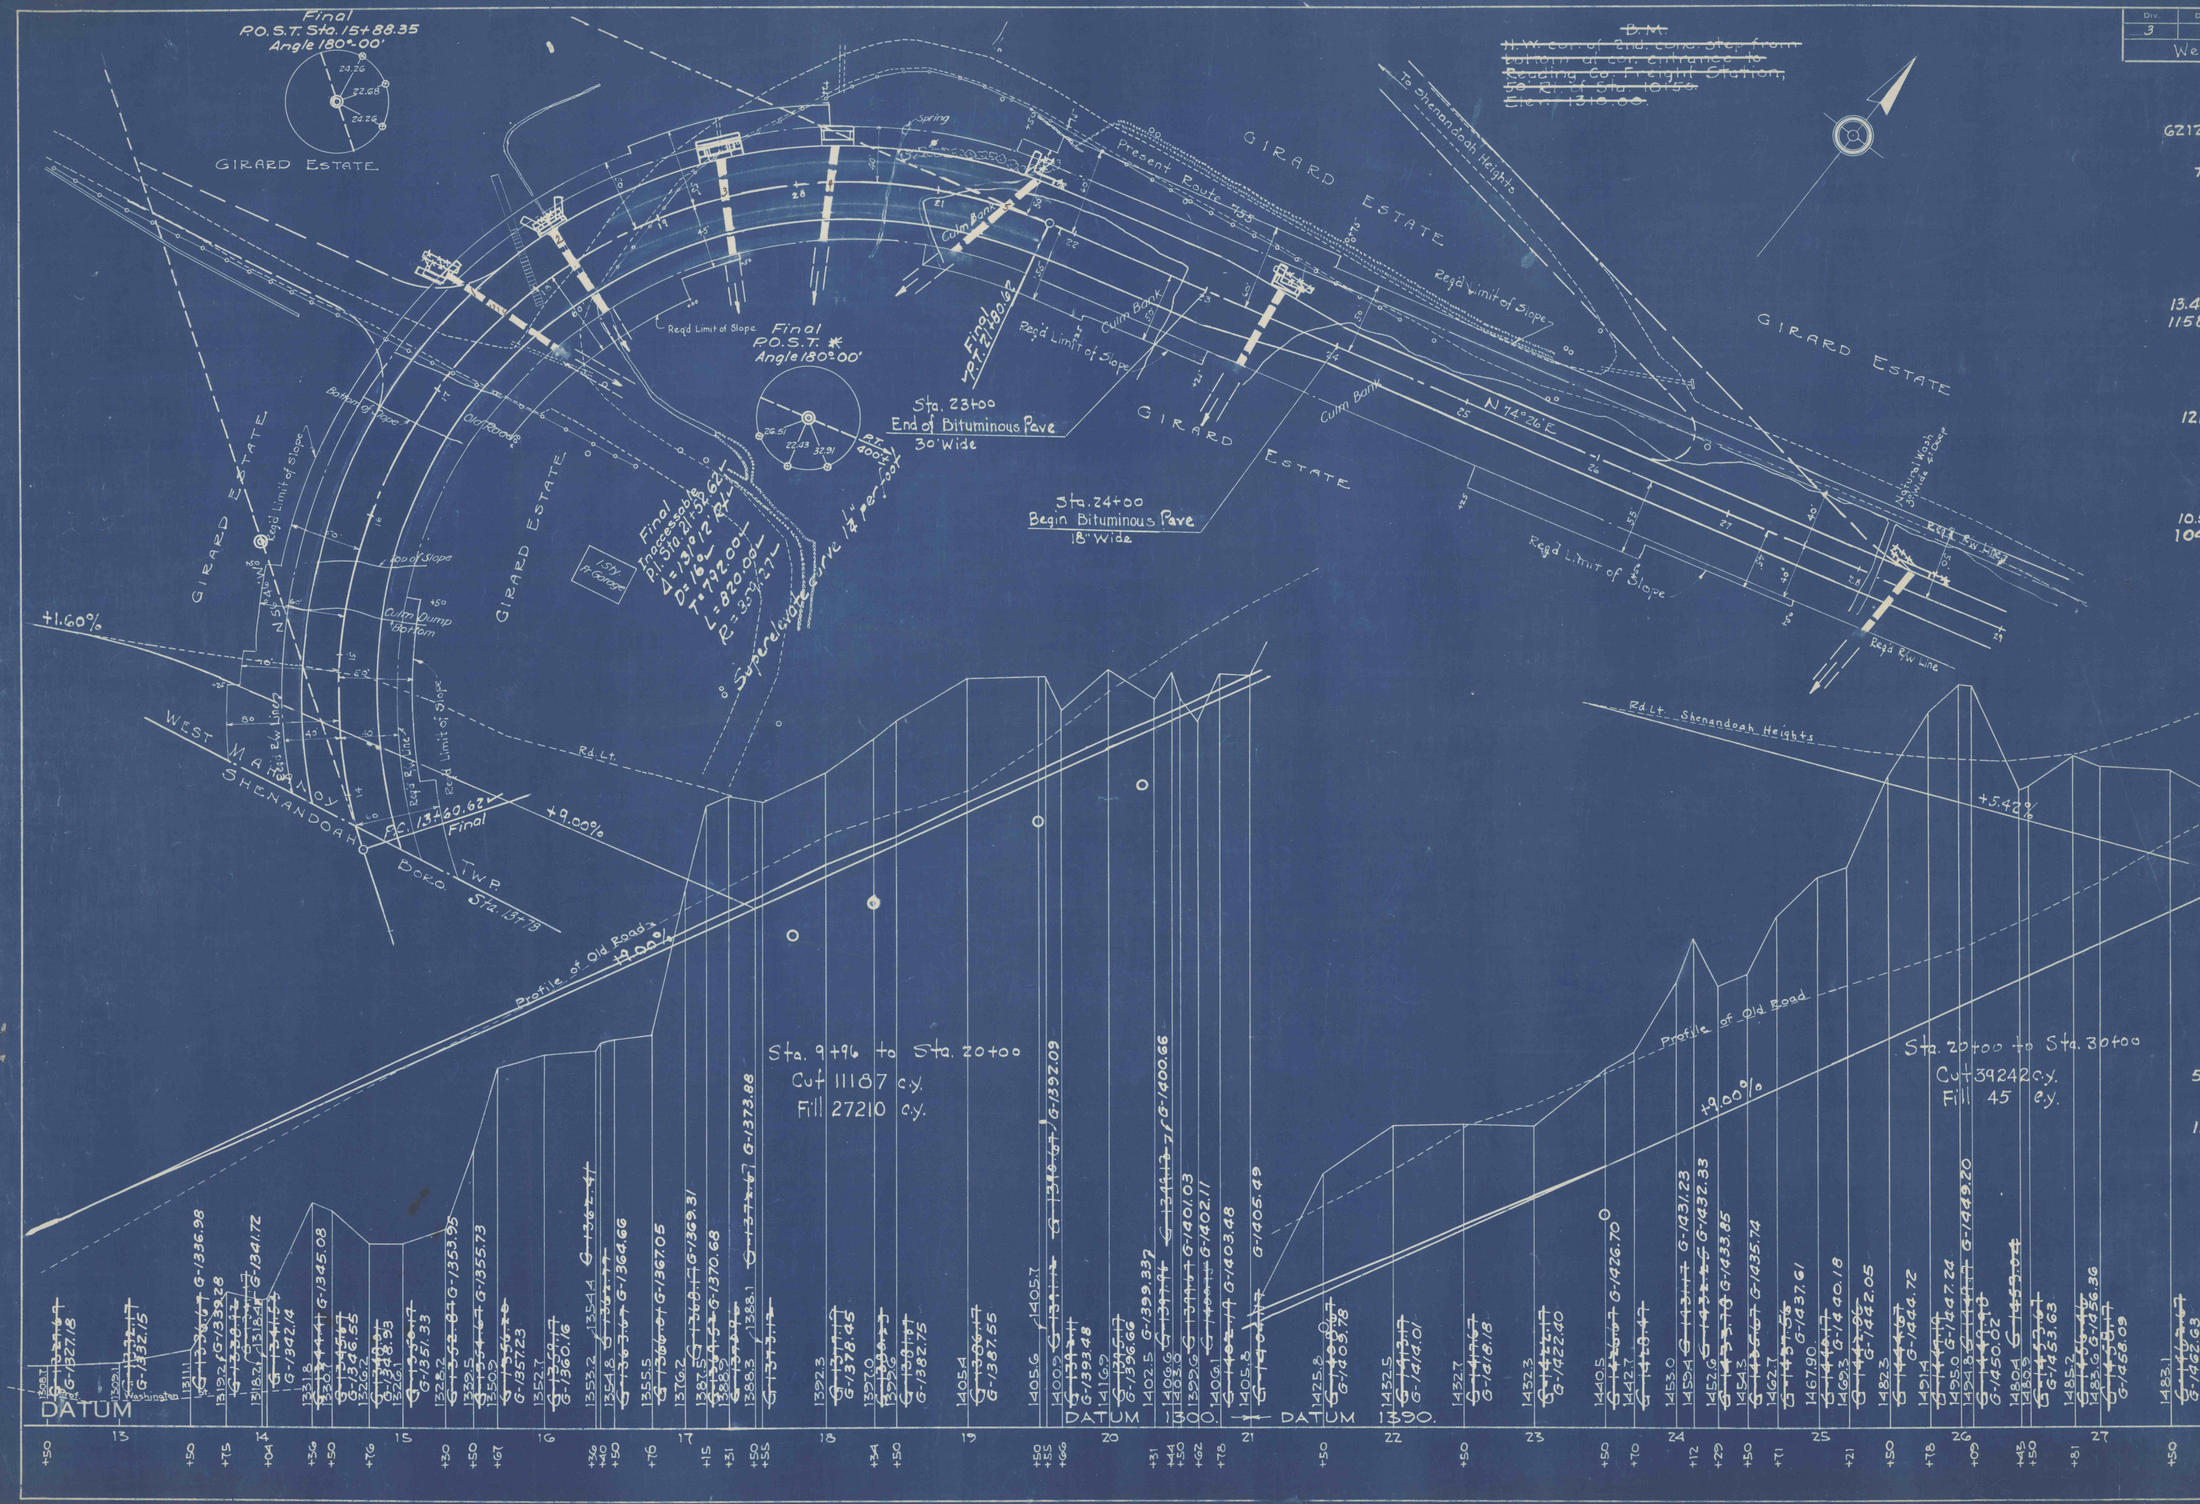

REQUIRED LIST.

Sta. ~~17+50~~ 17+61.47 Final
62 12 ~~6927~~ c.y. ~~Ex.~~ Drive Approach Lt. Cl. I.

Sta. ~~17+70~~ 17+75 Final
75 ~~30'~~ - 36" C.I.P. L.J.
1 - ~~"B-B"~~ Ew. Lt "E-S"
3 ~~250~~ c.y. Ditch Ex.
2.85 C.Y. Cl. "B" Conc.

Sta. ~~18+35~~ 18+33 Final
16'-42" C.I.P. (Lockjoint)
1 - ~~"B-B"~~ Ew. Lt. "B-W"
13.44 ~~11~~ c.y. ~~Stone slope wall~~ (1' thick)
1158 ~~150~~ c.y. Ditch Ex.
3.42 C.Y. Cl. "B" Conc.

Sta. 19+50 Final
72'-18" C.I.P. (Lockjoint)
1 - ~~"A-2"~~ Ew. Lt. "B-B"
121 ~~45~~ c.y. Ditch Ex
3.72 C.Y. Cl. "B" Conc.

Sta. ~~20+25~~ 20+24 Final
72'-36" C.I.P. (Lockjoint)
1 - "B-B" Ew. Lt.
10.50 ~~15~~ c.y. Stone Slope wall (1' thick)
104 ~~50~~ c.y. Ditch Ex.
(Connect stone slope to old pipe)
8.83 C.Y. Cl. "B" Conc.

~~Sta. 20+25 to Sta. 20+75 Lt.~~
~~85 c.y. Grouted Rubble Gutter.~~
~~(Place Gutter from Spring to pipe inlet)~~
Final

Sta. 21+00 to Sta. 34+00 Rt.
(Place 1½:1 slopes in cut)

Sta. ~~21+50~~ 21+30 Final
72'-24" C.I.P. (Lockjoint)
1 - "E" Ew. Lt.
~~12 c.y. Stone slope wall (1' thick) Lt~~
~~10 c.y. " " " " Rt~~
18 ~~75~~ c.y. Ditch Excav.
1.2 C.Y. Cl. "B" Conc.

Sta. ~~21+50~~ 18+50 to Sta. ~~23+00~~ 22+00 Final
~~255~~ 270 lin. ft. 4" tile underdrain Lt.

Sta. ~~23+50~~ 23+42 Final
36'-18" C.I.P. (Lockjoint)
1 - ~~"A-B"~~ Ew. Lt. "E"
~~15 c.y. Stone slope wall (1' thick)~~
~~150~~ c.y. Ditch Ex.
350
1.26 C.Y. Cl. "B" Conc.

Sta. ~~24+50~~ 28+34 Final
~~2415~~ c.y. Ex. Drive Approach Lt. Cl. I.
2969

Sta. ~~28+25~~ 28+30 Final
51 ~~50'~~-30" C.I.P. (Lockjoint)
1 ~~"B-B"~~ Ew. on Lt "B"
~~10 c.y. Stone slope wall (1' thick)~~
12 ~~50~~ c.y. Ditch Ex.
1.13 C.Y. Cl. "B" Conc.

~~Sta. 26+00~~ Final
~~10 c.y. Pipe removal~~

Contractor to handle grading and paving in such a manner so that road approach at 17+50 or 27+50 will be kept open at all times to provide traffic entrance and exit at Hospital.

Sta. ~~23+47.5~~ 23+47.8 to Sta. ~~24+75~~ 24+47.8 Final
Flare pave from 30' to 18'
~~65~~ s.y. Bituminous Surf. Course.
~~87~~ s.y. Base Course.

Sta. 17+00 to Sta. 19+66 Final
Daylight Curve on Rt.
~~1007~~ Cu. Yds. Excav. Class

Sta. 16+00 Final
116 C.Y. Fill Road Approach