


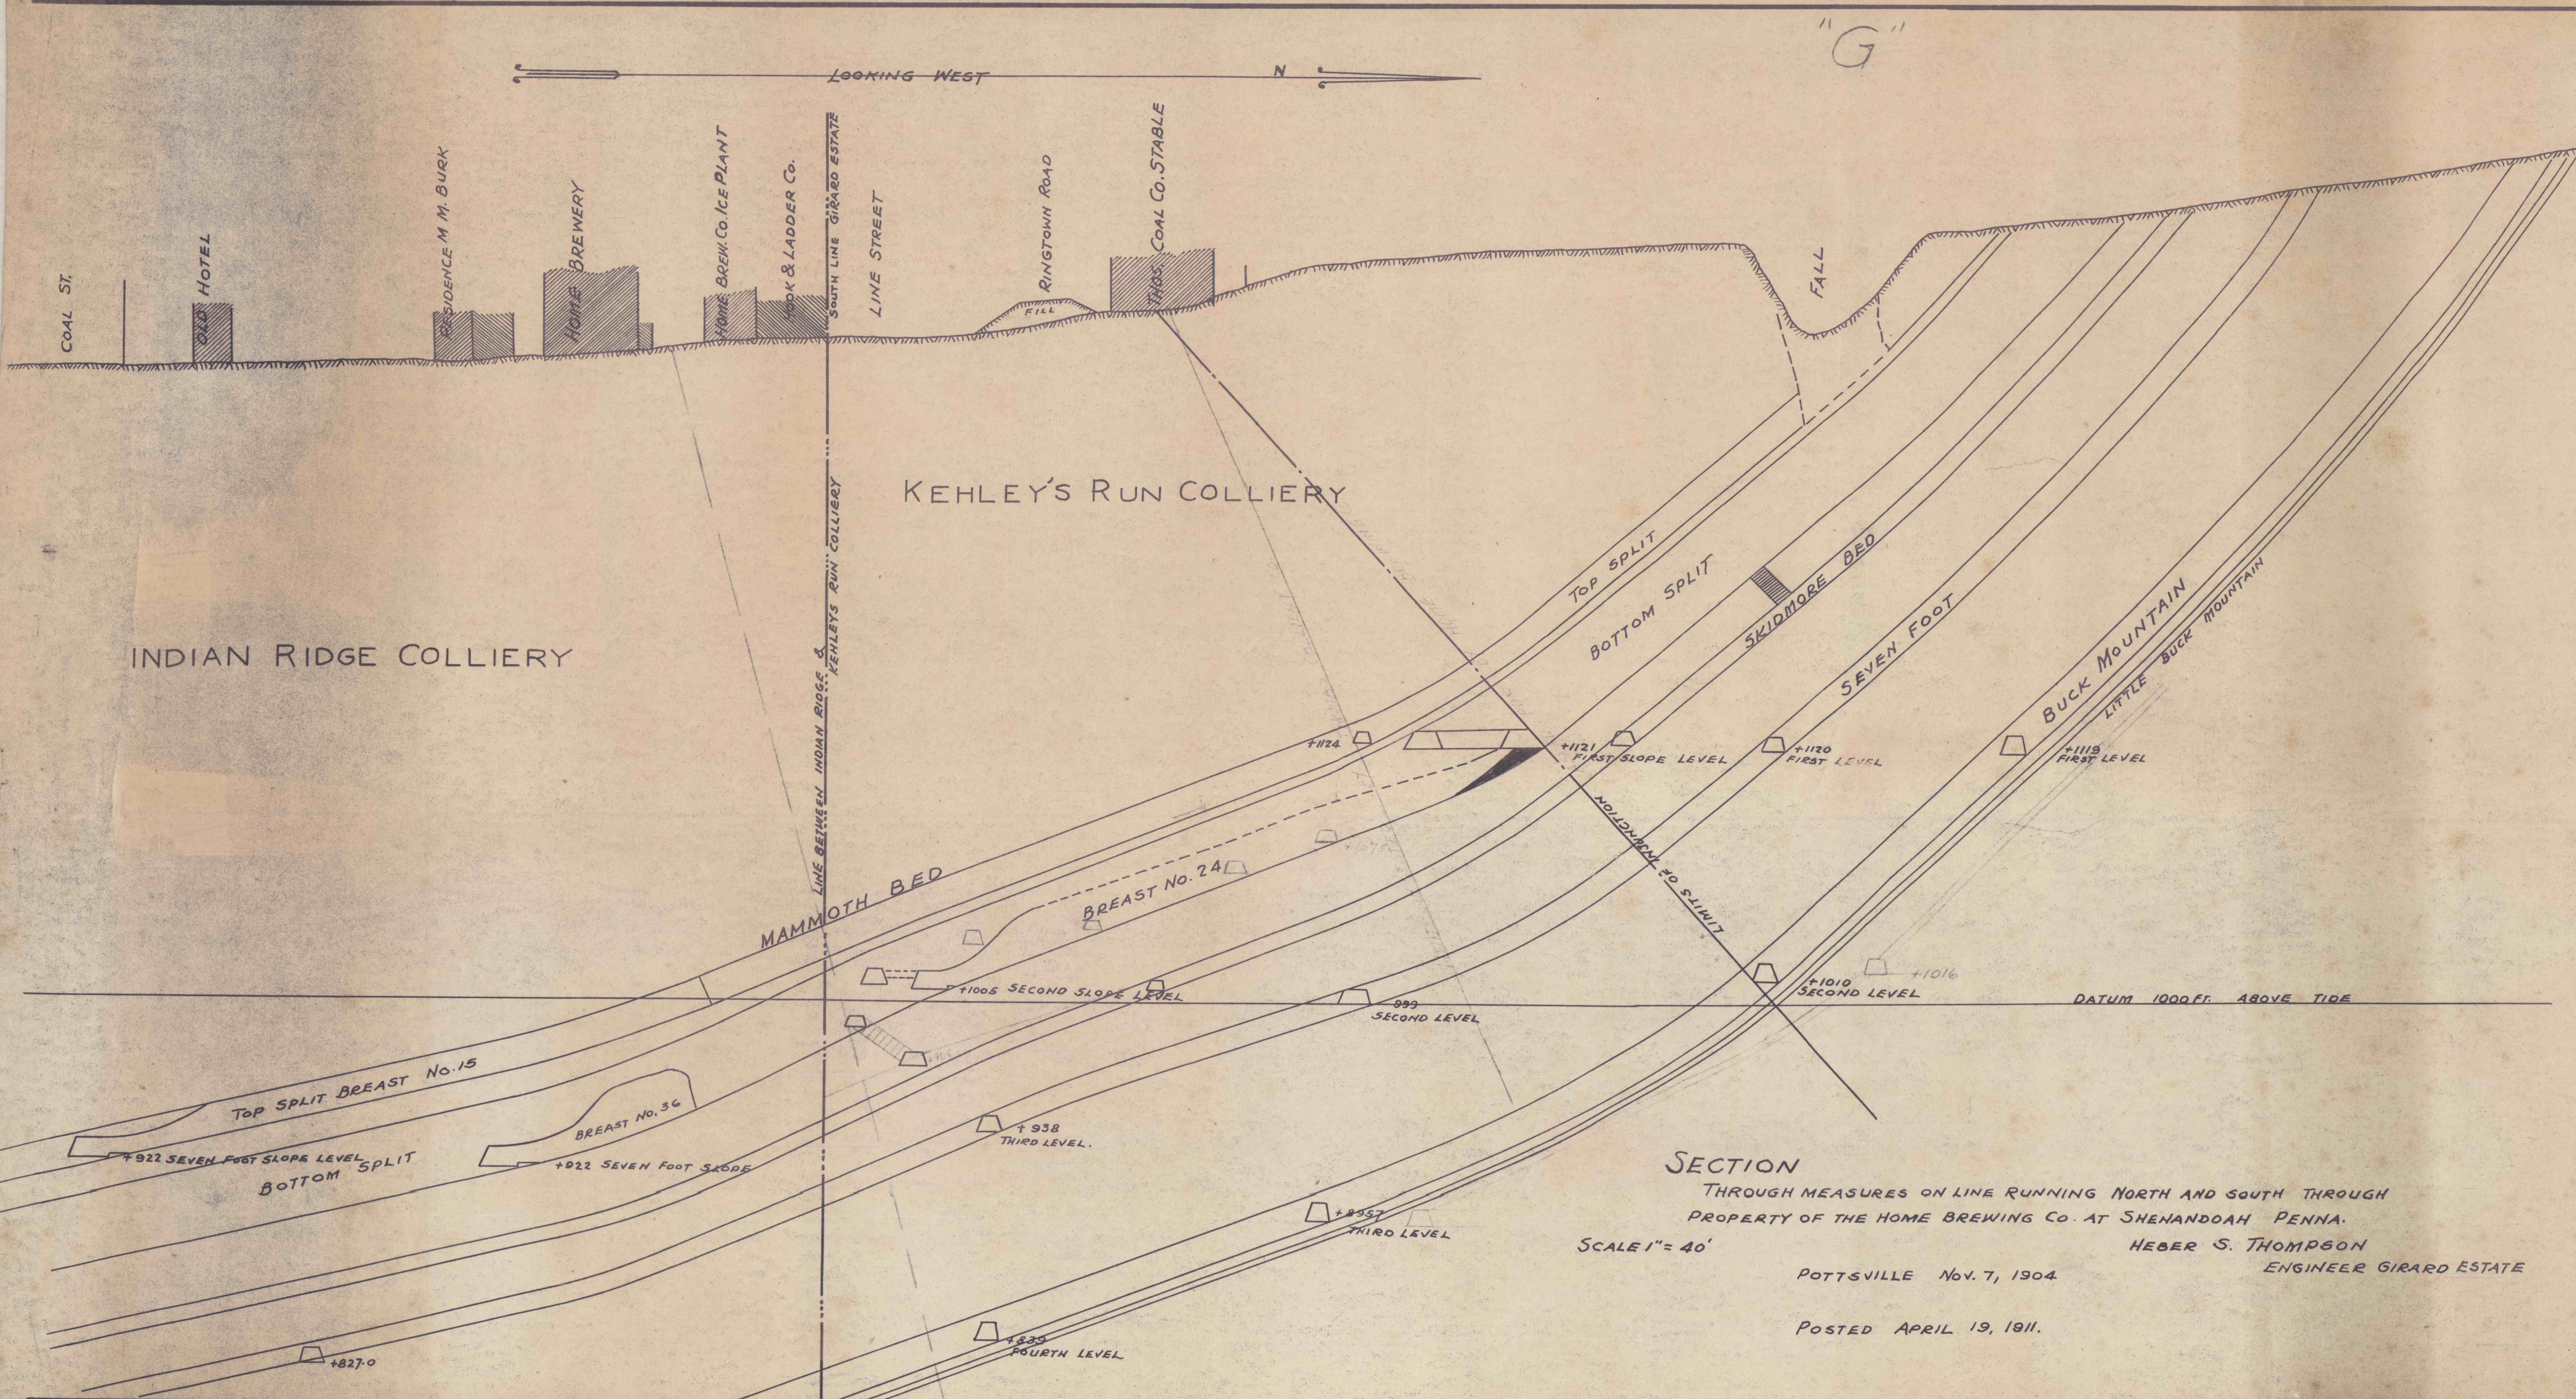

"G"

SECTION

THROUGH MEASURES ON LINE RUNNING NORTH AND SOUTH THROUGH
PROPERTY OF THE HOME BREWING CO. AT SHENANDOAH PENNA.

SCALE 1" = 40'

HEBER S. THOMPSON
ENGINEER GIRARD ESTATE

POTTSVILLE NOV. 7, 1904.

POSTED APRIL 19, 1911.