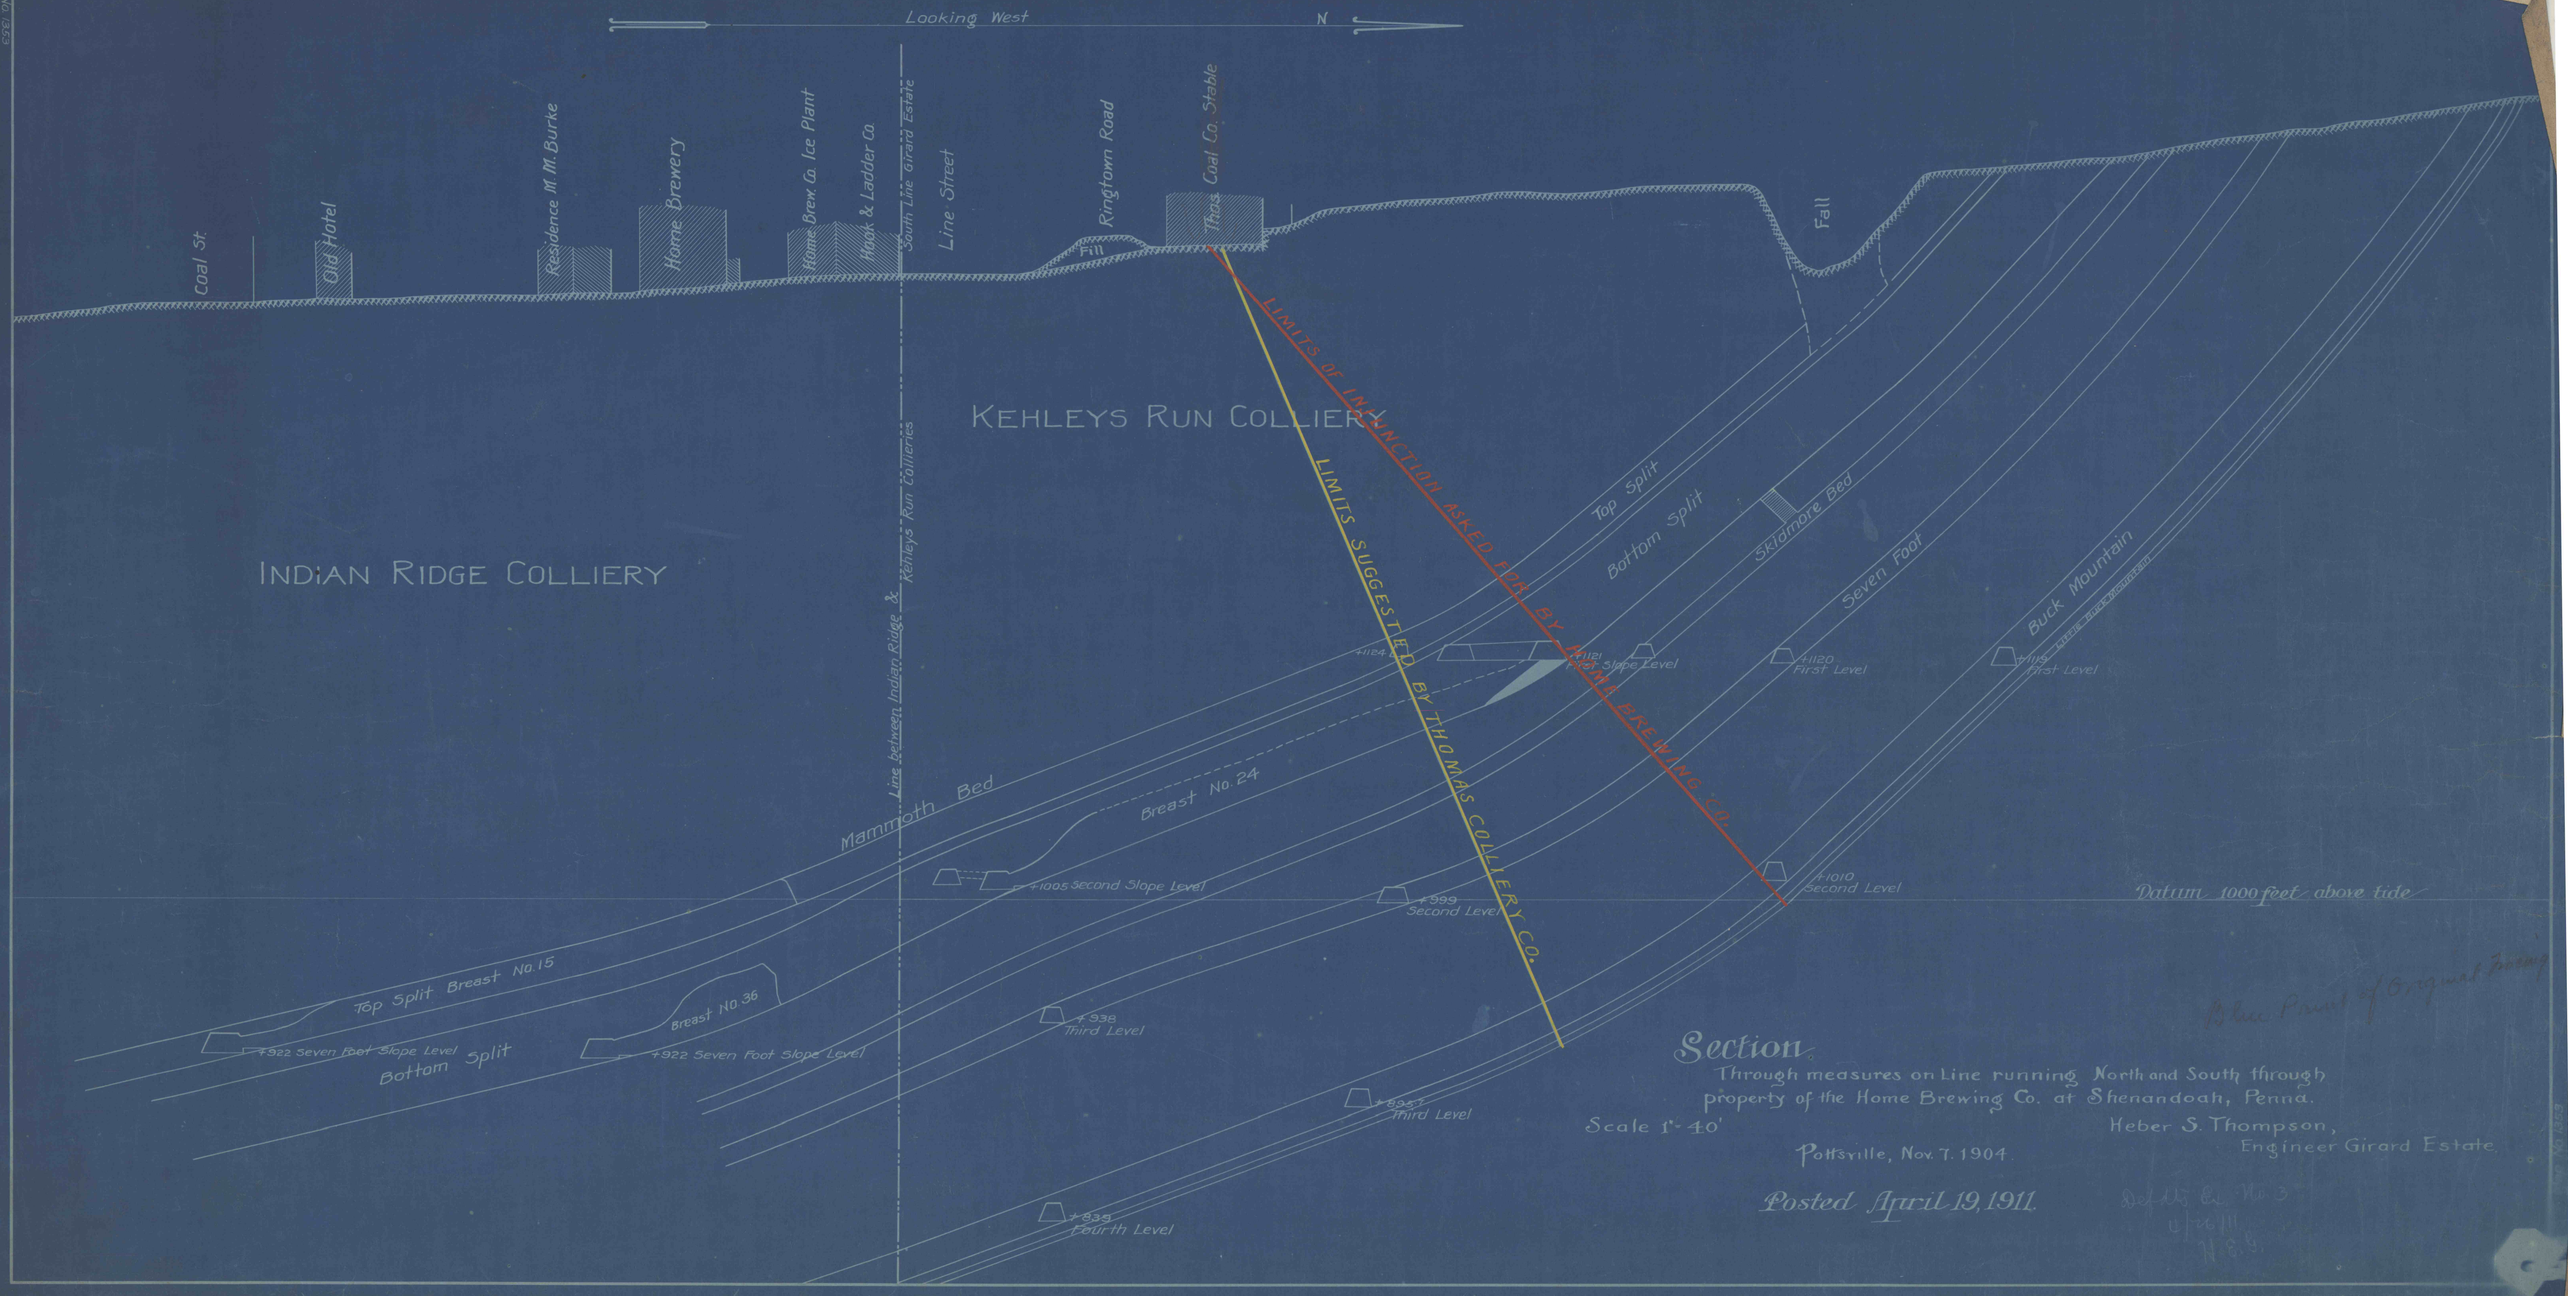
Map No. 1365
Looking West
N
Coal St.
Old Hotel
Residence M. M. Burke
Home Brewery
Home Brew Co. Ice Plant
Hook & Ladder Co.
South Line Girard Estate
Line Street
Ringtown Road
Fill
Thos. Coal Co. Stable
Fall
KEHLEYS RUN COLLIERY
INDIAN RIDGE COLLIERY
Line between Indian Ridge & Kehleys Run Collieries
LIMITS OF INJUNCTION ASKED FOR BY HOME BREWING CO.
LIMITS SUGGESTED BY THOMAS COLLIERY CO.
Top Split
Bottom Split
Skidmore Bed
Seven Foot
Buck Mountain
+1121 First Slope Level
+1120 First Level
+1115 First Level
Mammoth Bed
Breast No. 24
+1005 Second Slope Level
+999 Second Level
+1010 Second Level
Datum 1000 feet above tide
Top Split Breast No. 15
+922 Seven Foot Slope Level
Bottom Split
Breast No. 36
+922 Seven Foot Slope Level
+938 Third Level
+895.7 Third Level
+839 Fourth Level
Blue Print of Original Drawing
Section.
Through measures on Line running North and South through property of the Home Brewing Co. at Shenandoah, Penna.
Scale 1" = 40'
Heber S. Thompson,
Engineer Girard Estate.
Pottsville, Nov. 7. 1904.
Posted April 19, 1911.
Defts Ex. No. 3
4/26/11
N.S.G.