


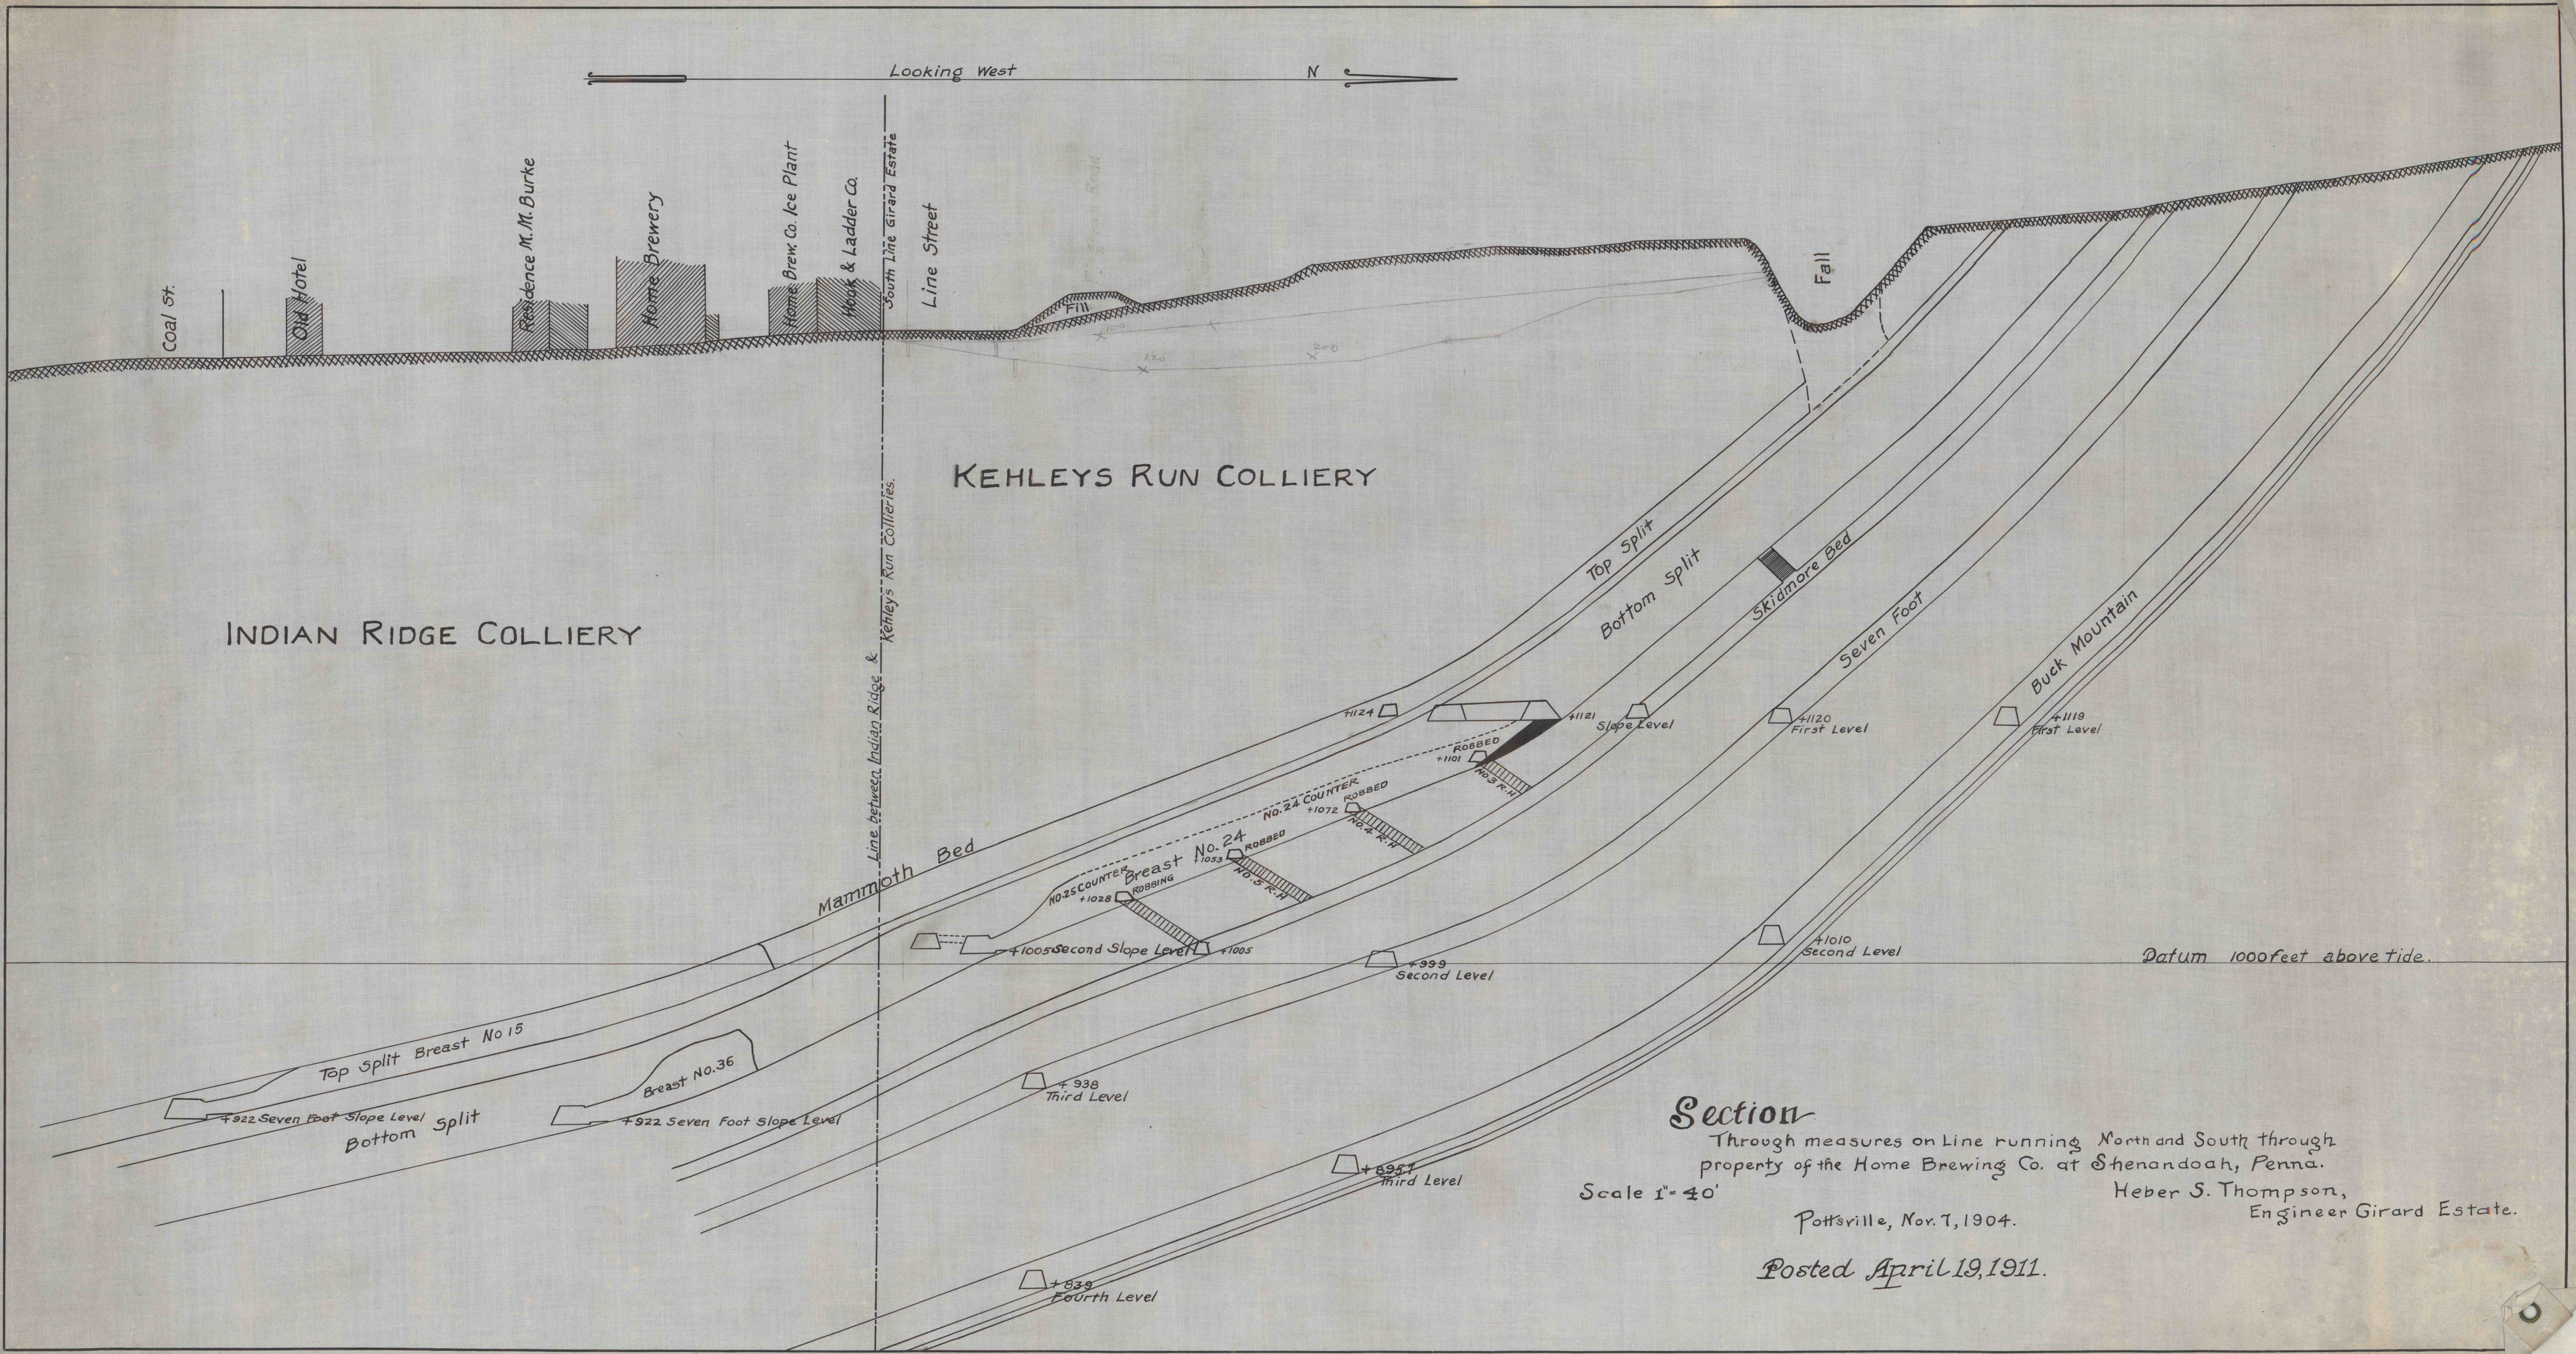

Looking West

N

INDIAN RIDGE COLLIERY

KEHLEYS RUN COLLIERY

Section

Through measures on Line running North and South through property of the Home Brewing Co. at Shenandoah, Penna.
Scale 1"=40'
Pottsville, Nov. 7, 1904.
Heber S. Thompson,
Engineer Girard Estate.
Posted April 19, 1911.