


SECTION No. 7

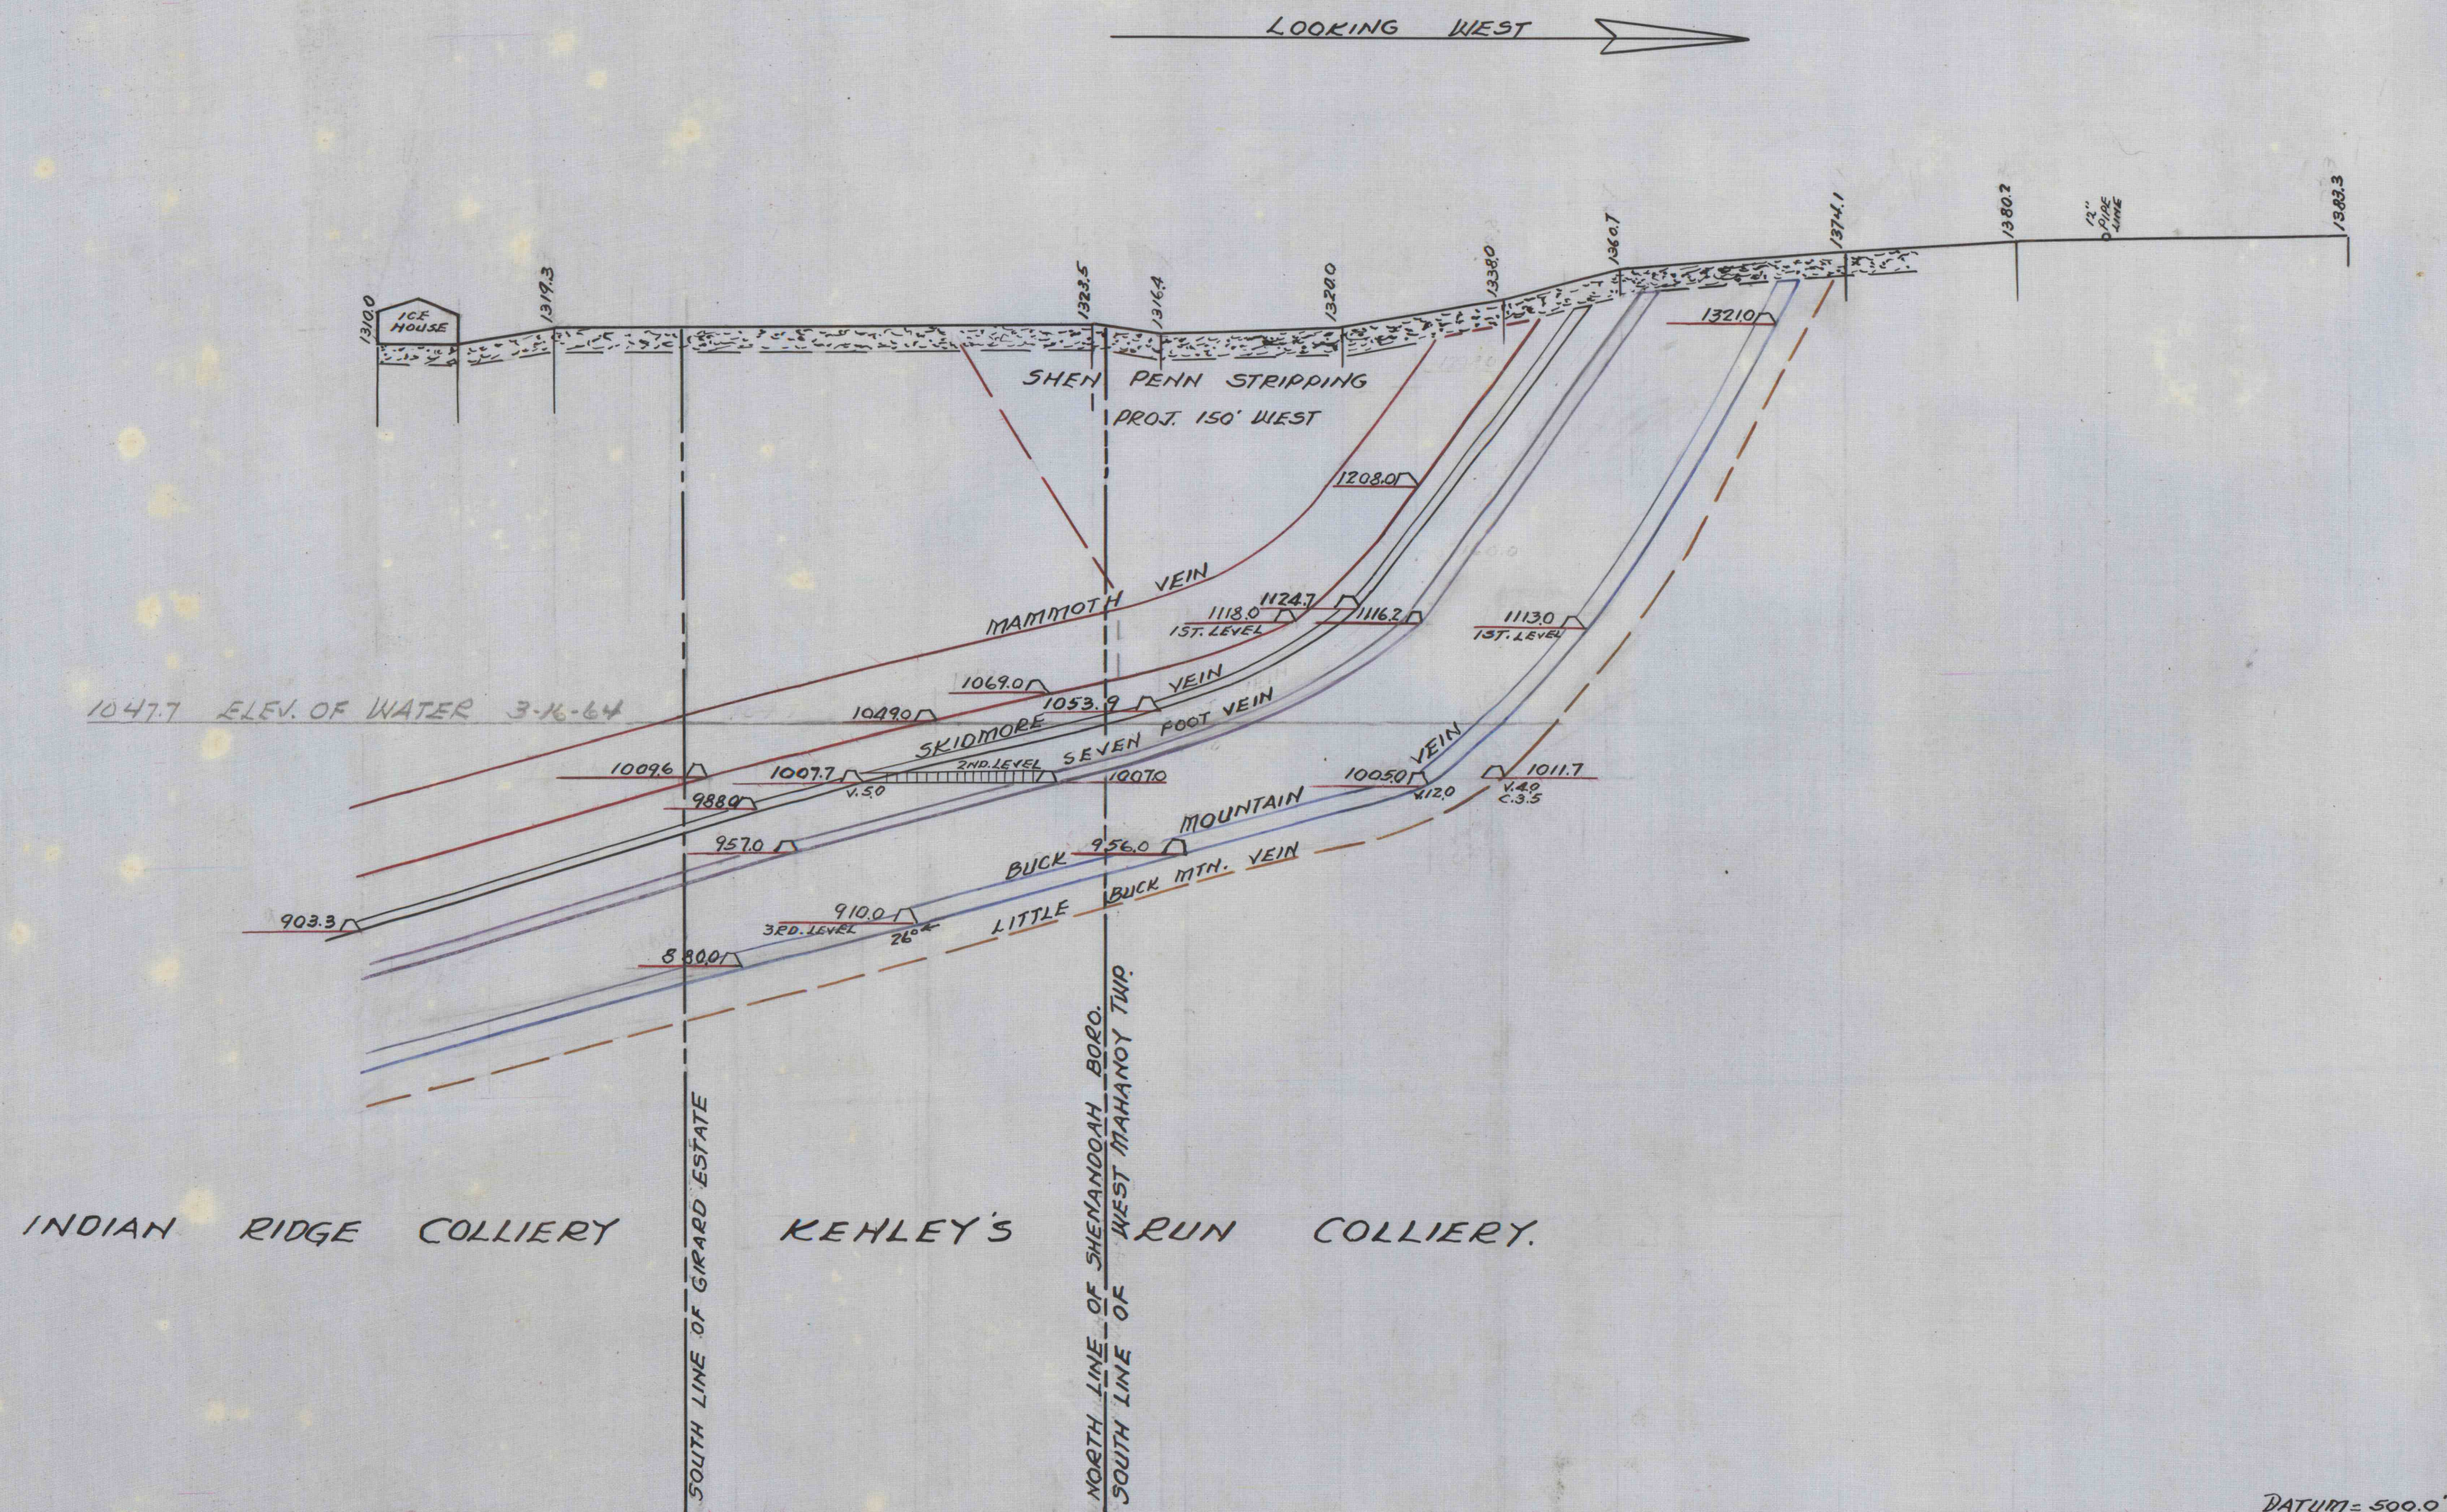

KEHLEY'S RUN COLLIERY

CROSS SECTION THRU WEST LINE OF PHILADELPHIA AND READING CORPORATION DEED - APPROXIMATELY 60' WEST OF THE PIPE LINE OF THE MUNICIPAL AUTHORITY OF THE BOROUGH OF SHENANDOAH.

Scale 1"=100'

GIRARDVILLE, PENNA.

MARCH 17, 1964.

800' EAST OF SLOPE