


N^o 6

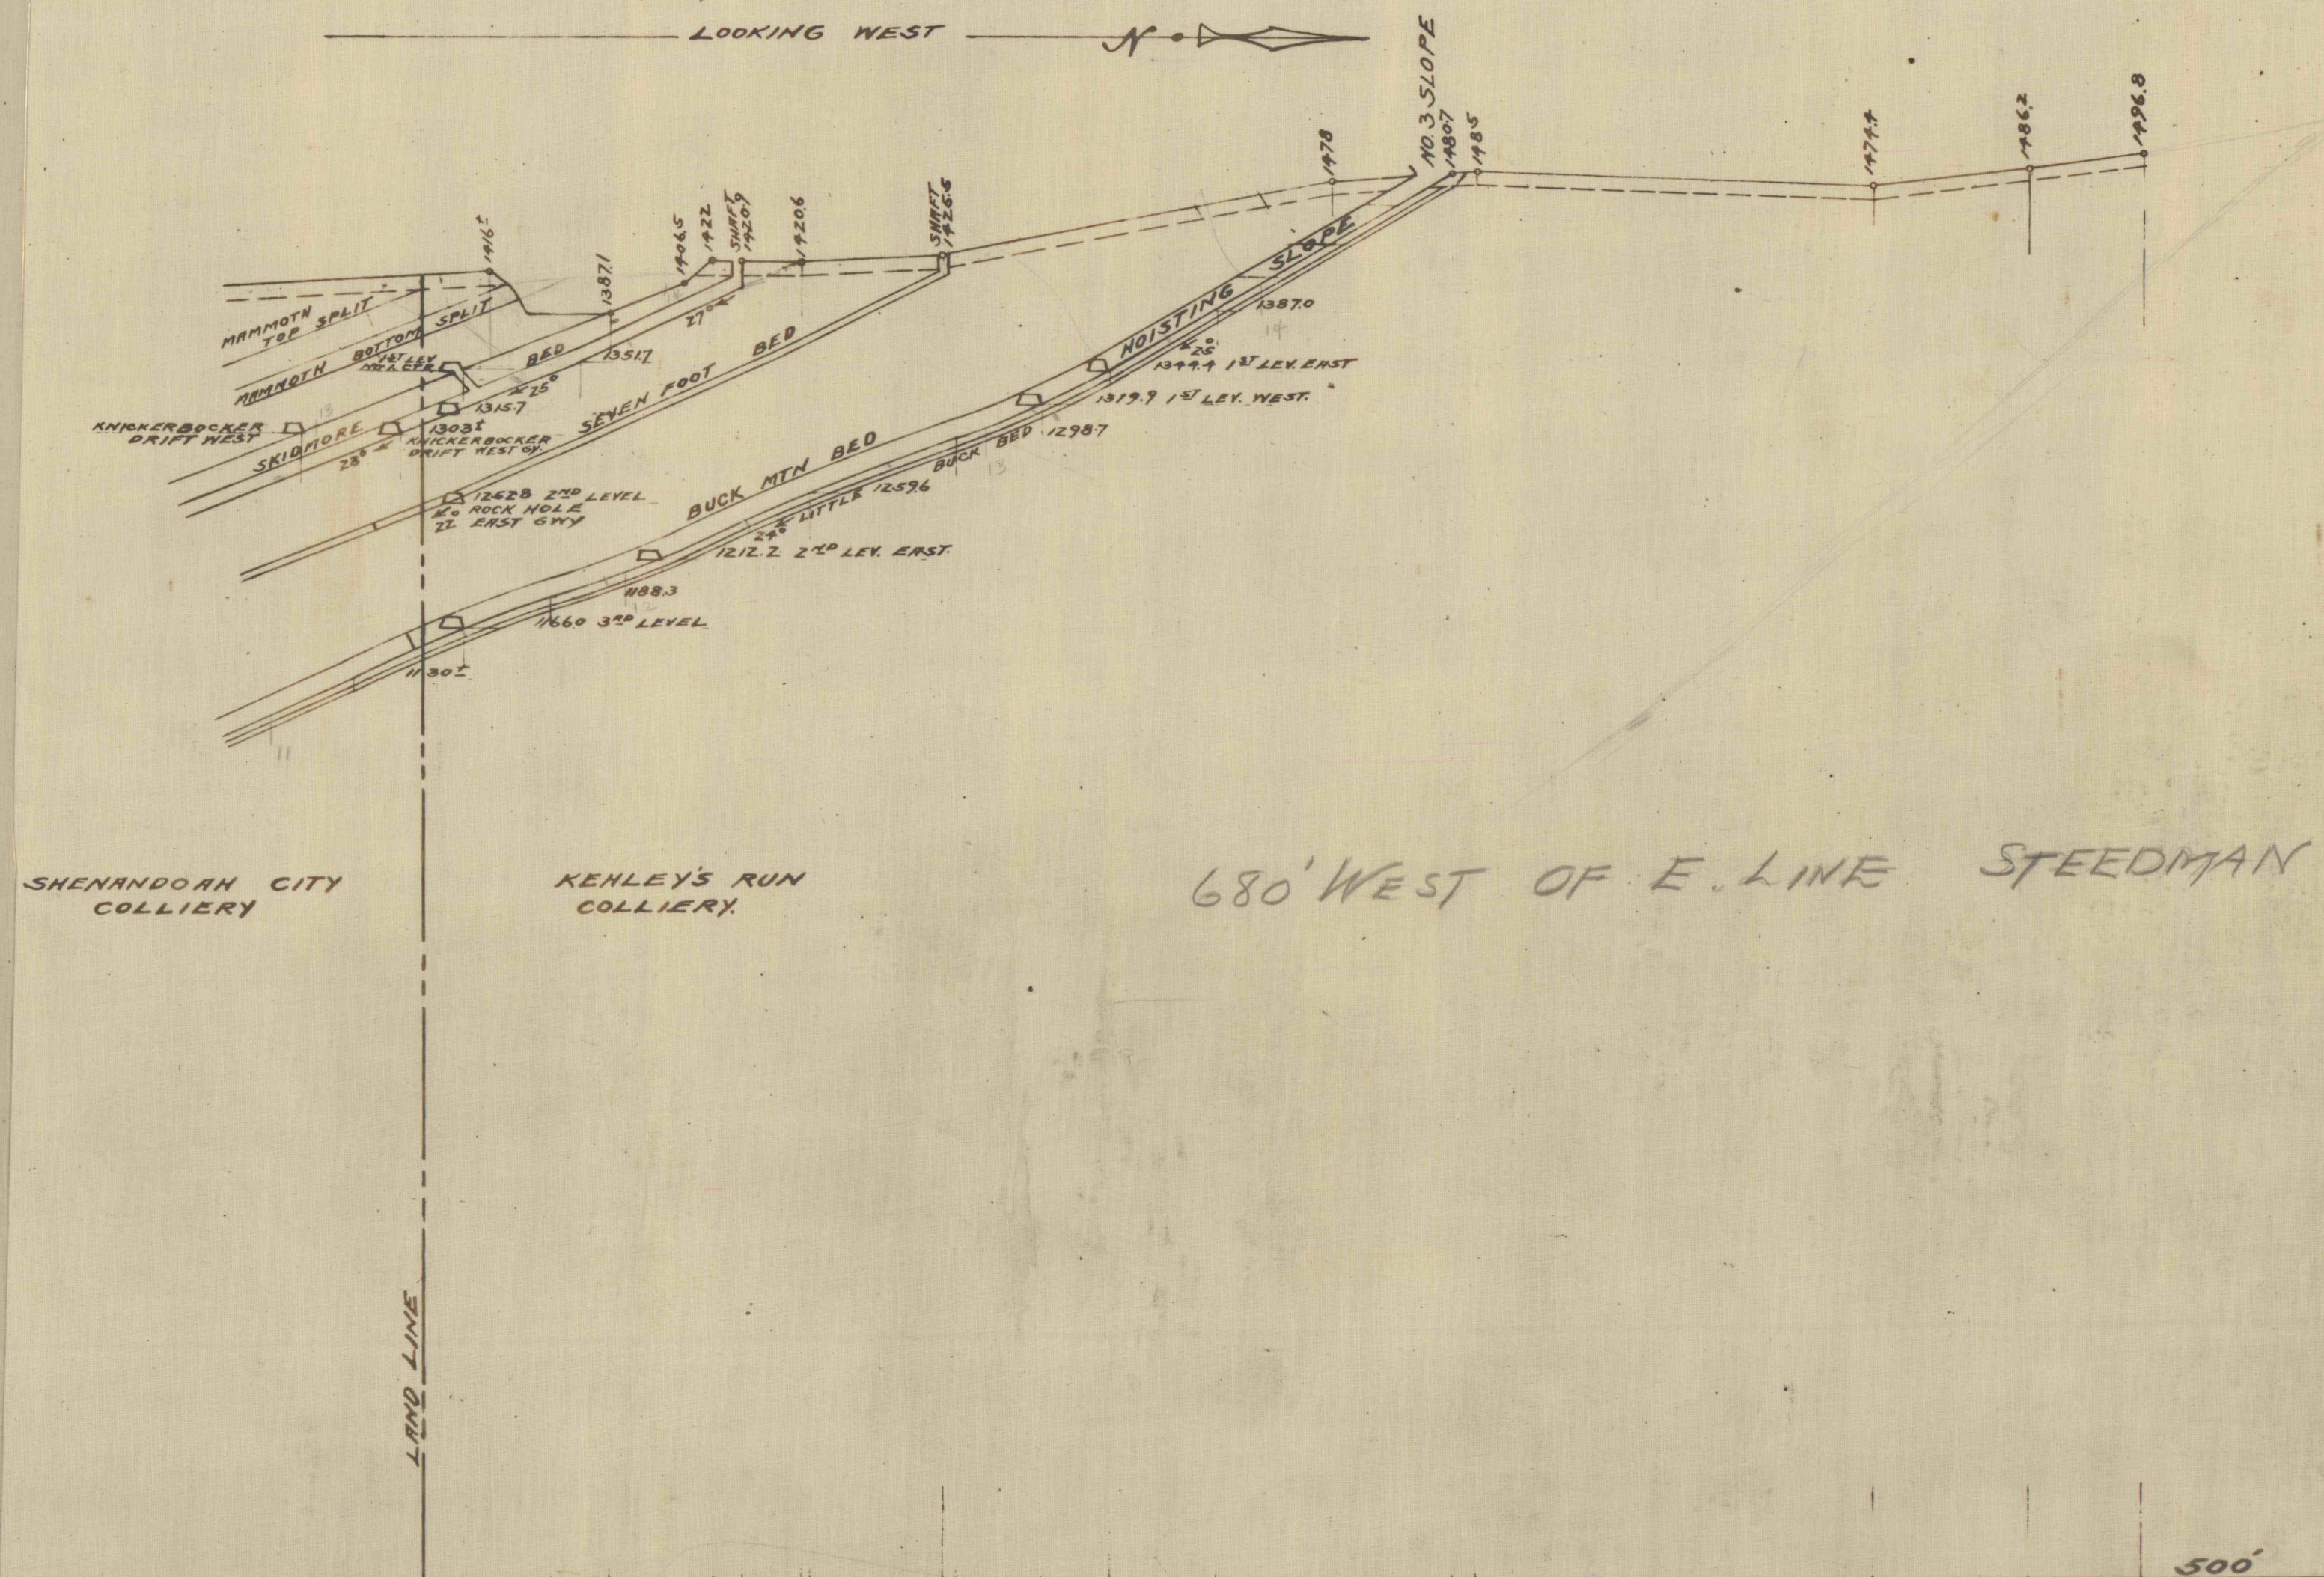

KEHLEY'S RUN COLLIERY.
 CROSS SECTION ON CENTRE LINE OF NO. 3 BUCK MTN SLOPE
 SCALE 1" = 100'
 FRACKVILLE, PENNA. THOMAS COLLIERY COMPANY, JUN. 6-1917
 SHENANDOAH, PENNA.