


3

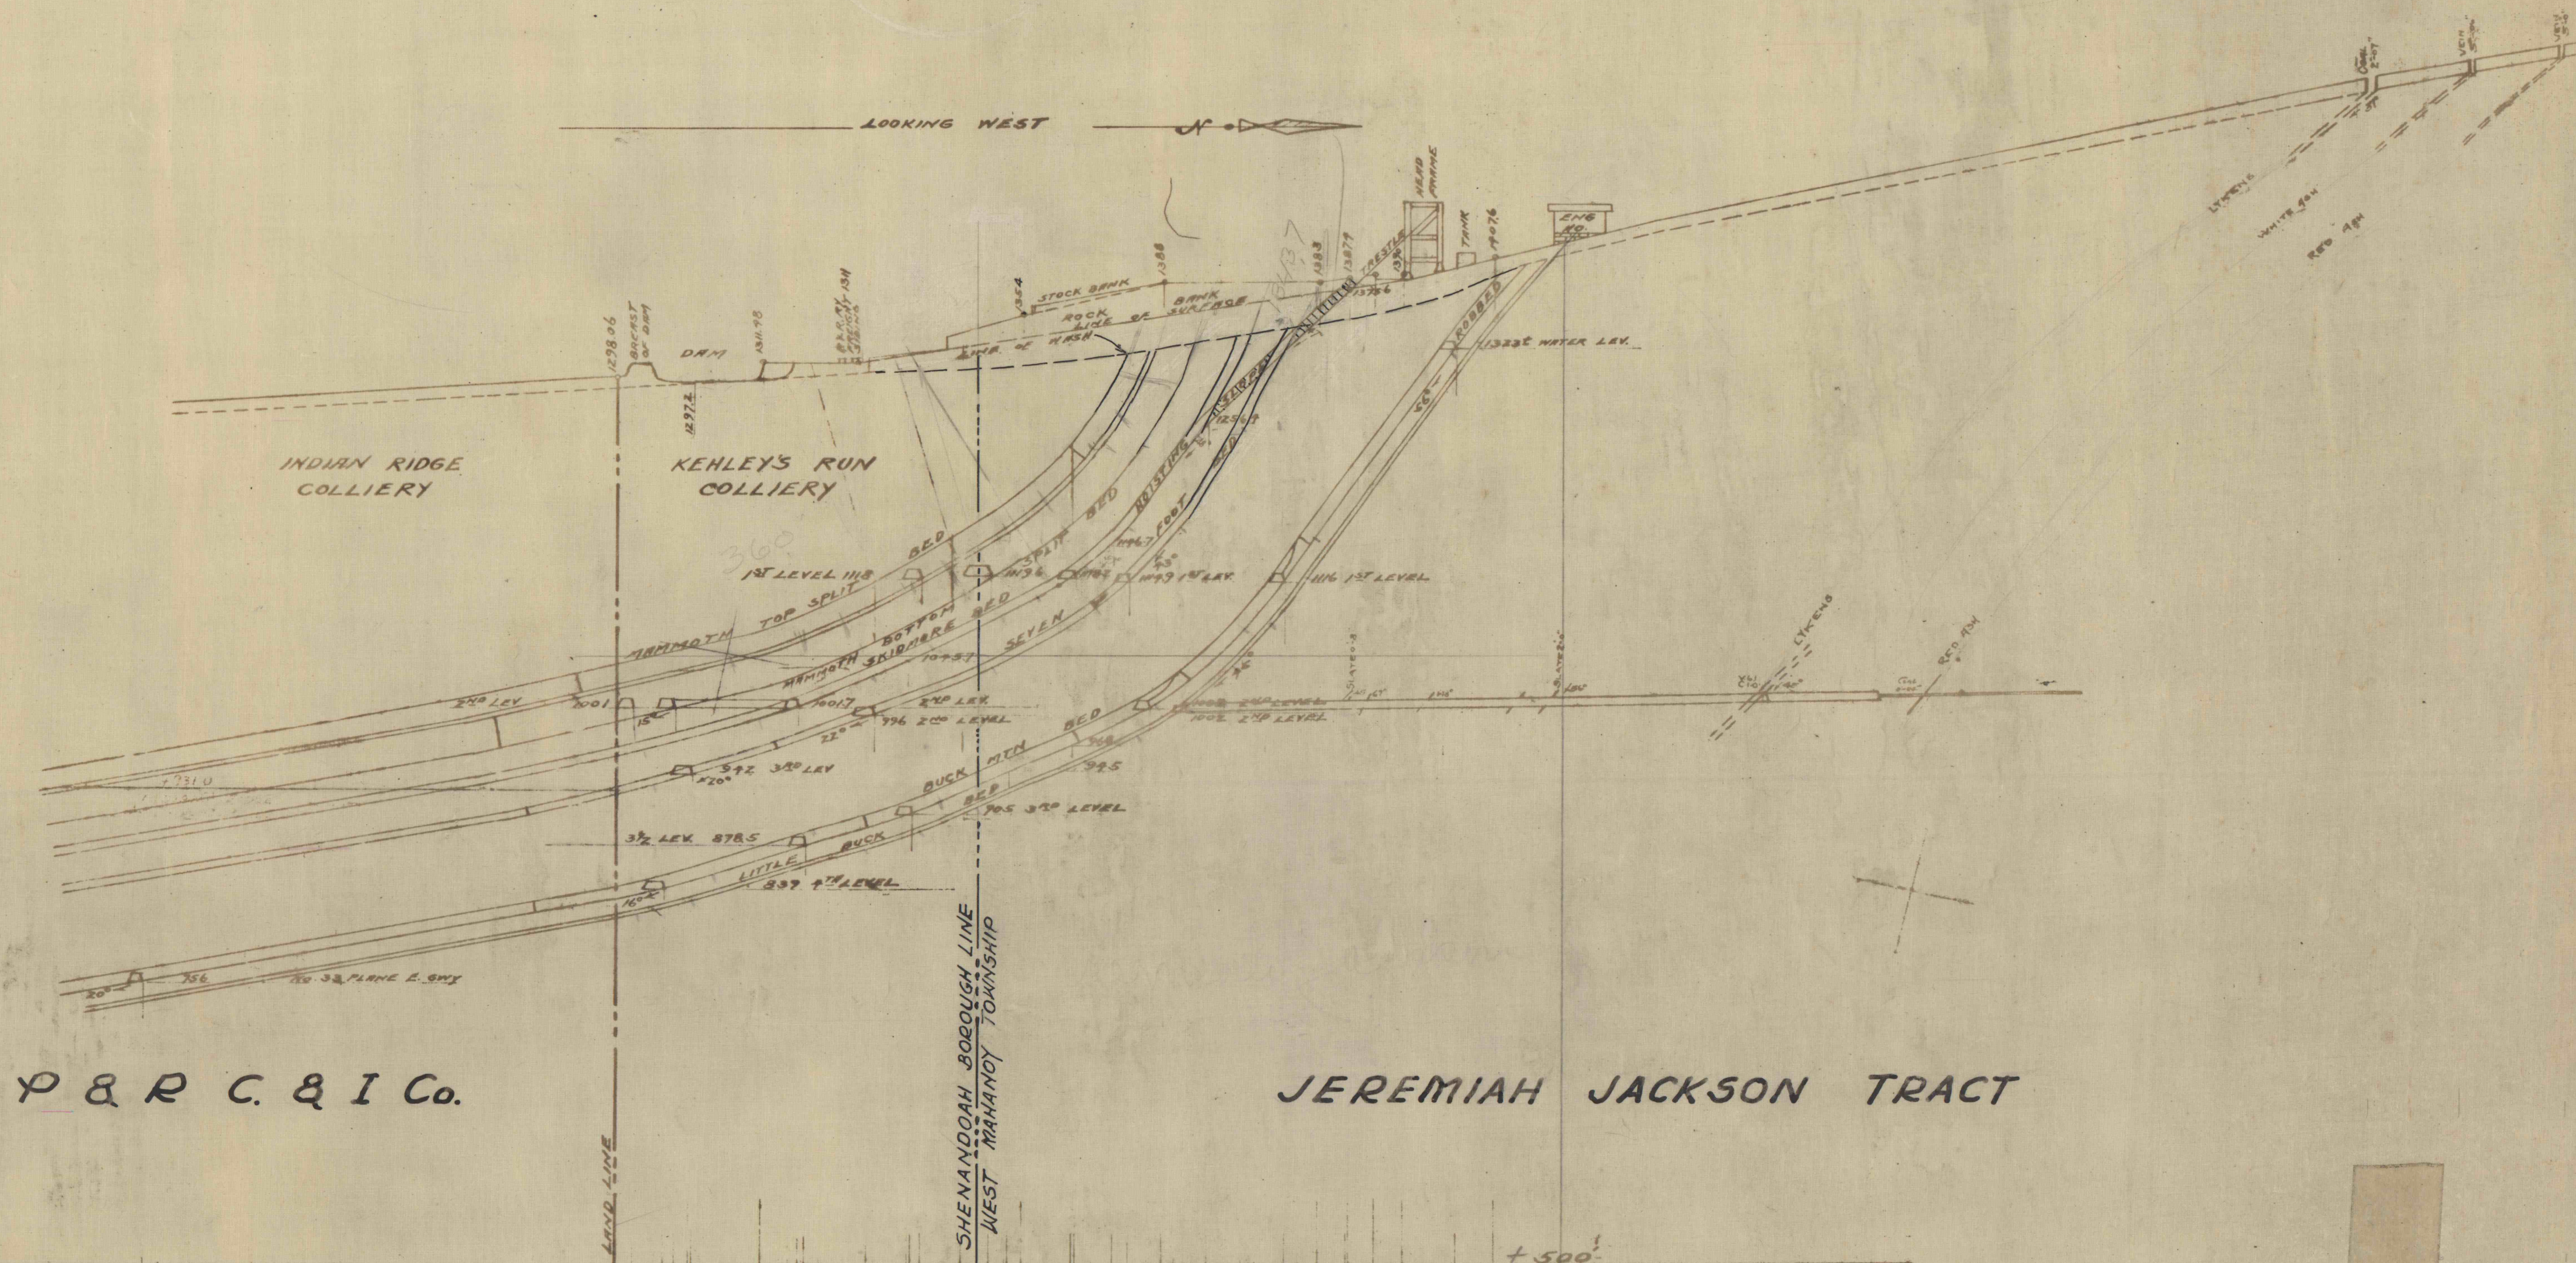

P & R C. & I Co.

JEREMIAH JACKSON TRACT

KEHLEYS RUN COLLIERY
CROSS SECTION THROUGH MAIN SKIDMORE HOISTING SLOPE.
SCALE 1" = 100'

FRACKVILLE, PENNA. THOMAS COLLIERY COMPANY
SHENANDOAH, PA. JUNE 5-1917