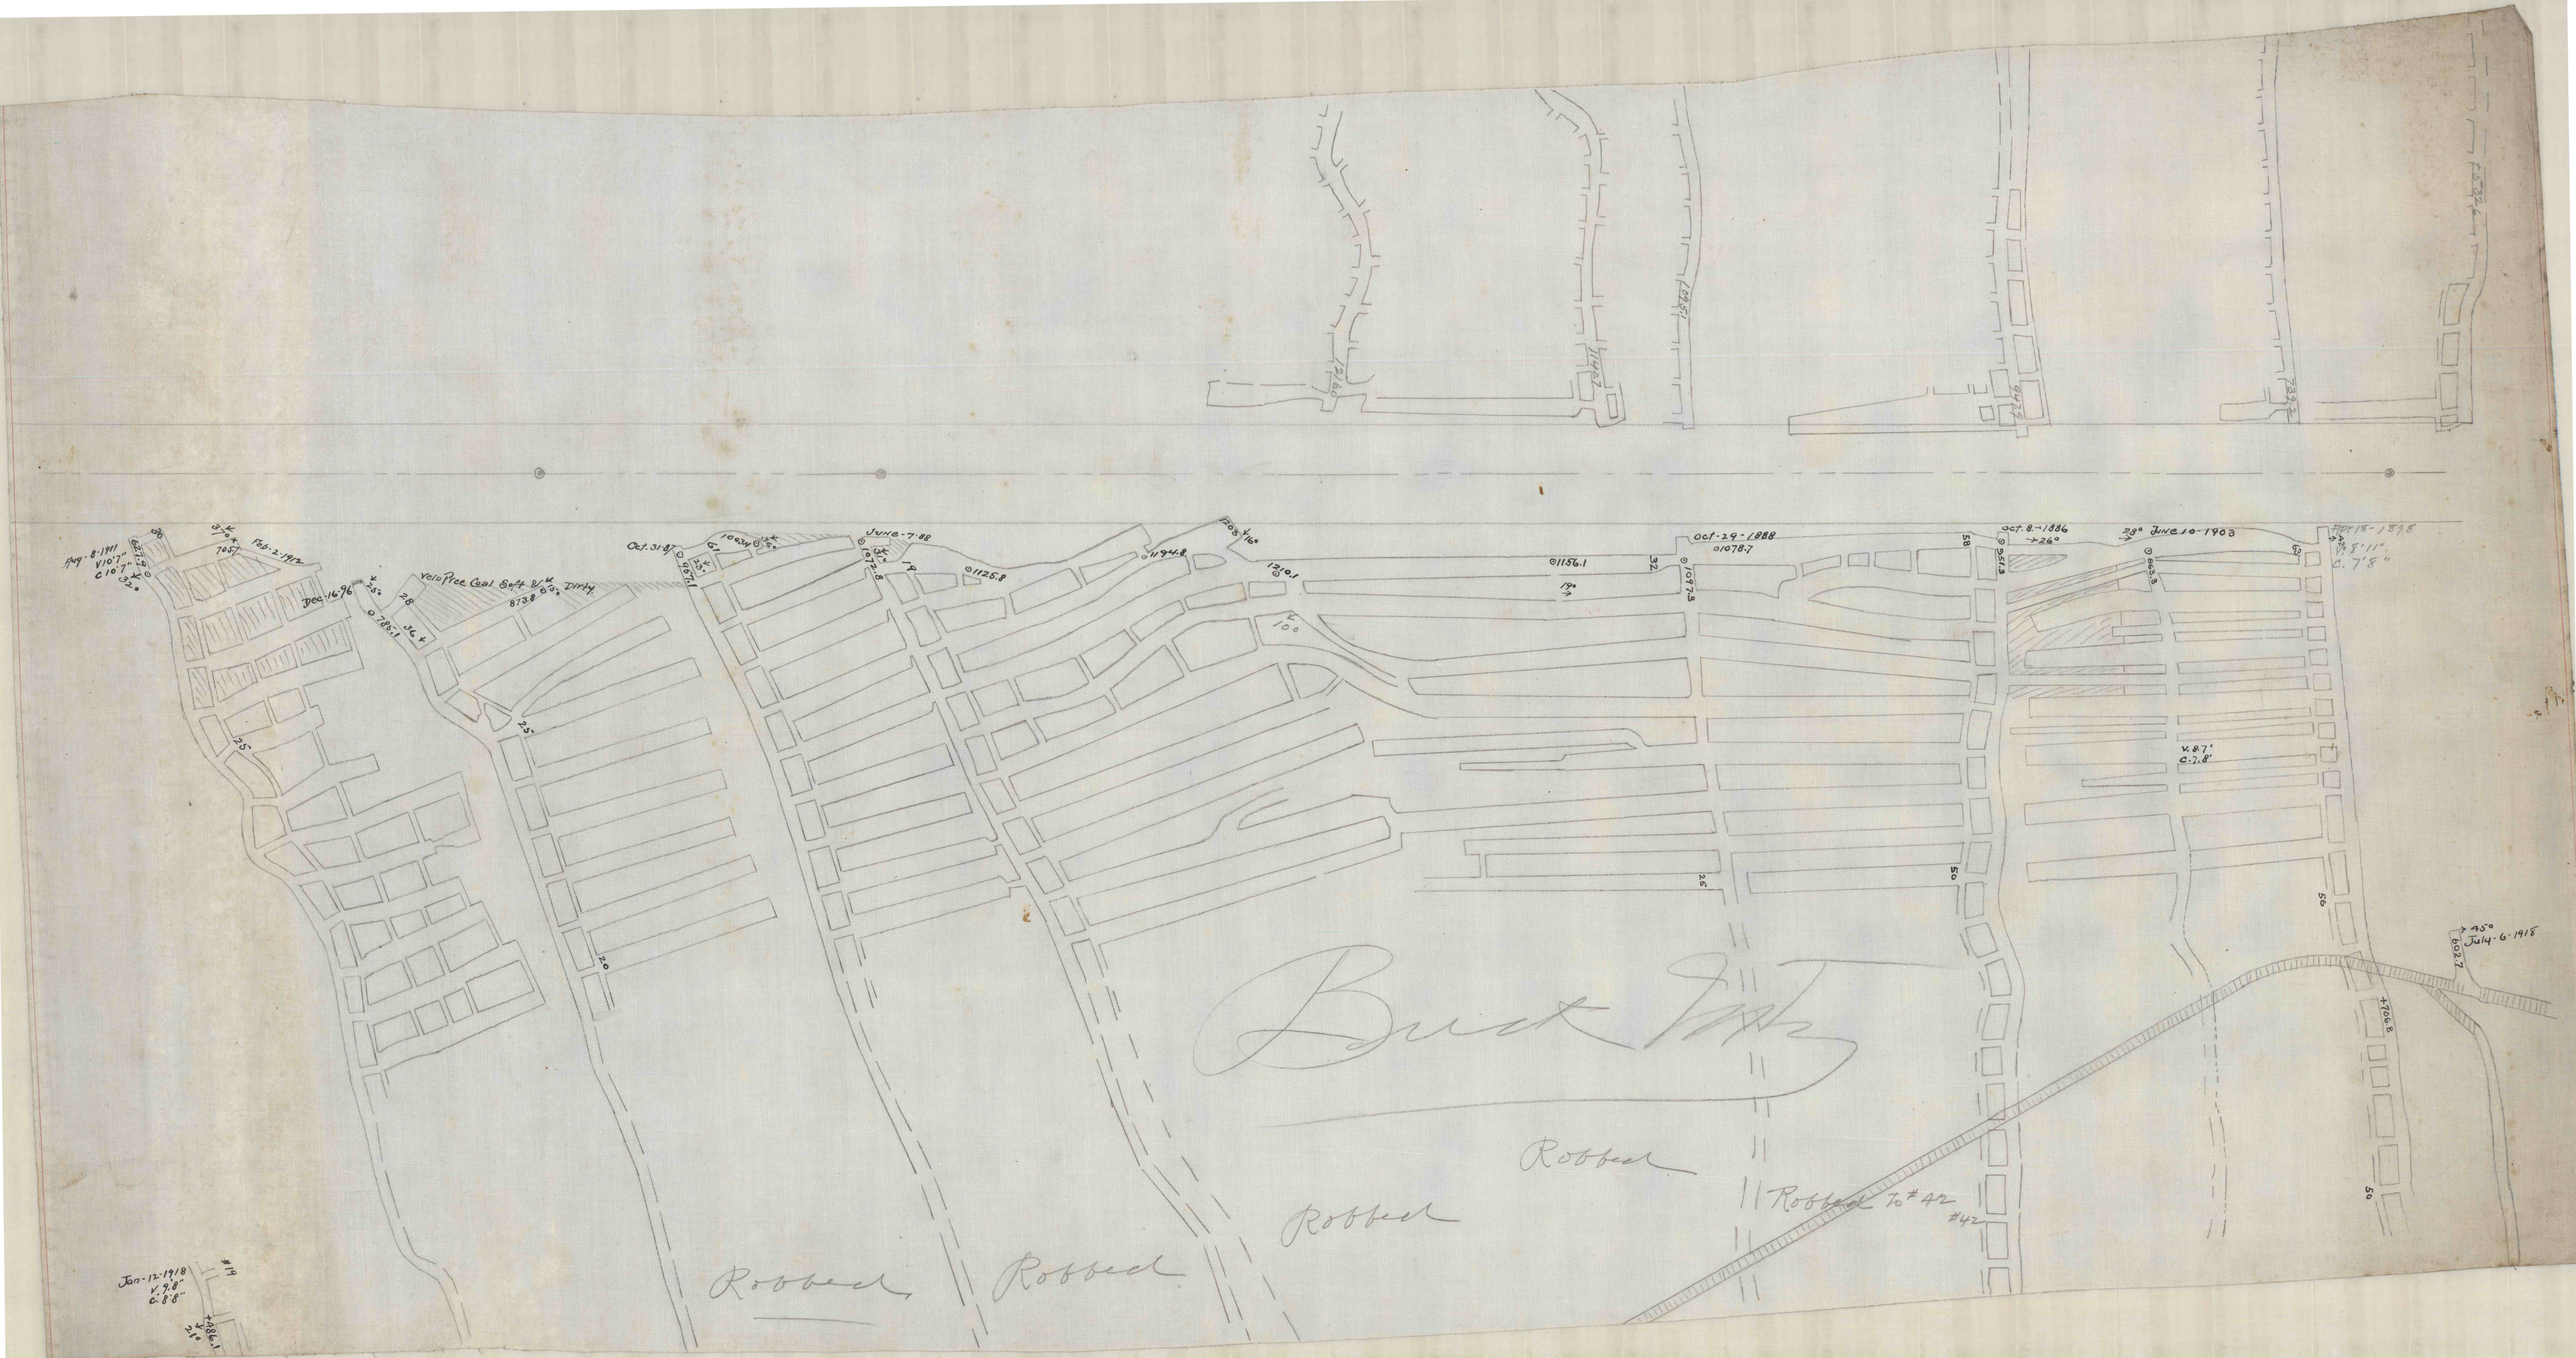
Aug-8-1911
Feb-2-1912
Dec-16-96
Very Free Coal Soft & Dirty
Oct. 31-8
June-7-88
Oct-29-1888
Oct-8-1886
June 10-1903
Apr 18-1898
Jan-12-1918
July-6-1918
Robbed
Robbed
Robbed
Robbed To #42
#42