


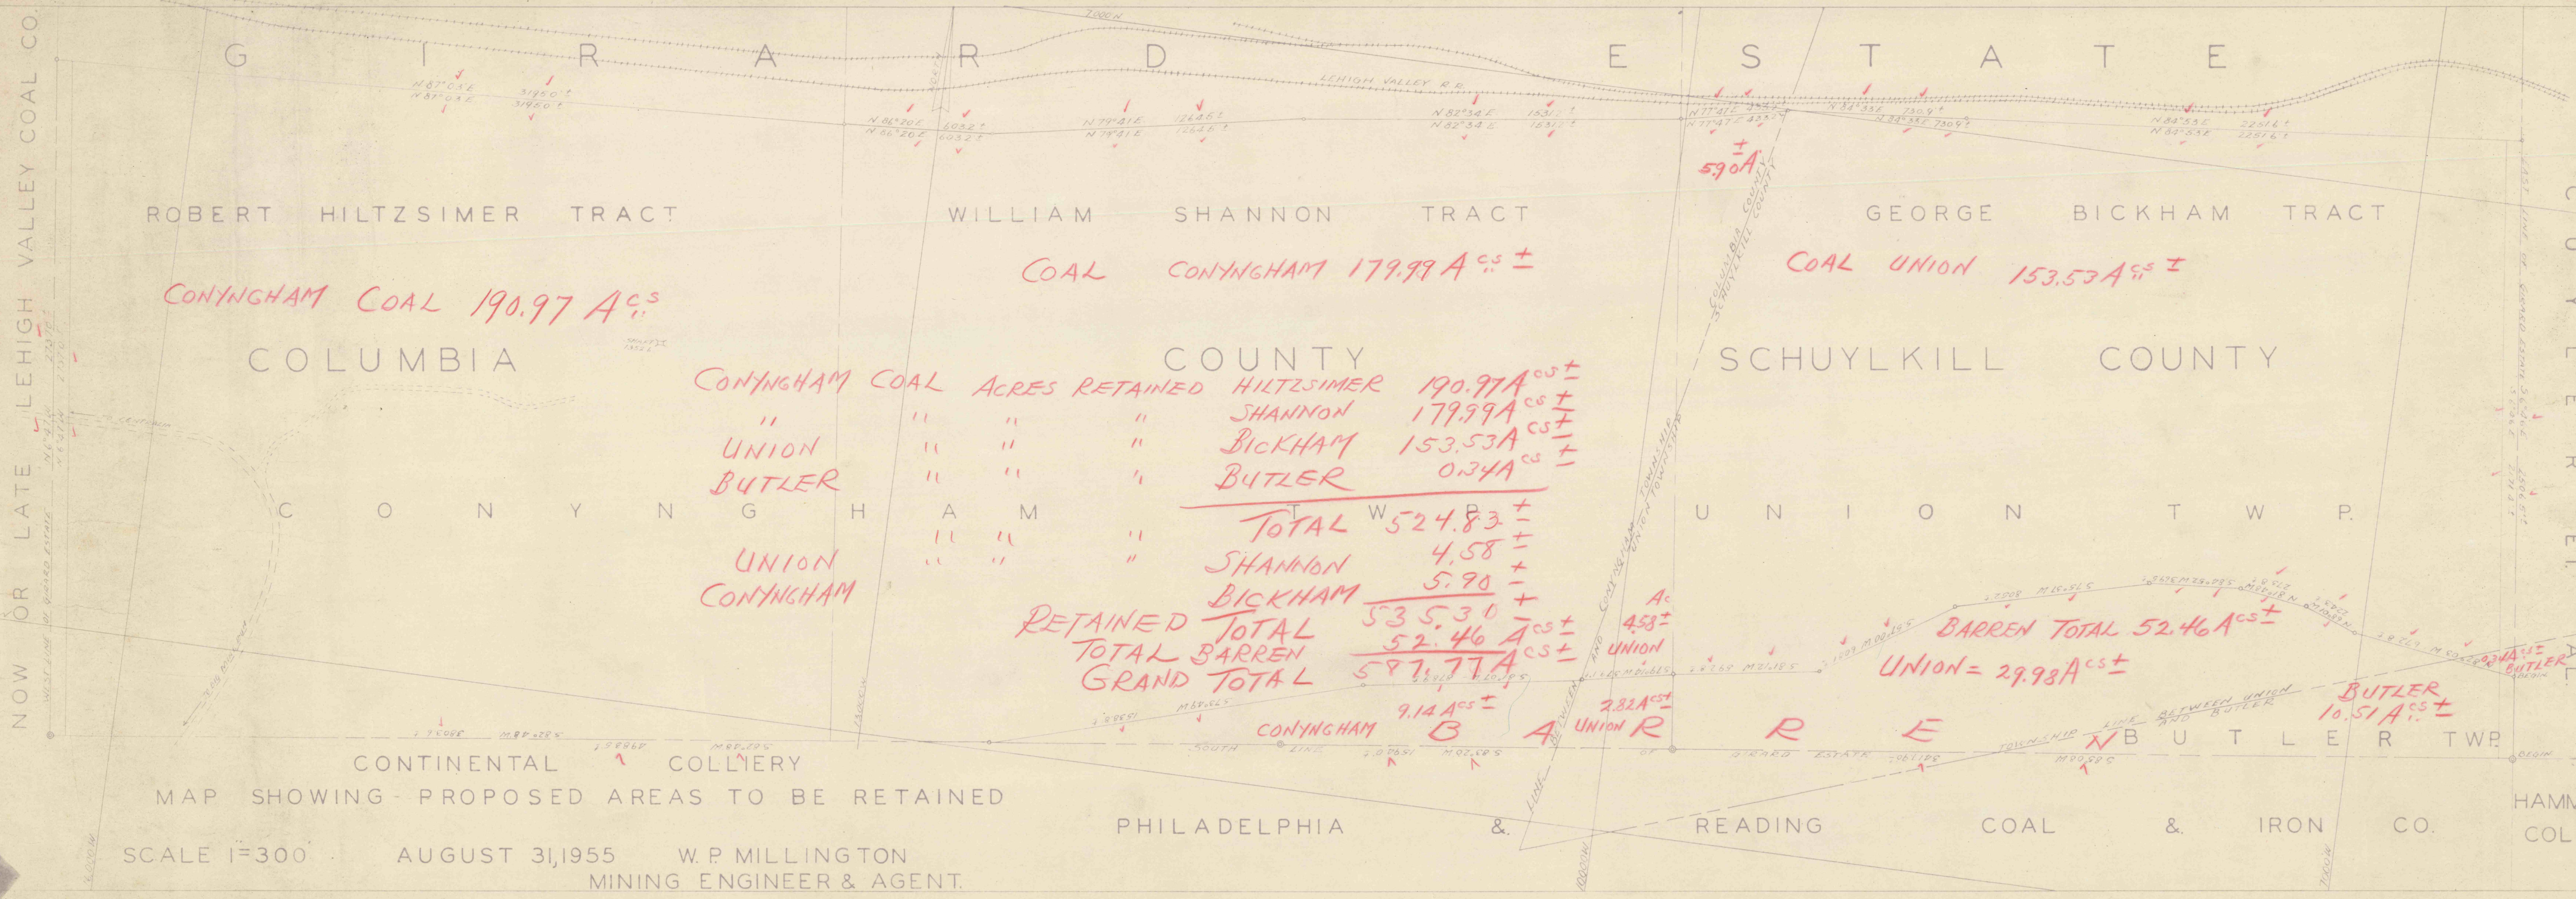

ROBERT HILTZSIMMER TRACT WILLIAM SHANNON TRACT GEORGE BICKHAM TRACT

CONYNGHAM COAL 190.97 A^{c.s} ± COAL CONYNGHAM 179.99 A^{c.s} ± COAL UNION 153.53 A^{c.s} ±

COLUMBIA COUNTY SCHUYLKILL COUNTY

CONYNGHAM COAL ACRES RETAINED	HILTZSIMMER	190.97 A ^{c.s} ±
"	SHANNON	179.99 A ^{c.s} ±
UNION	BICKHAM	153.53 A ^{c.s} ±
BUTLER	BUTLER	0.34 A ^{c.s} ±
TOTAL		524.83 ±
SHANNON		4.58 ±
BICKHAM		5.90 ±
RETAINED TOTAL		535.30 ±
TOTAL BARREN		52.46 A ^{c.s} ±
GRAND TOTAL		587.77 A ^{c.s} ±
CONYNGHAM		9.14 A ^{c.s} ±
UNION		2.82 A ^{c.s} ±
BUTLER		10.51 A ^{c.s} ±

BARREN TOTAL 52.46 A^{c.s} ±
UNION = 29.93 A^{c.s} ±

CONTINENTAL COLLIERY PHILADELPHIA & READING COAL & IRON CO. HAMMOND COLL'Y

MAP SHOWING PROPOSED AREAS TO BE RETAINED

SCALE 1"=300' AUGUST 31, 1955 W. P. MILLINGTON
MINING ENGINEER & AGENT.