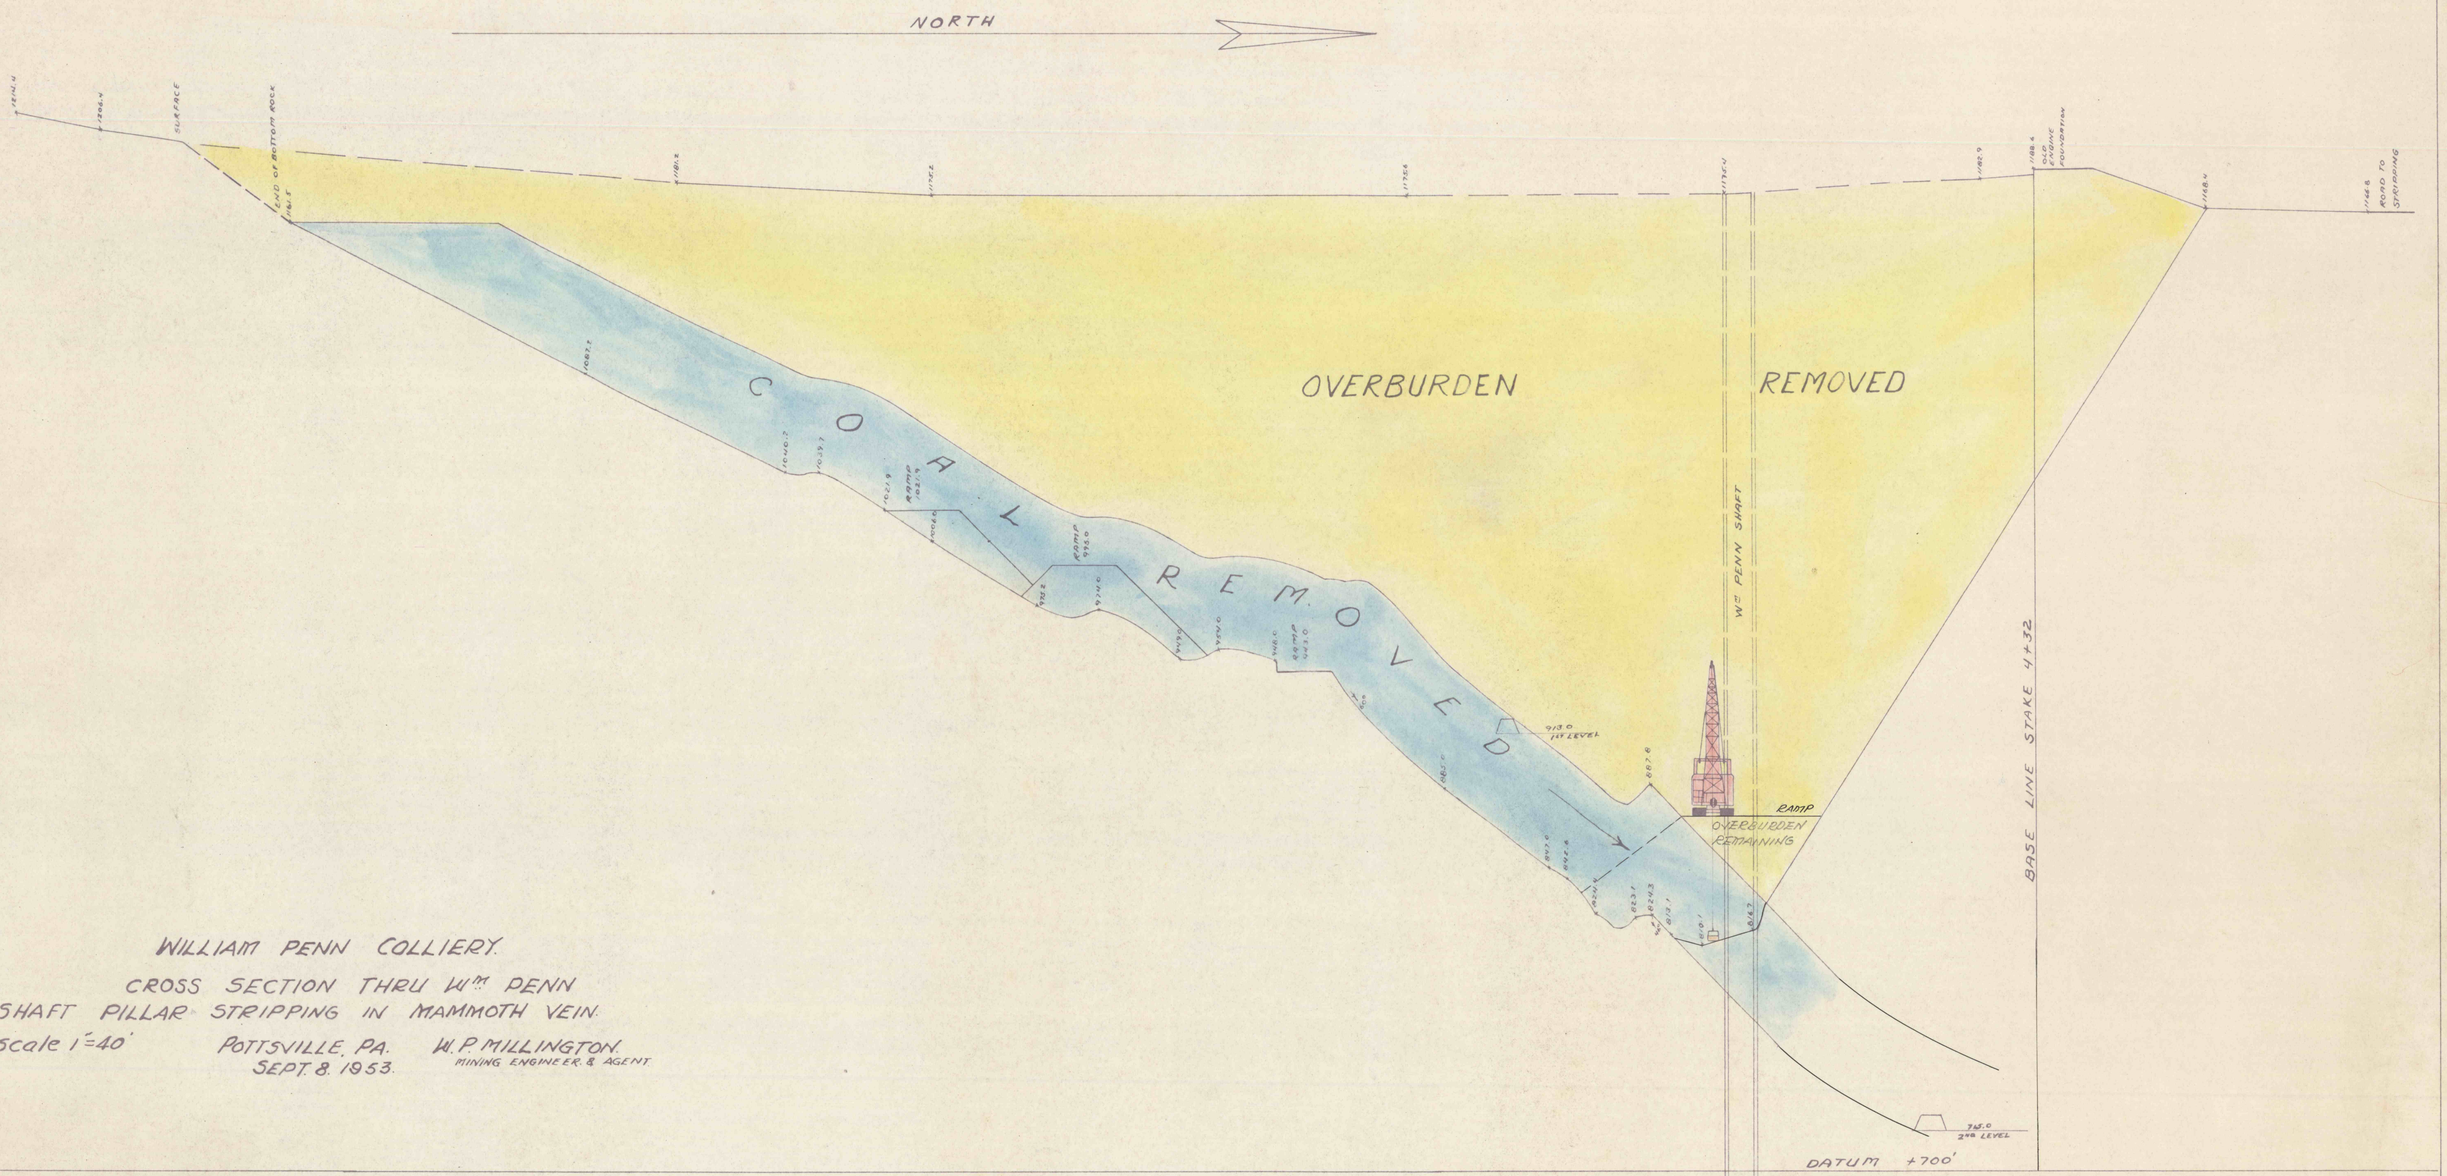

WILLIAM PENN COLLIERY.

CROSS SECTION THRU Wm PENN SHAFT PILLAR STRIPPING IN MAMMOTH VEIN.

Scale 1"=40'

POTTSVILLE, PA. SEPT. 8. 1953.

W. P. MILLINGTON. MINING ENGINEER & AGENT.