Div.	Dist.	County	Route	Sec.	Sheet
3	5	Schuylkill	755		A
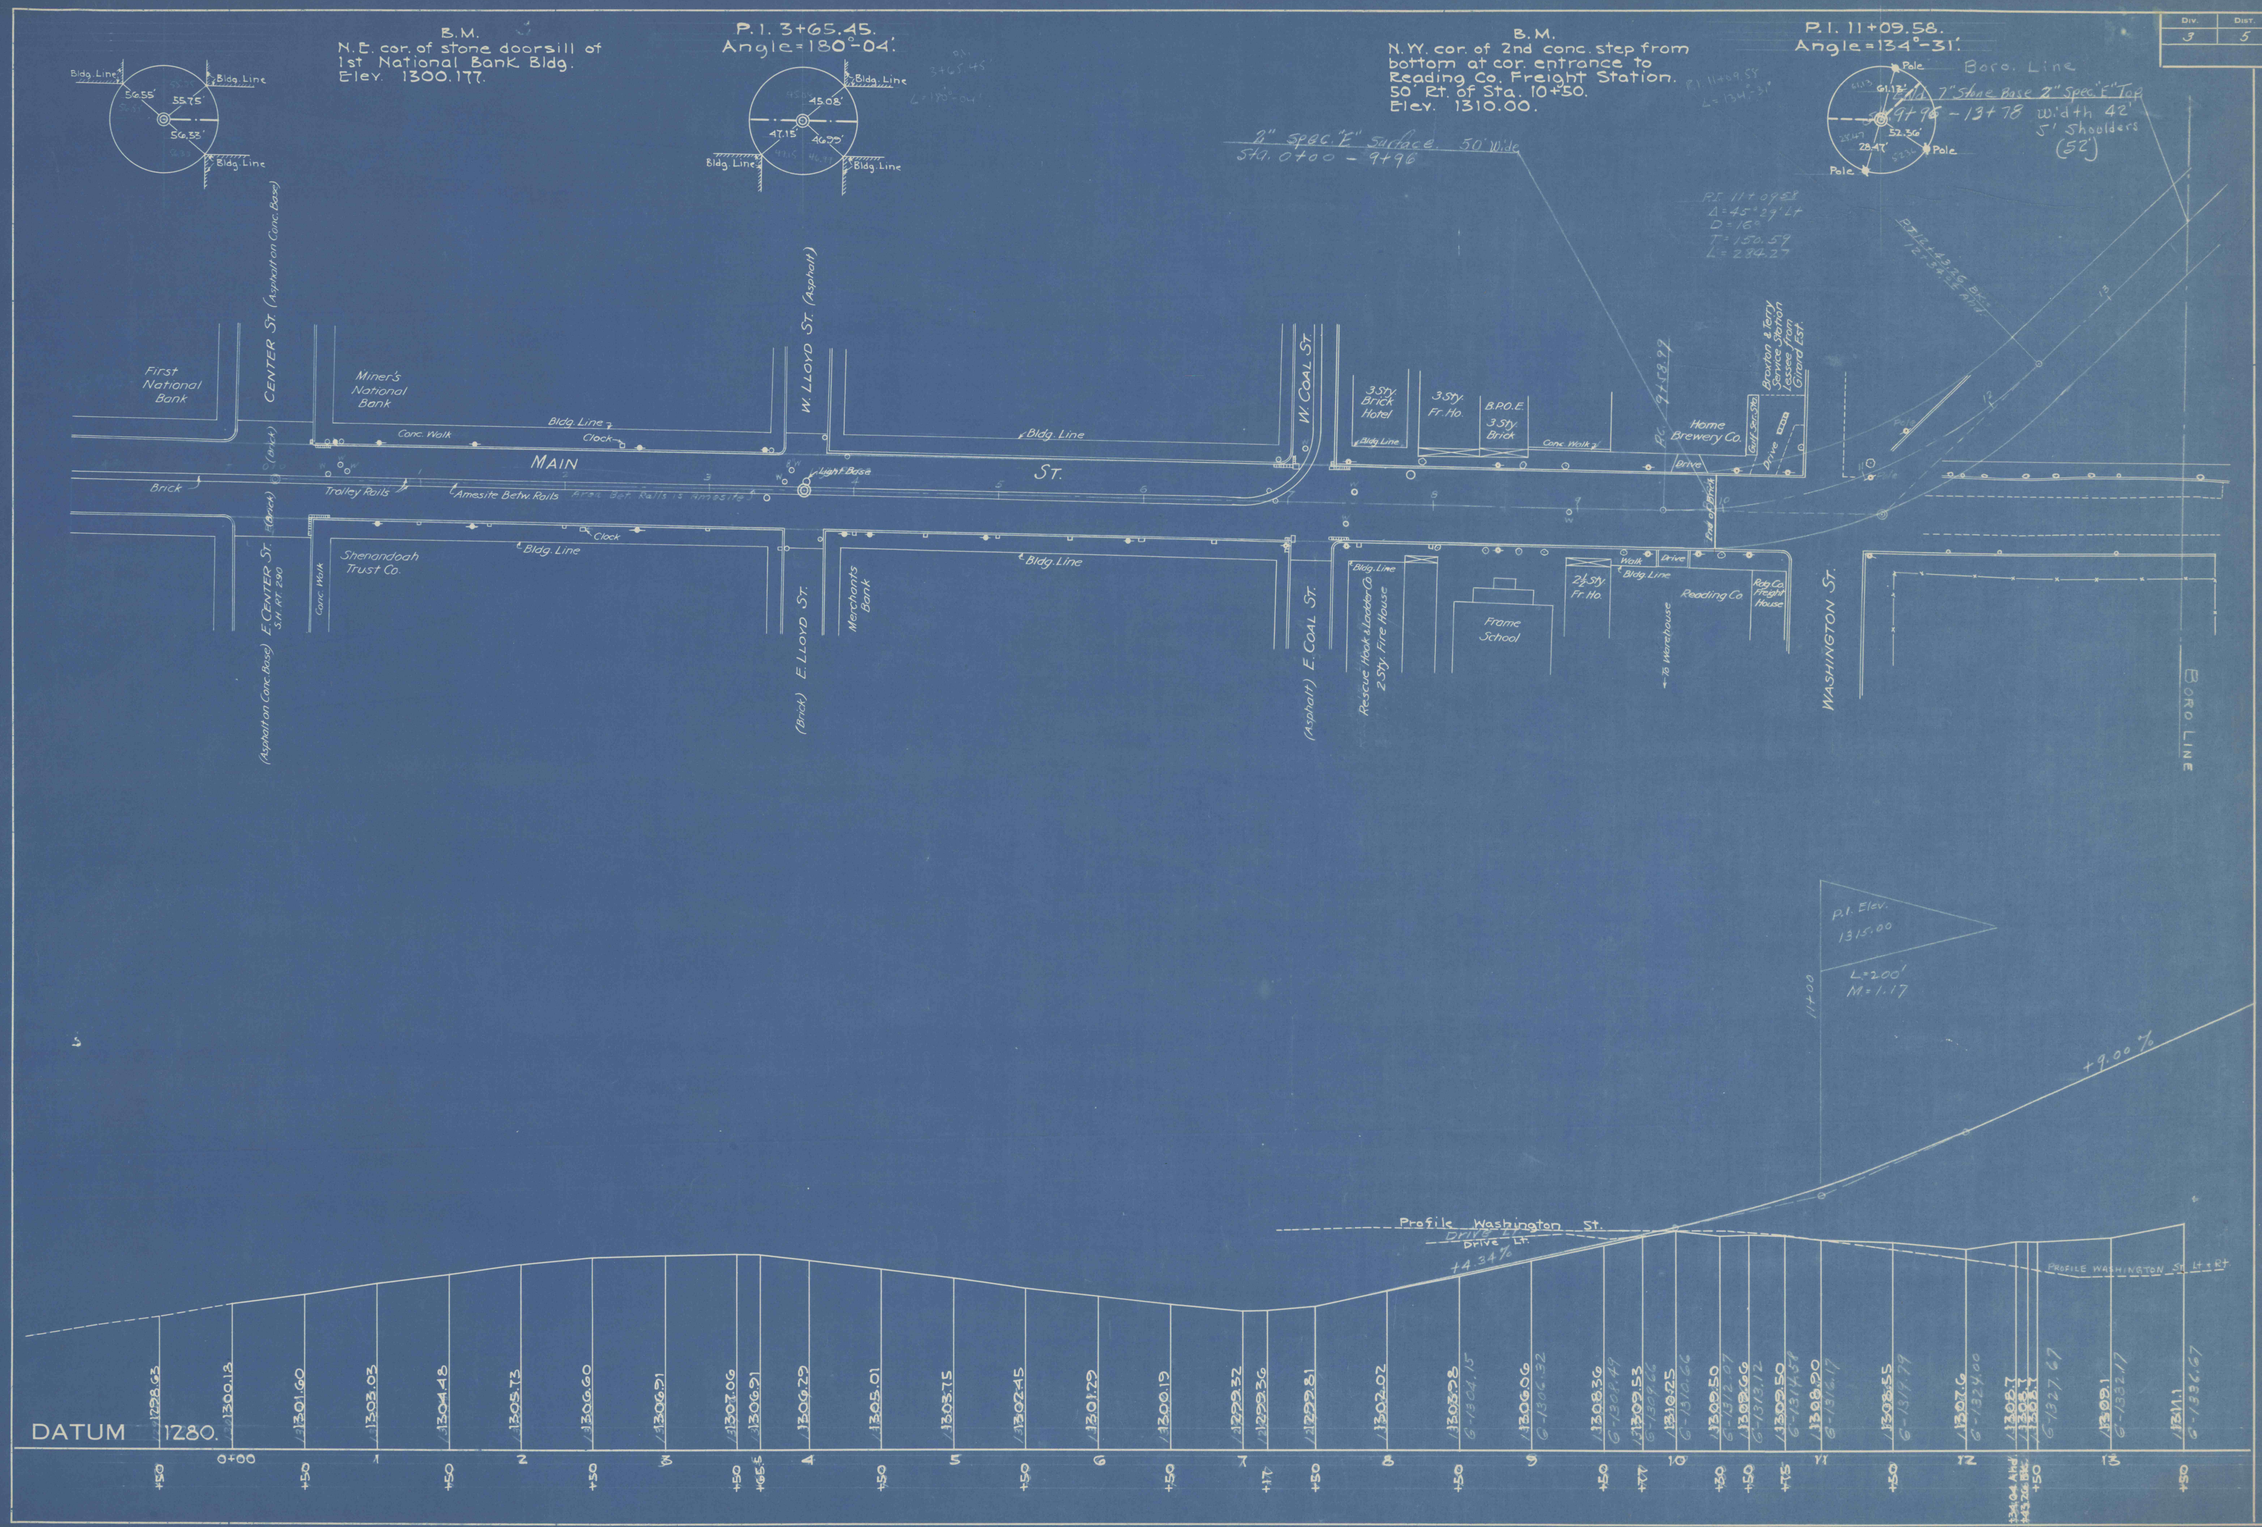
REQUIRED LIST.