


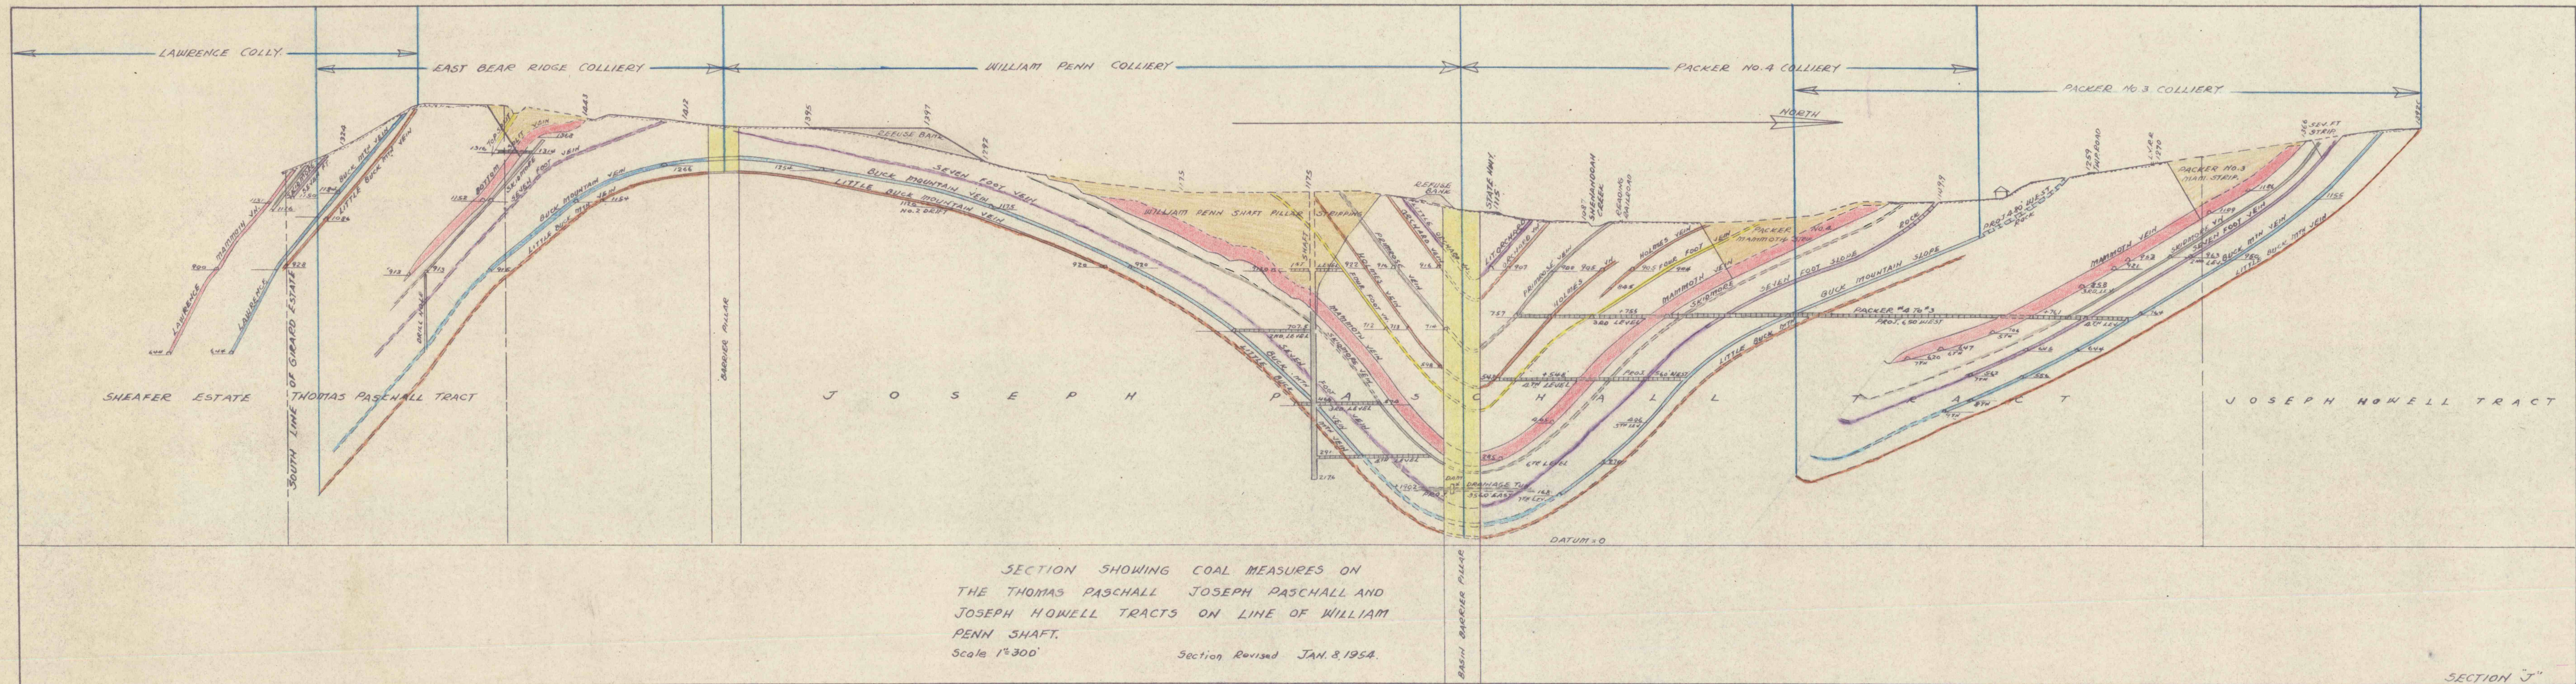

SECTION "J"