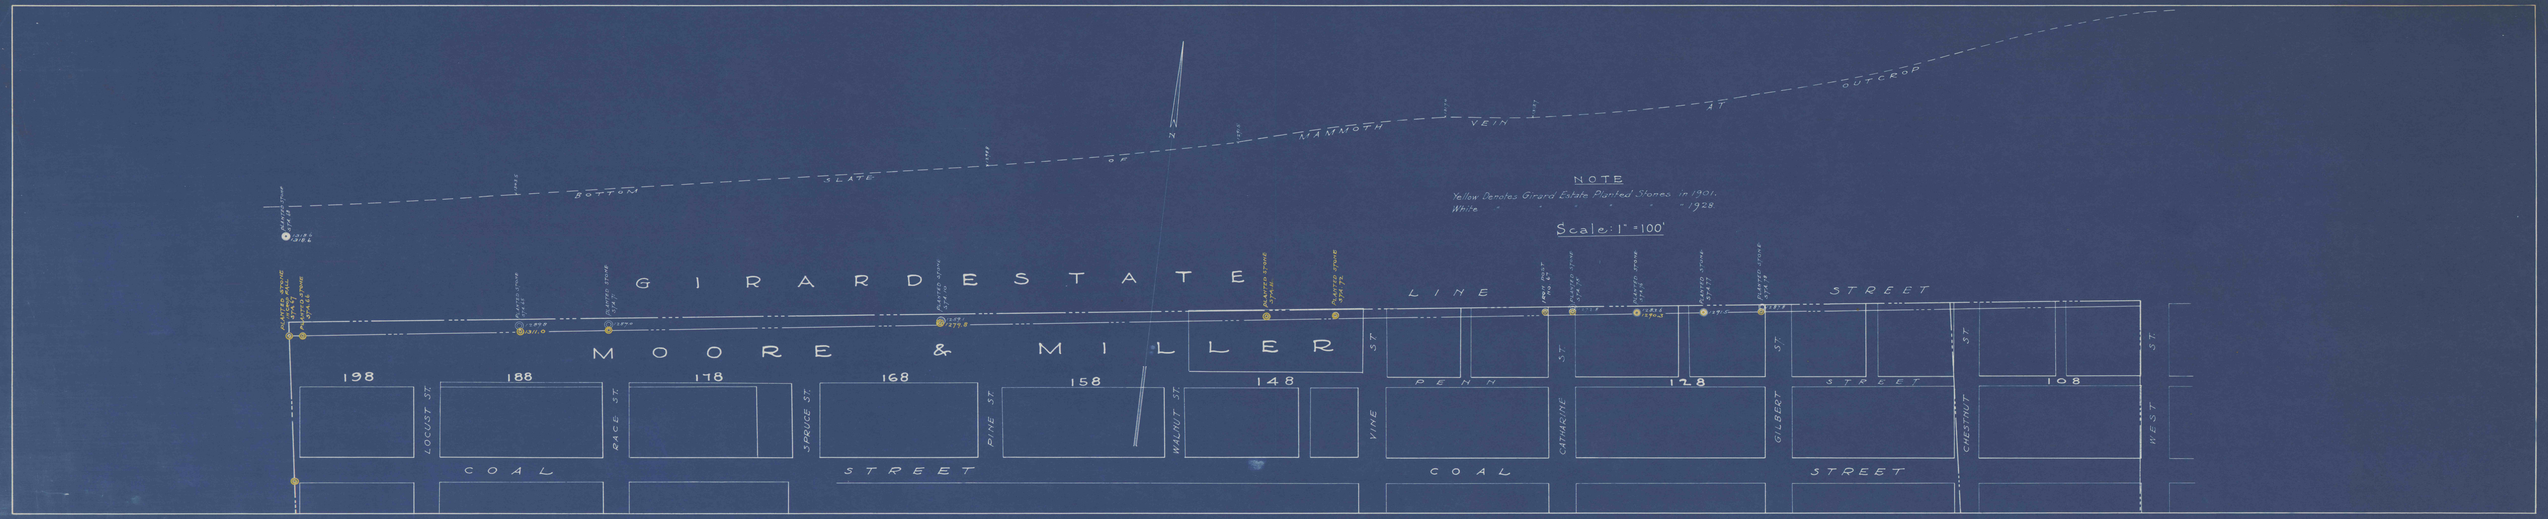
NOTE
Yellow Denotes Girard Estate Planted Stones in 1901.
White " " " " " 1928
Scale: 1" = 100'
BOTTOM OF SLATE
MAMMOTH VEIN AT OUTCROP
GIRARD ESTATE LINE
MOORE & MILLER
PENN STREET
COAL STREET
198
188
178
168
158
148
128
108
LOCUST ST.
RACE ST.
SPRUCE ST.
PINE ST.
WALNUT ST.
VINE ST.
CATHARINE ST.
GILBERT ST.
CHESTNUT ST.
WEST ST.

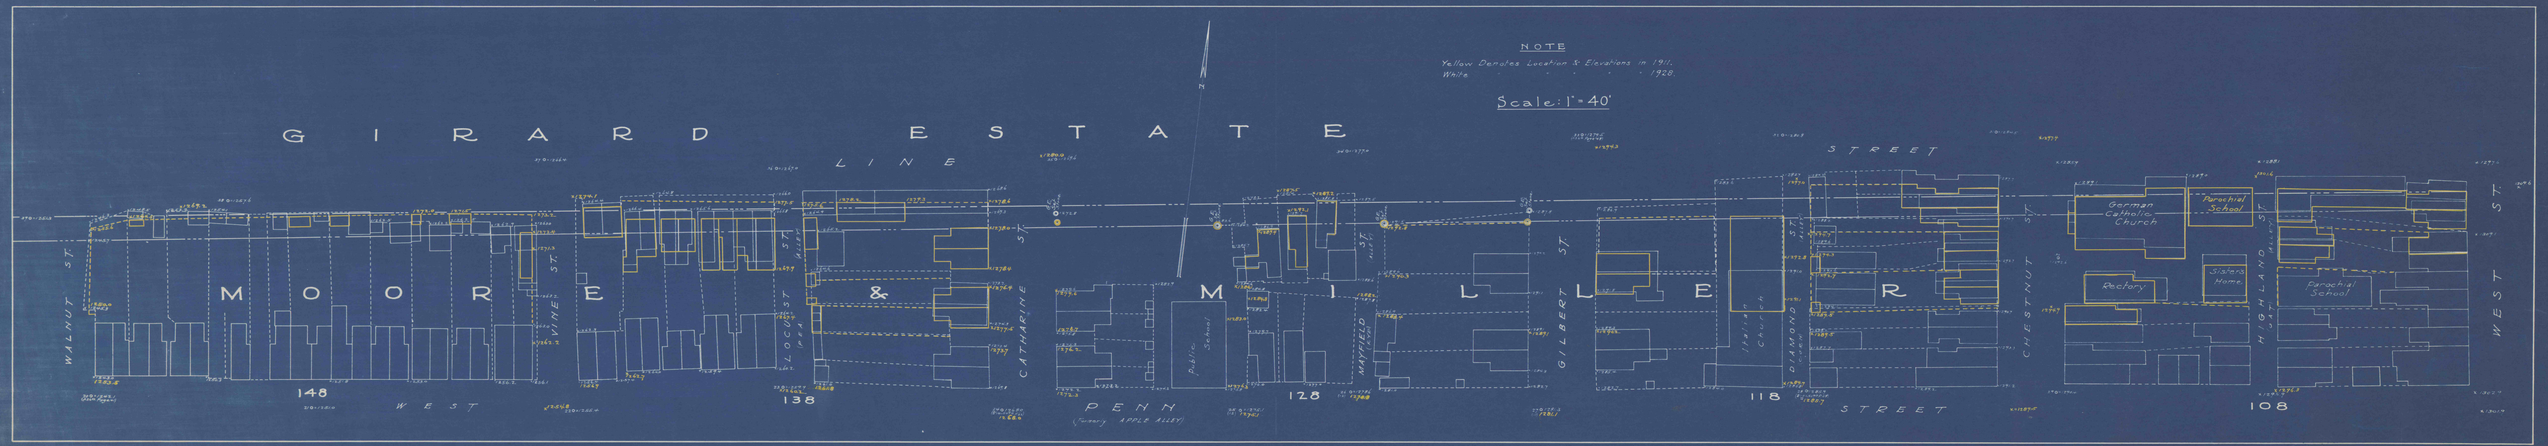
NOTE
White " " " " 1928.
Scale: 1" = 40'
GIRARD ESTATE LINE
MOORE & MILLER
PENN STREET
WALNUT ST.
VINE ST.
LOCUST ST.
CATHARINE ST.
MAYFIELD ST.
GILBERT ST.
DIAMOND ST.
CHESTNUT ST.
HIGHLAND ST.
WEST ST.
Public School
Italian Church
German Catholic Church
Parochial School
Rectory
Sisters Home
Parochial School
148
138
128
118
108