


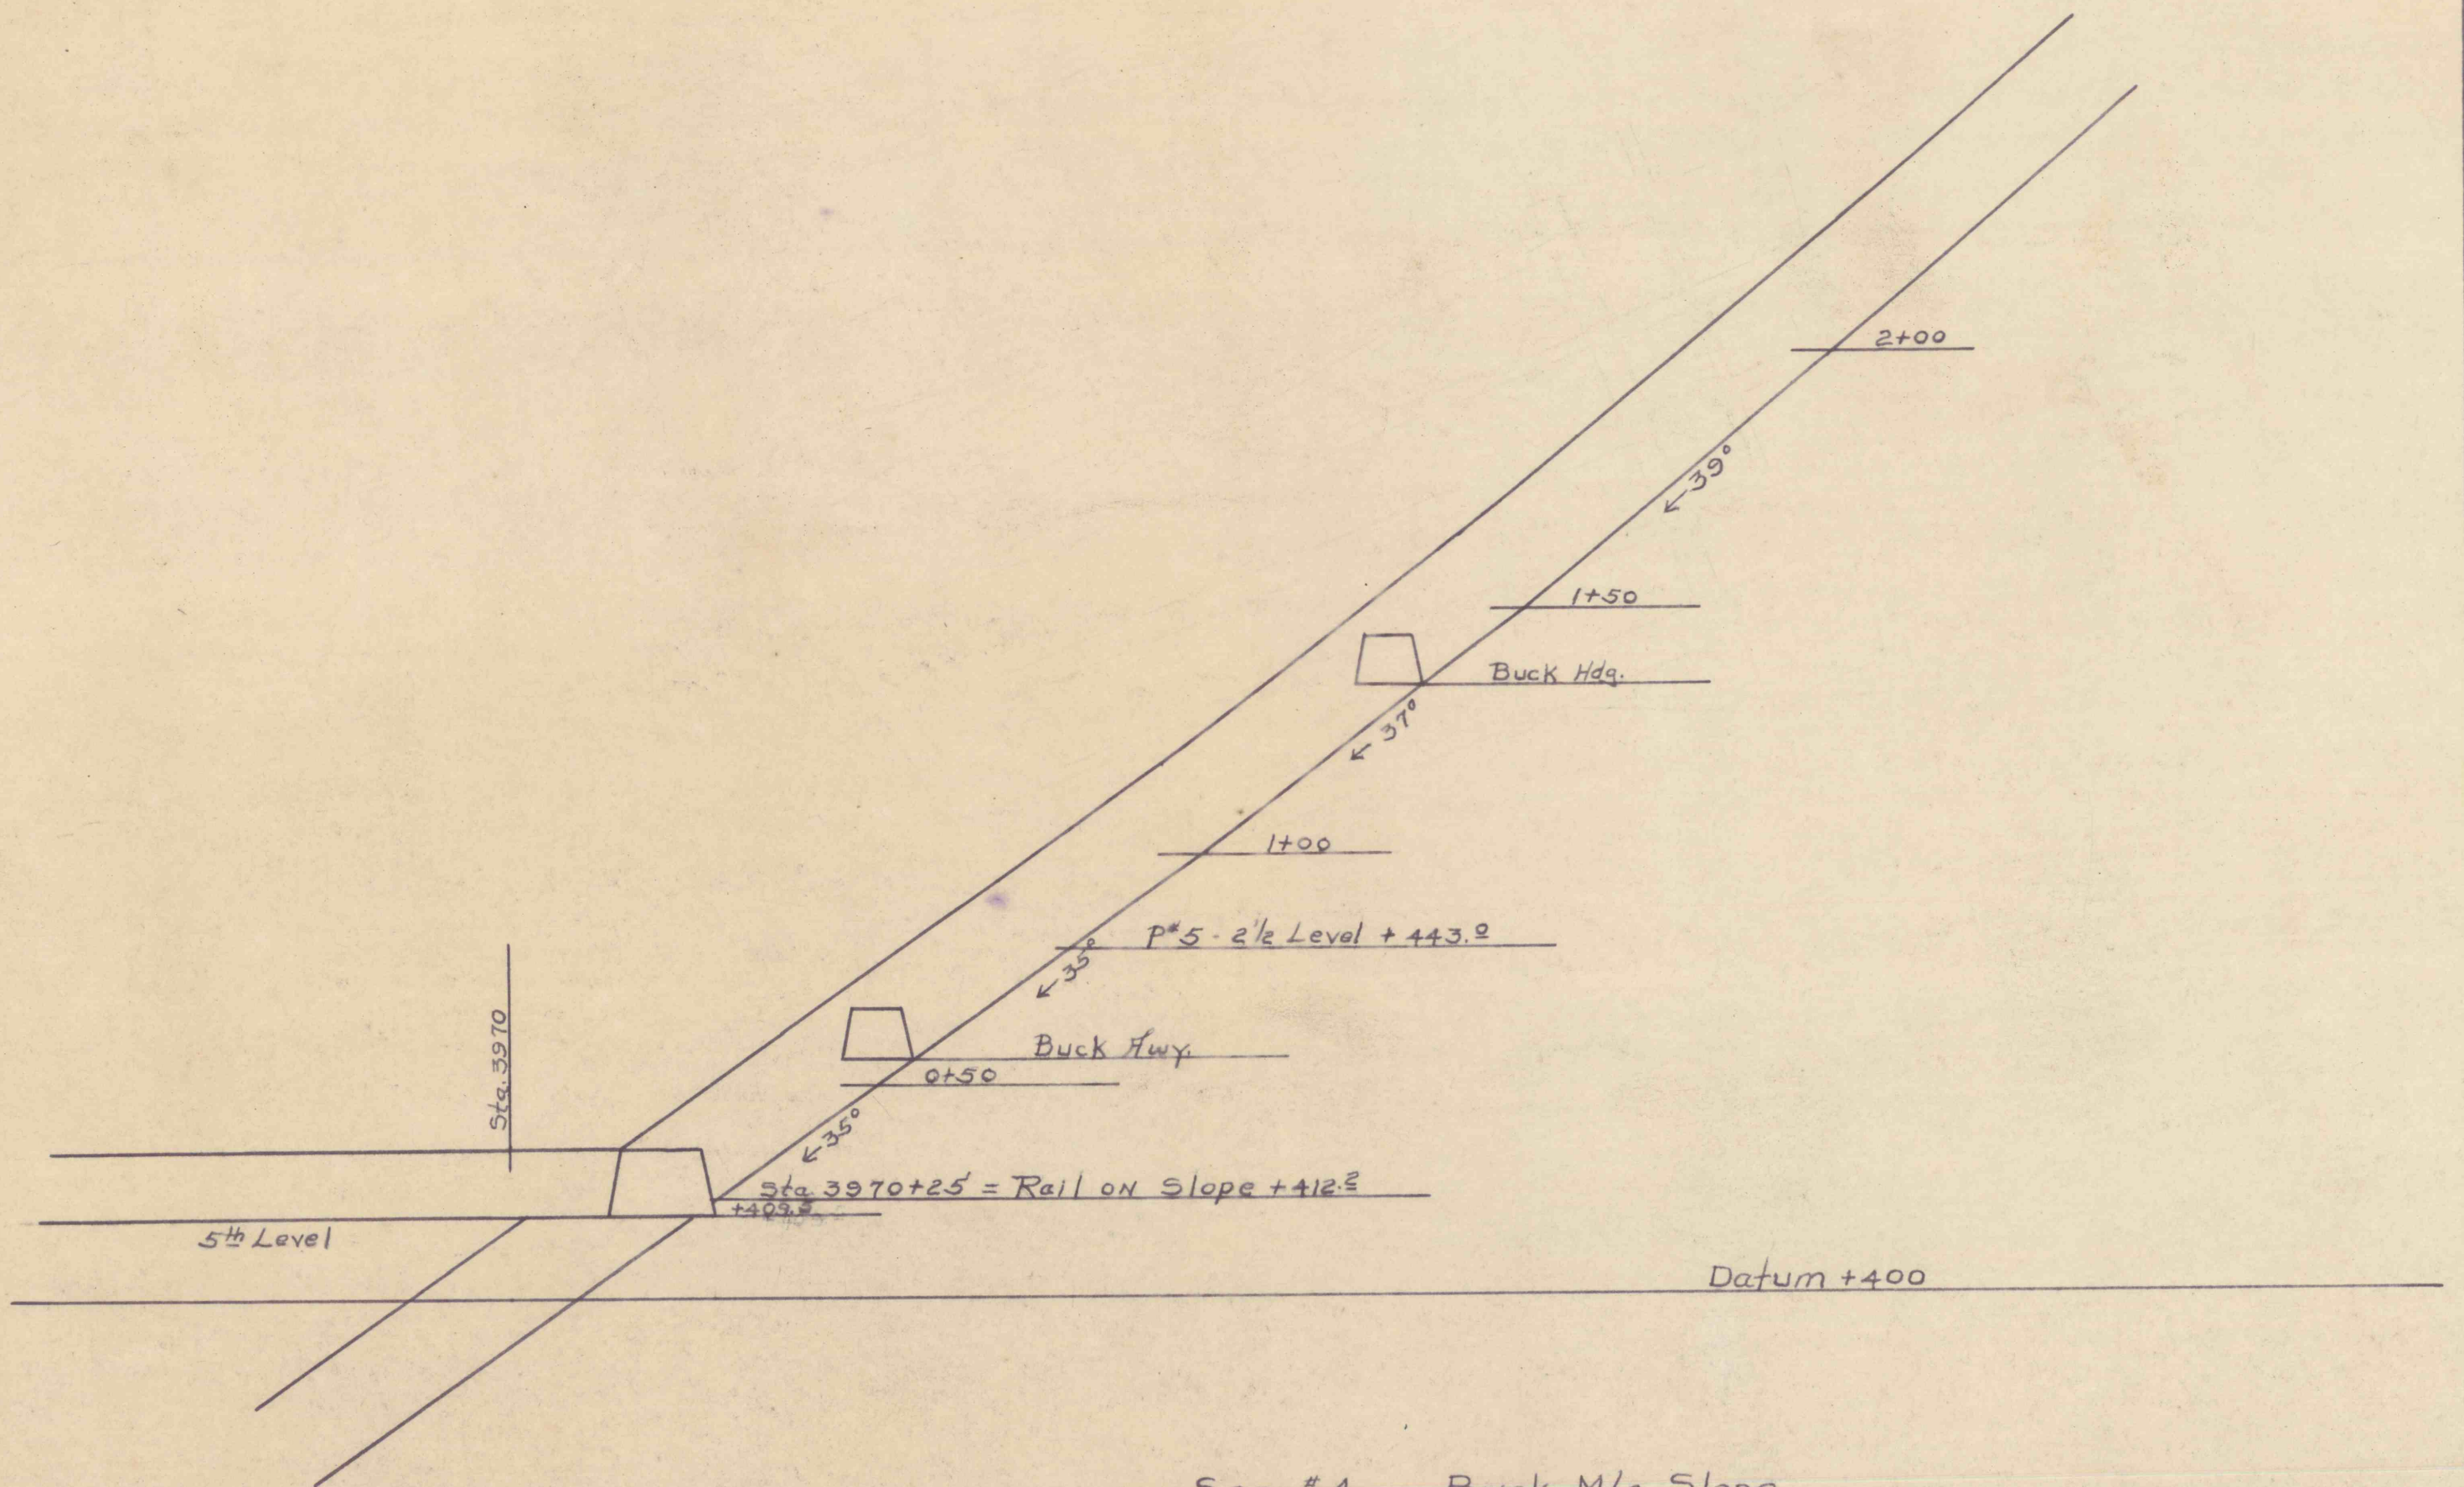

Sec. #4 - Buck Mtn. Slope

Profile Between 5th & 4th Levels - For Water Measurement

Scale 1" = 20'

L.C.C.Co.Inc.

Date April 7th 1959