


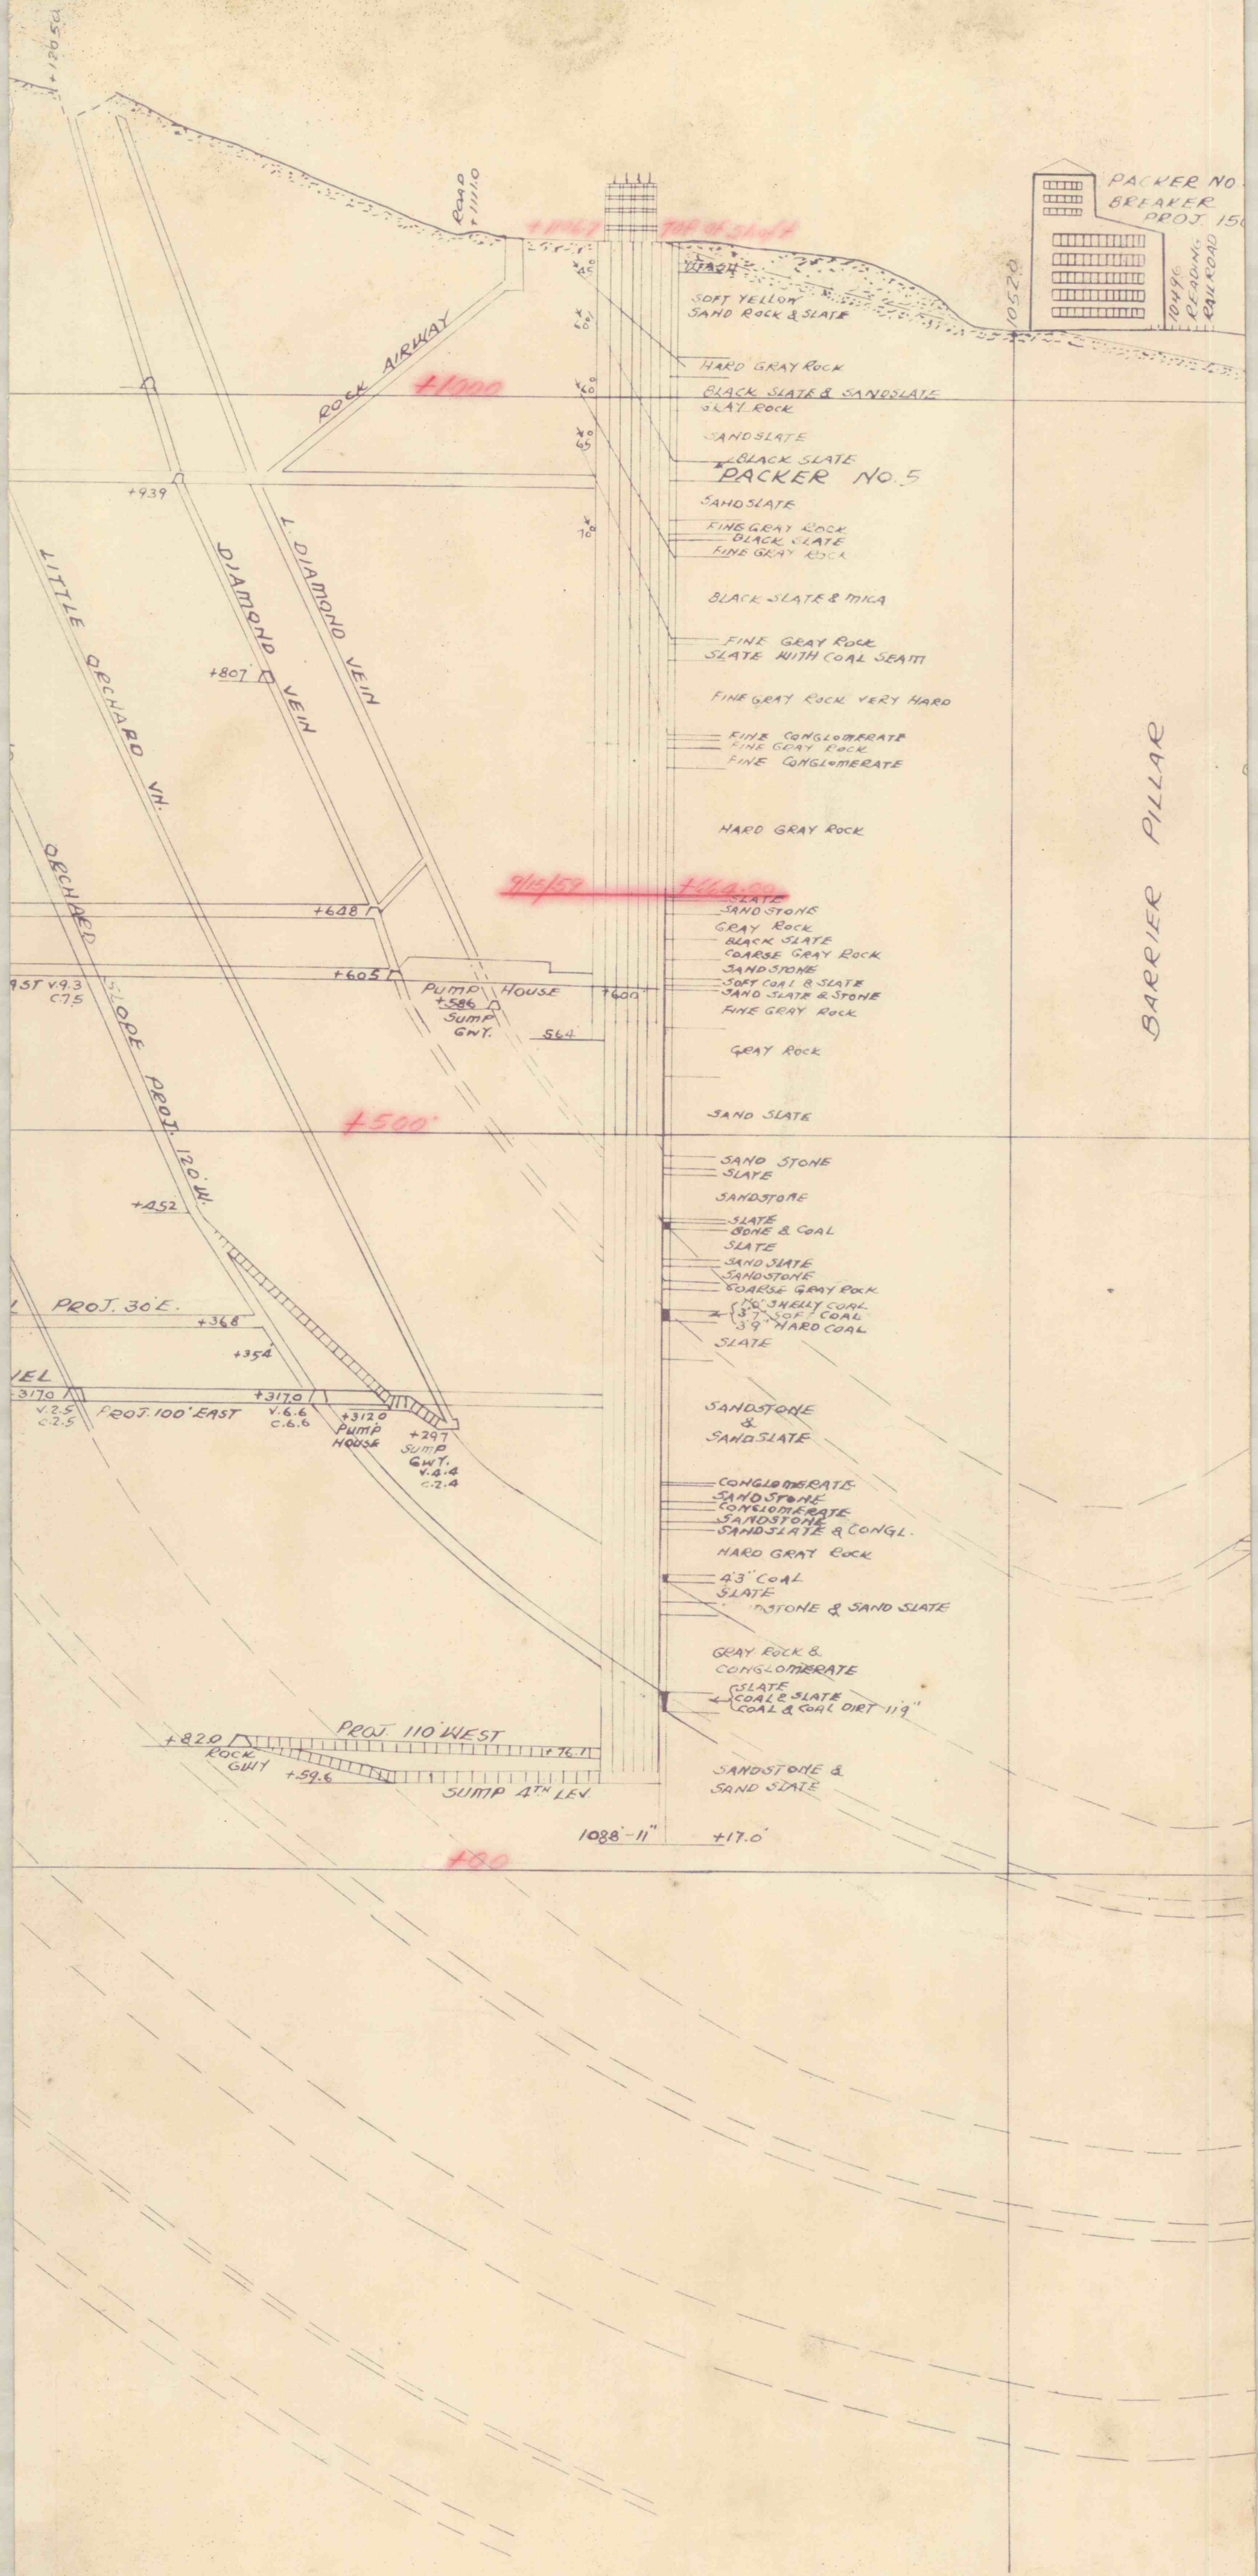

BARRIER PILLAR

Scale 1" = 100'