


KEHLEY'S RUN COLLIERY
Skidmore Bed

Jeremiah Jackson Tract.

Scale 1"=100'
Yellow shows work done by Tony Rose

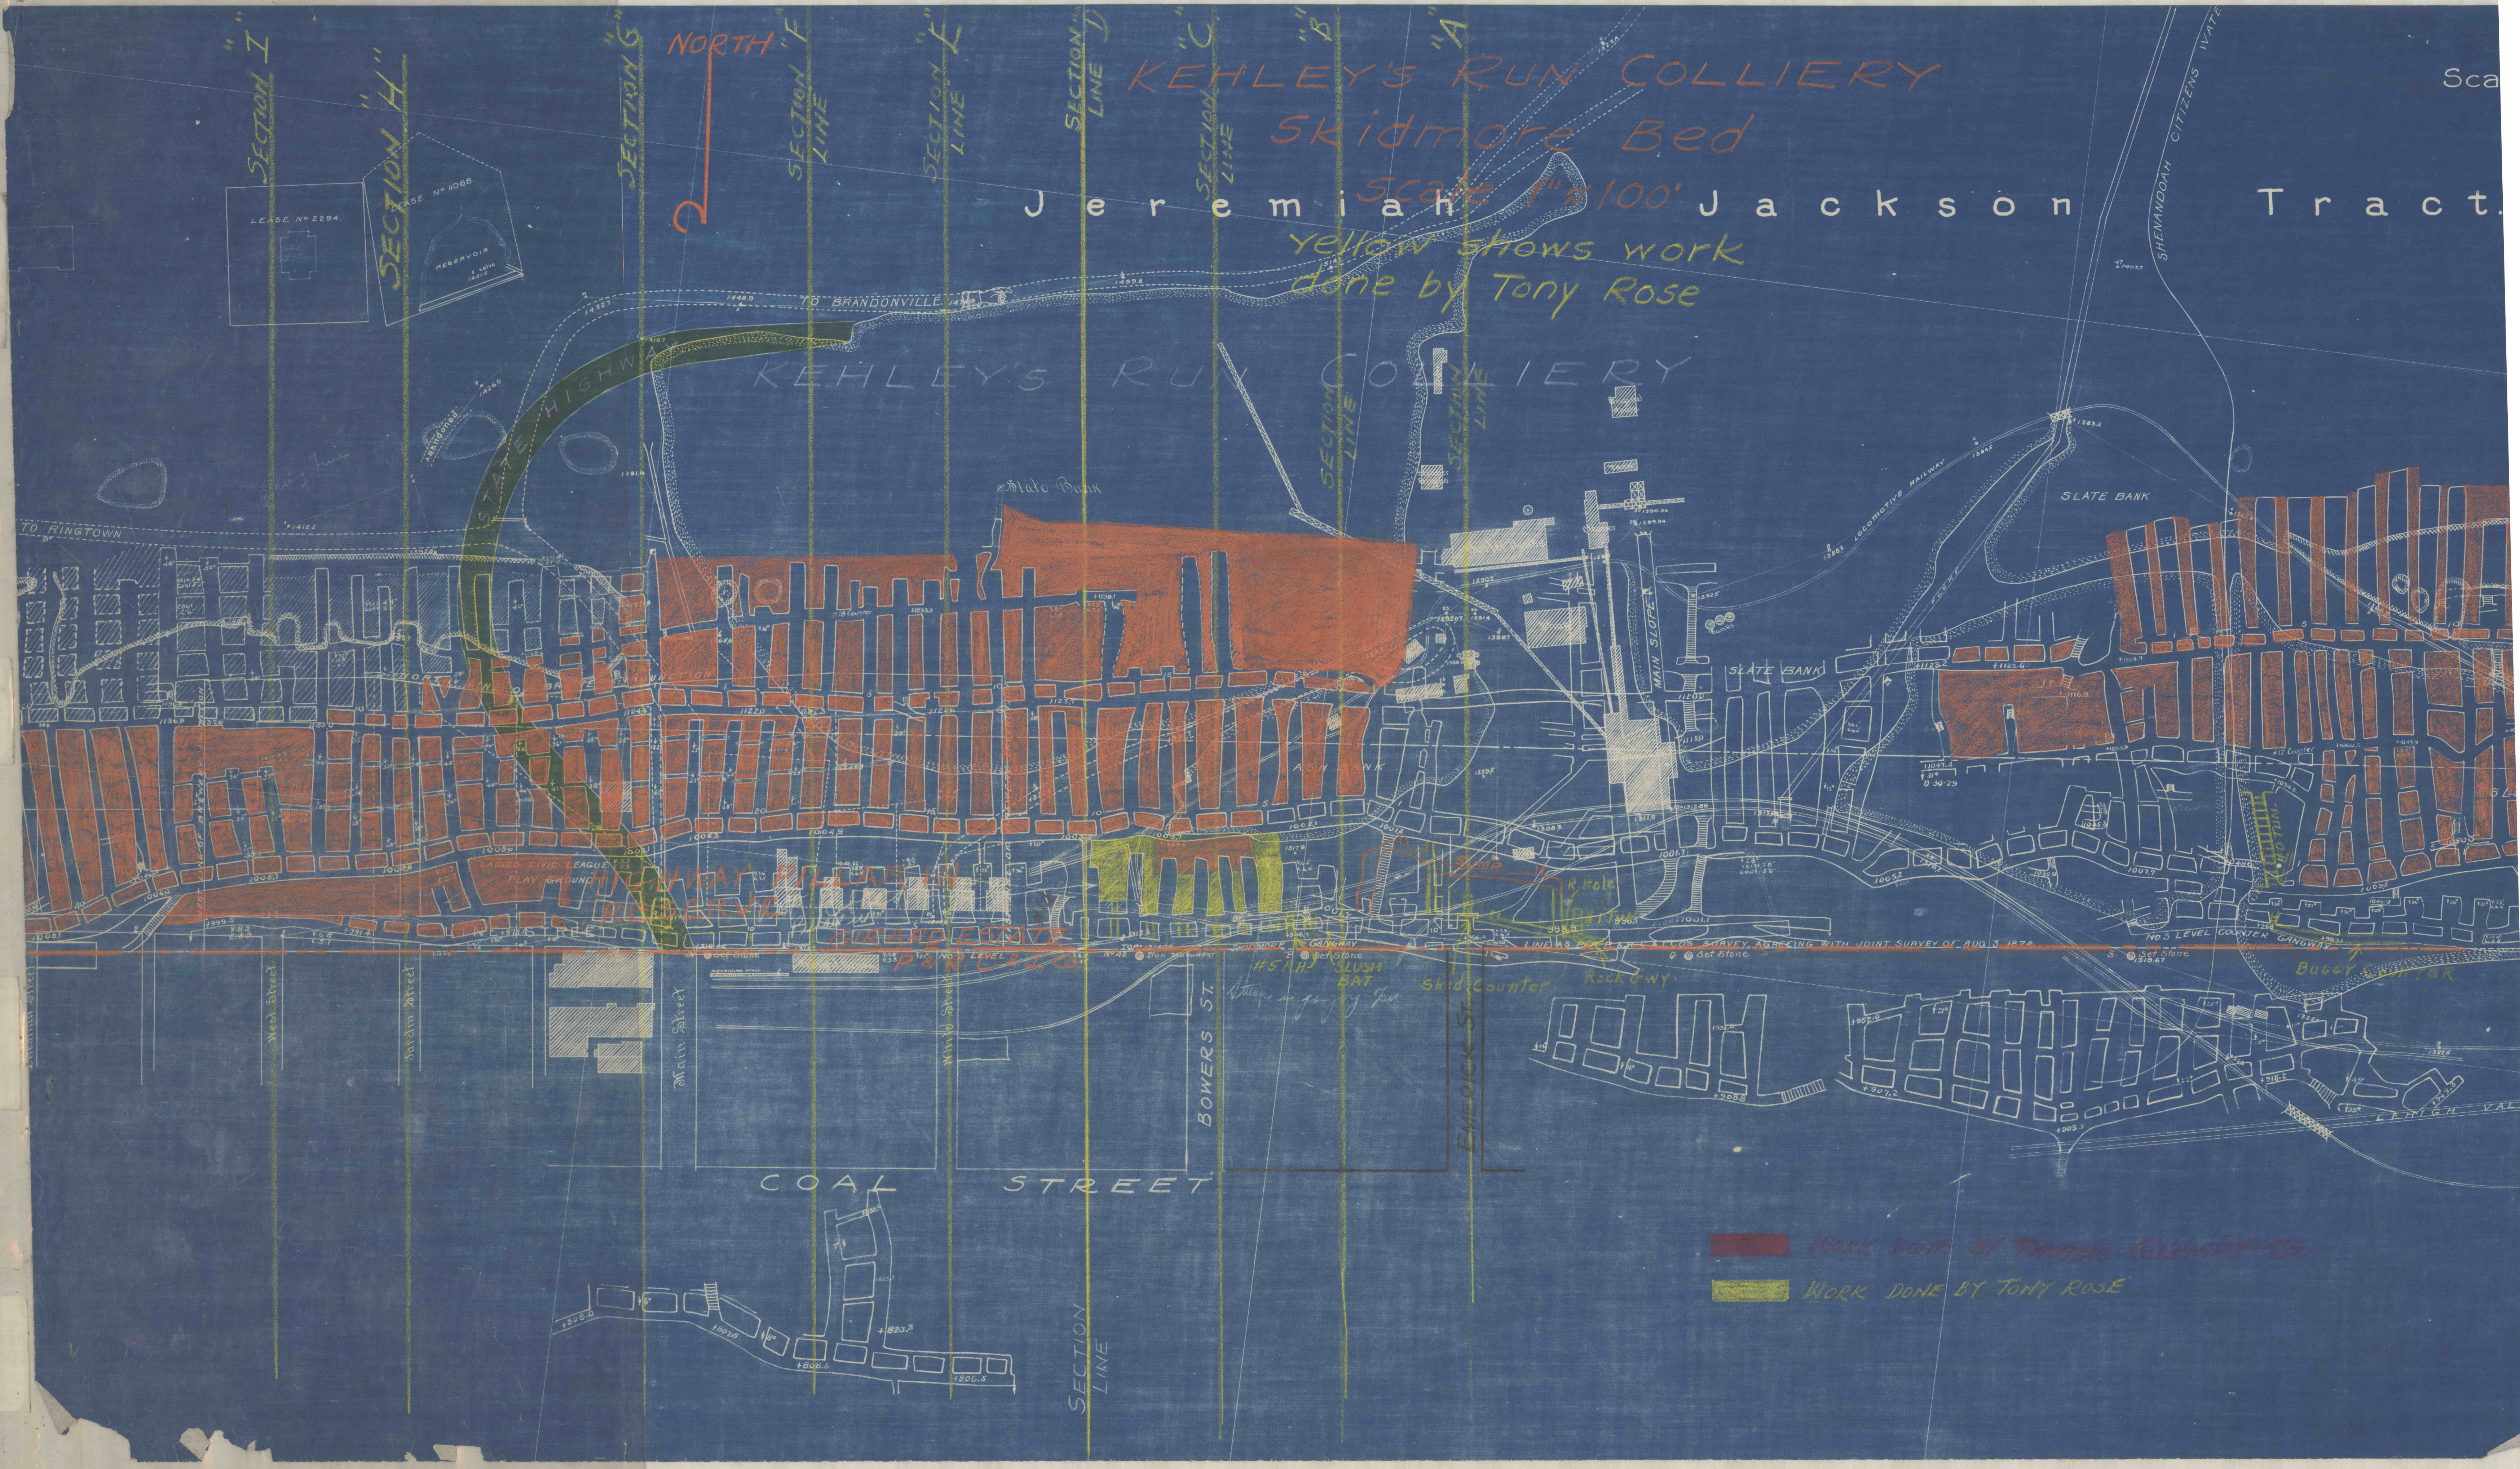

Work done by Thomas Colliery Co.
Work done by Tony Rose