


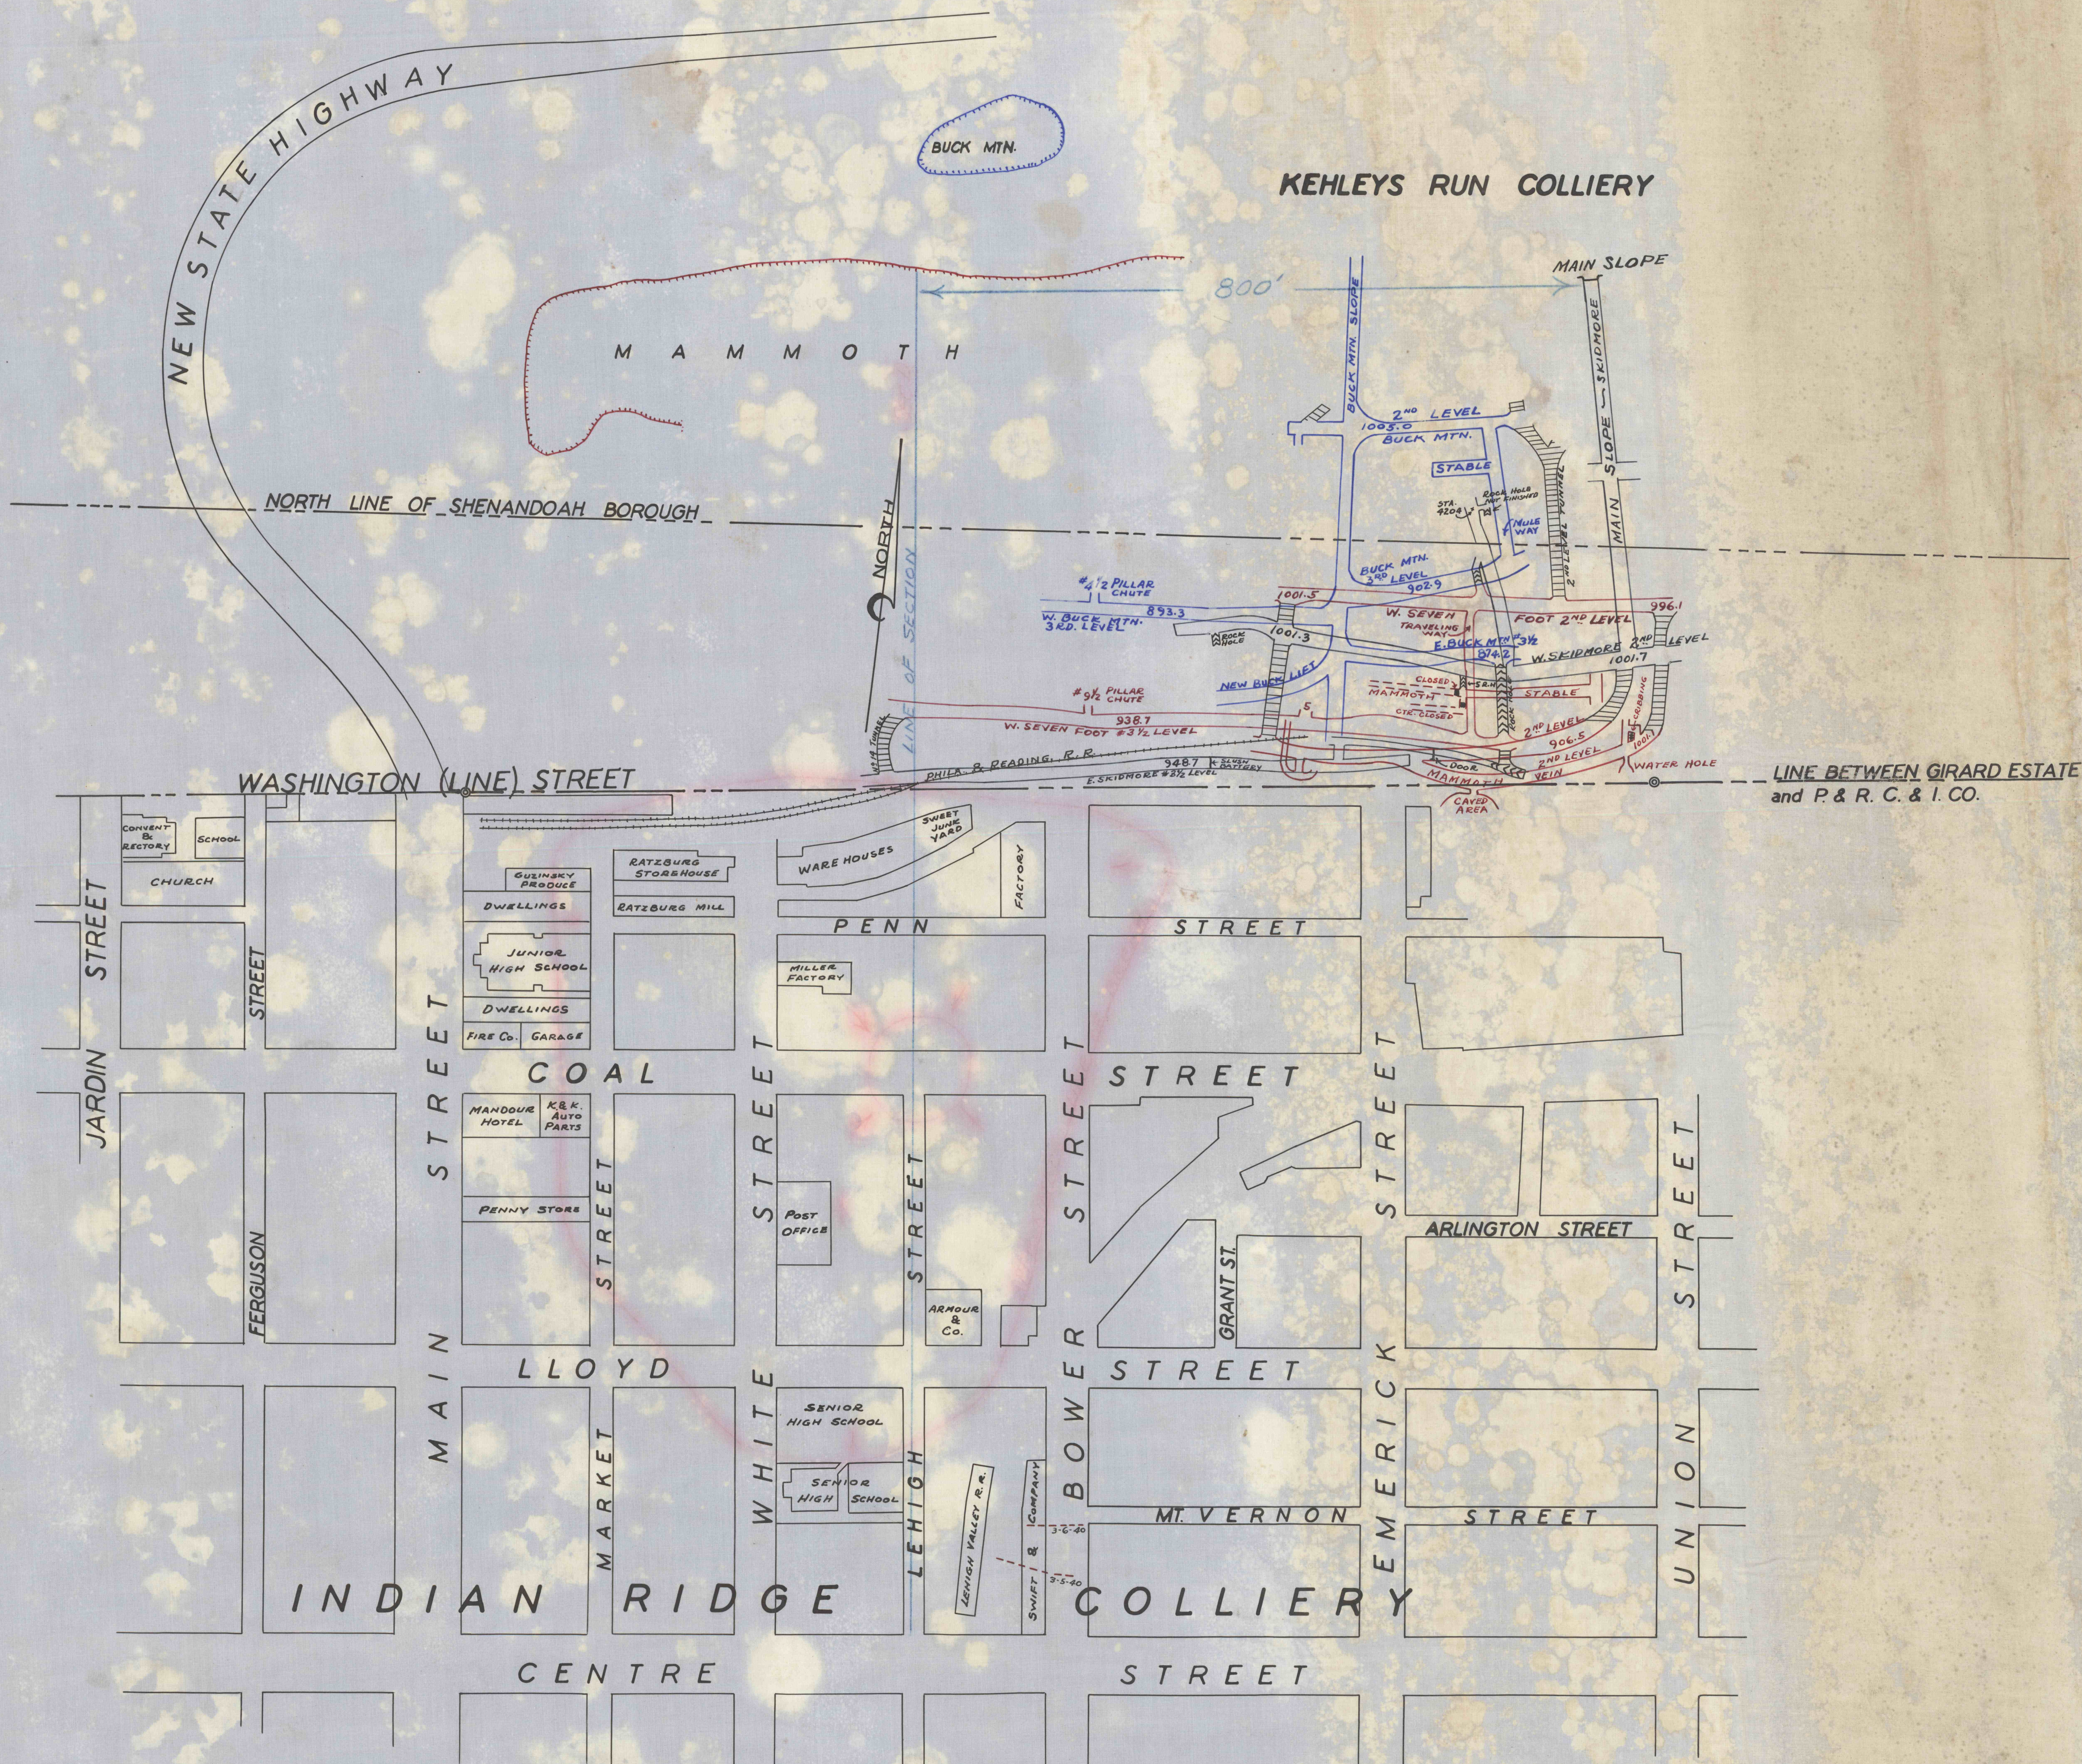

KEHLEYS RUN COLLIERY
 SKETCH SHOWING BOROUGH OF SHENANDOAH
 IN RELATION TO
 KEHLEYS RUN AND INDIAN RIDGE COLLIERIES
 ALSO AREA TRAVERSED BY INSPECTION PARTY
 SCALE 1" = 100' MARCH 5, 1940

W. P. MILLINGTON
 Mining Engineer & Agent

— LEGEND —

	MAMMOTH BED
	SKIDMORE BED
	SEVEN FOOT BED
	BUCK MOUNTAIN BED