

KEHLEY'S RUN COLLIERY
Buck Mountain Bed
Scale 1" = 100'

NORTH

"D" SECTION LINE

SECTION NO. 3
BOX 19 TAG

EAST LINE JAMES McNEAL TRACT
WEST LINE JEREMIAH JACKSON TRACT

LYKENS VALLEY
Coal 2 1/2'
City 2 1/2' South
Bottom Shaft 15200

17859
Red Ash
Coal 5 1/2'

18718
White Ash
Coal 5 1/2'

LEASE NO. 2394

LEASE NO. 1068


RESERVOIR

TO BRANDONVILLE

Jeremiah

LYKENS VALLEY VEIN

Jackson

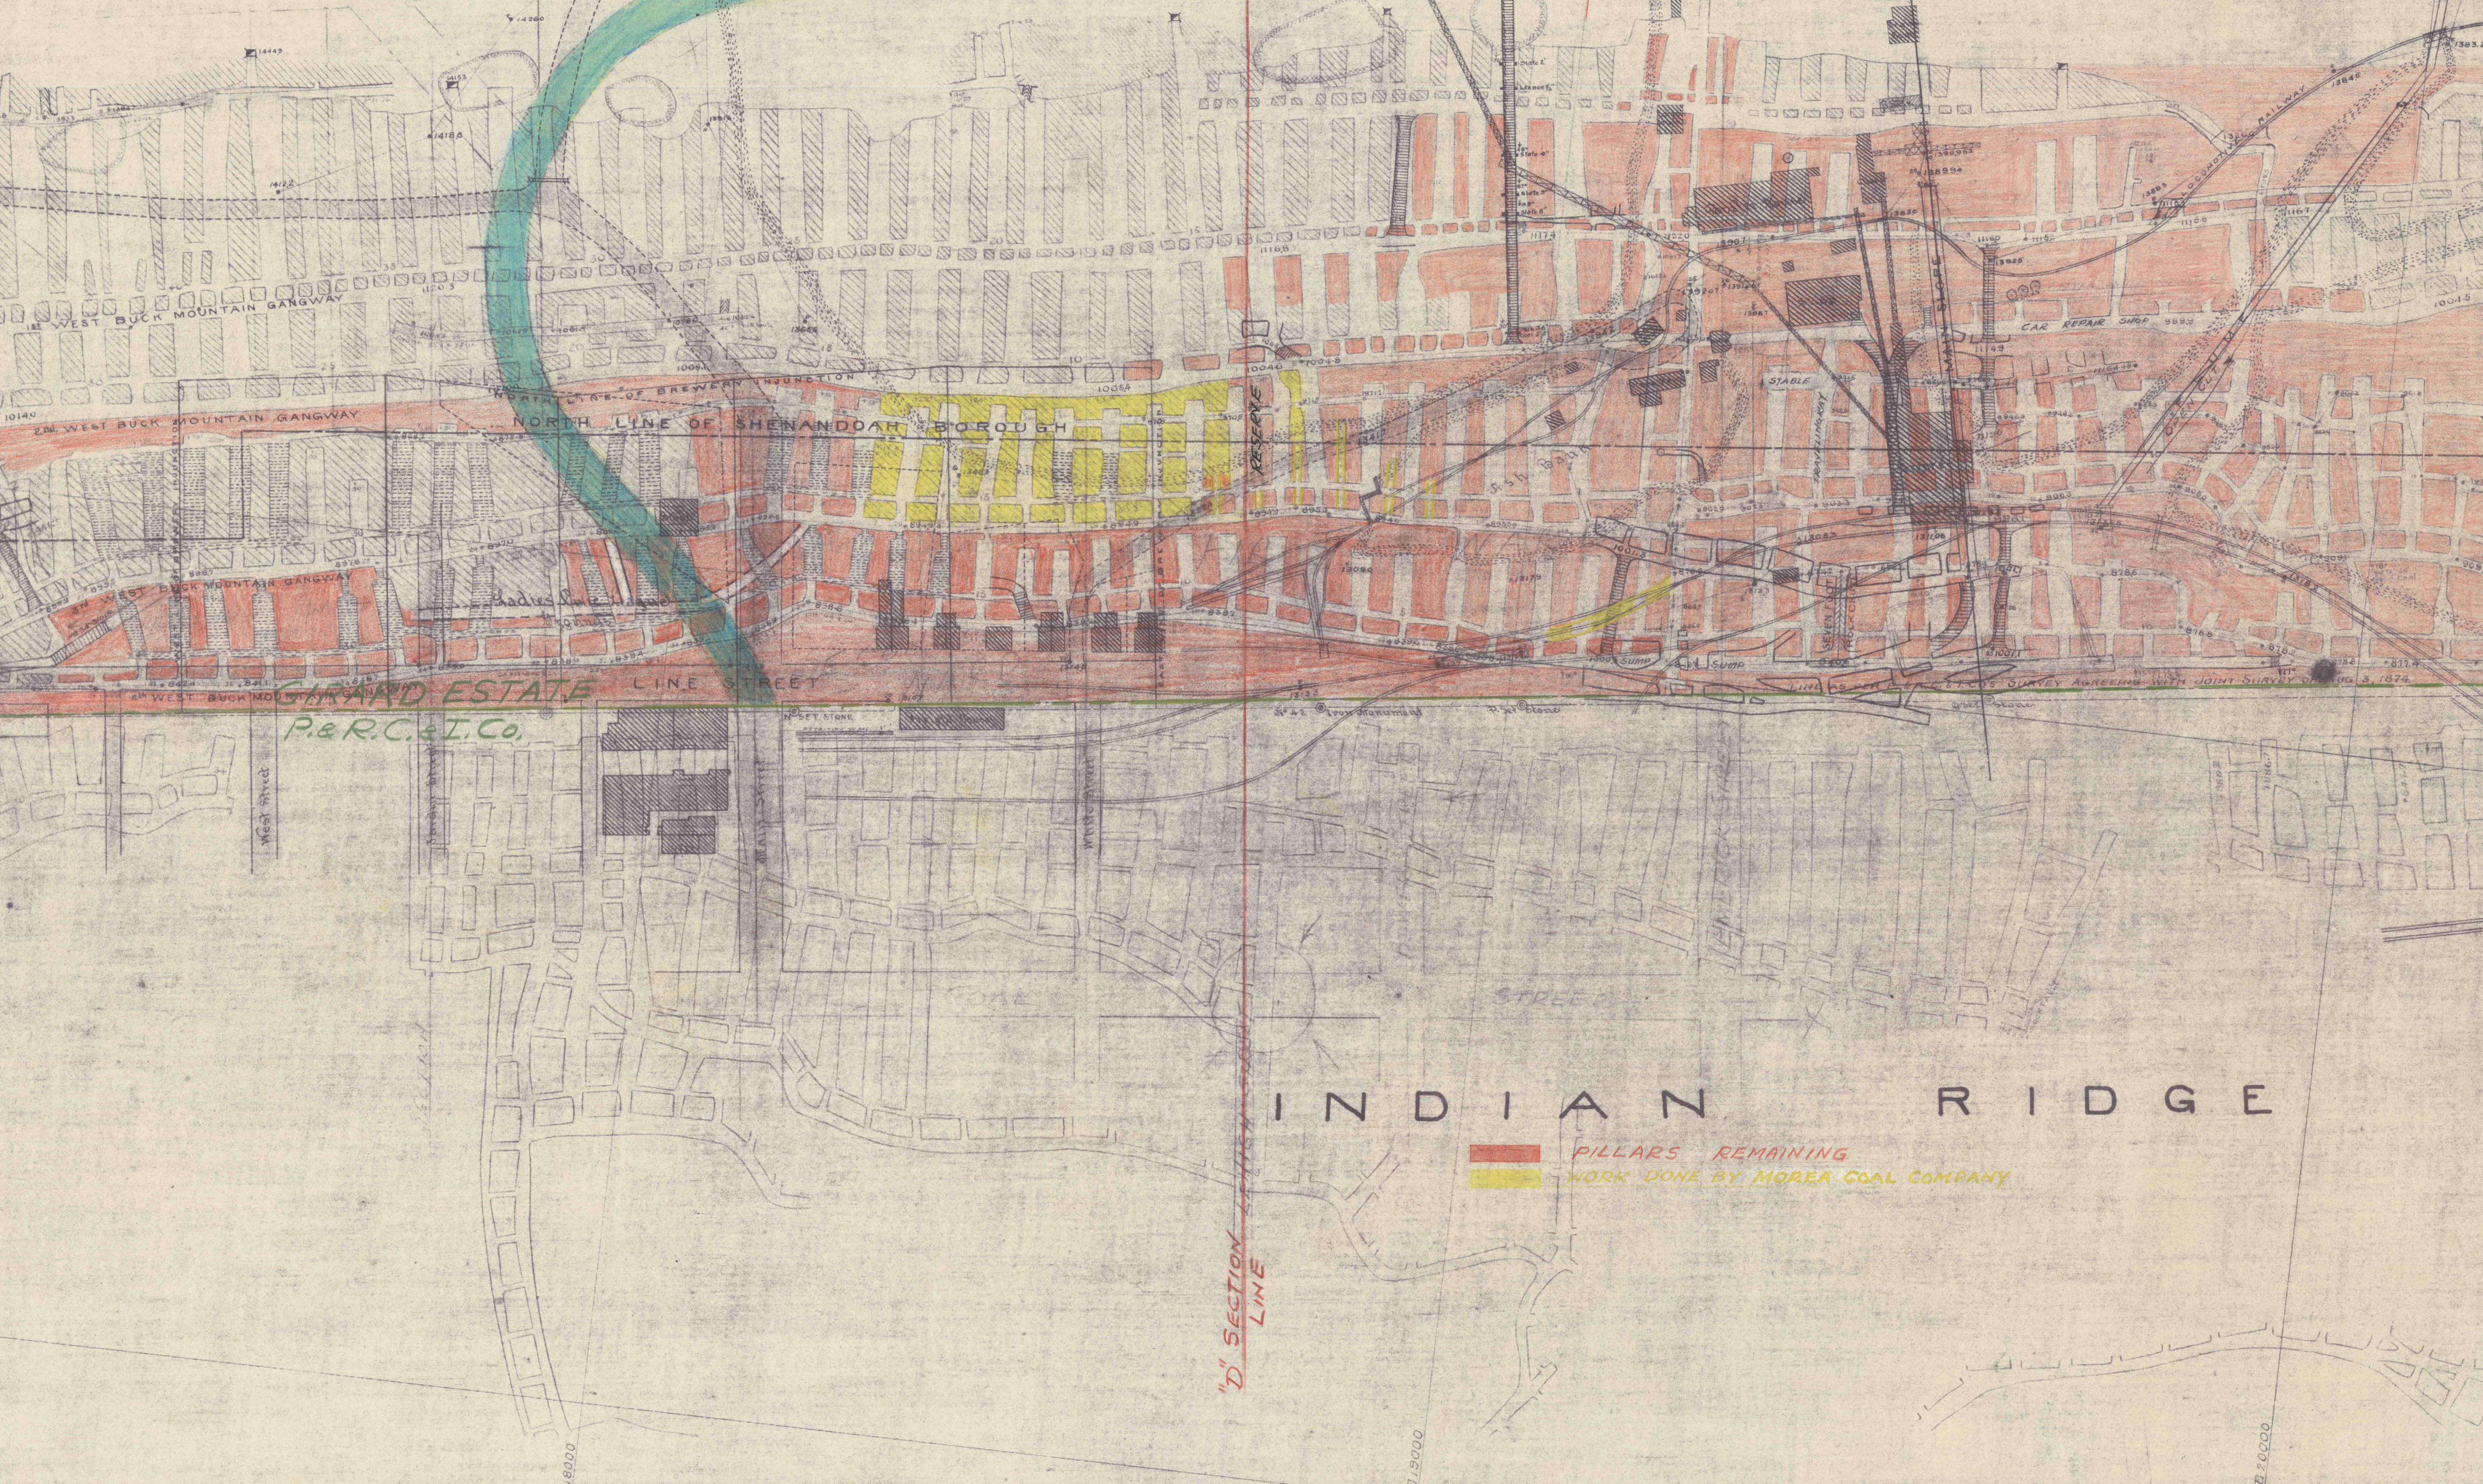

P. & R. C. & I. Co.

INDIAN RIDGE

PILLARS REMAINING
WORK DONE BY MOREA COAL COMPANY