


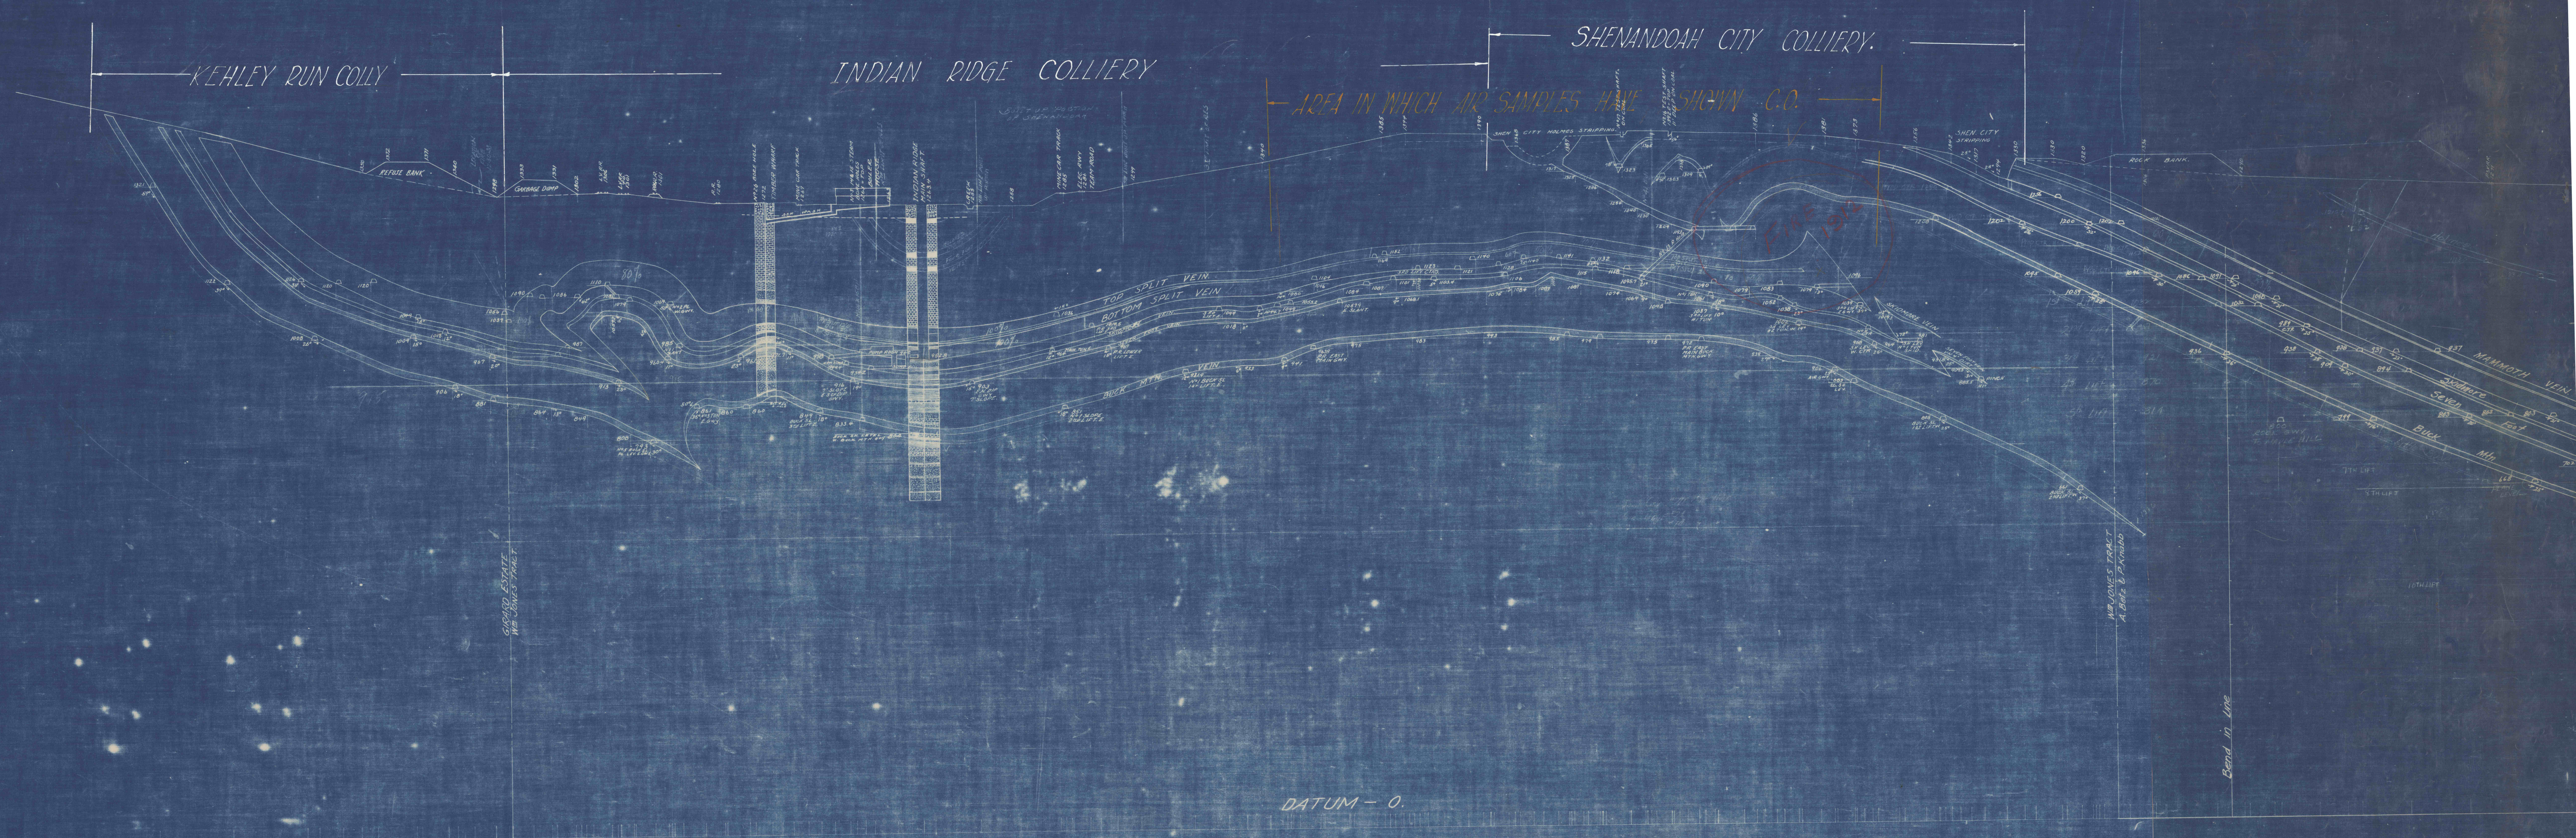

X-12
 Cross Section through Indian Ridge Main Shaft and Parallel to the
 West Line of the William Jones Tract.
 SCALE 1" = 100'
 Shenandoah-Pa. Office Division Engineer.