


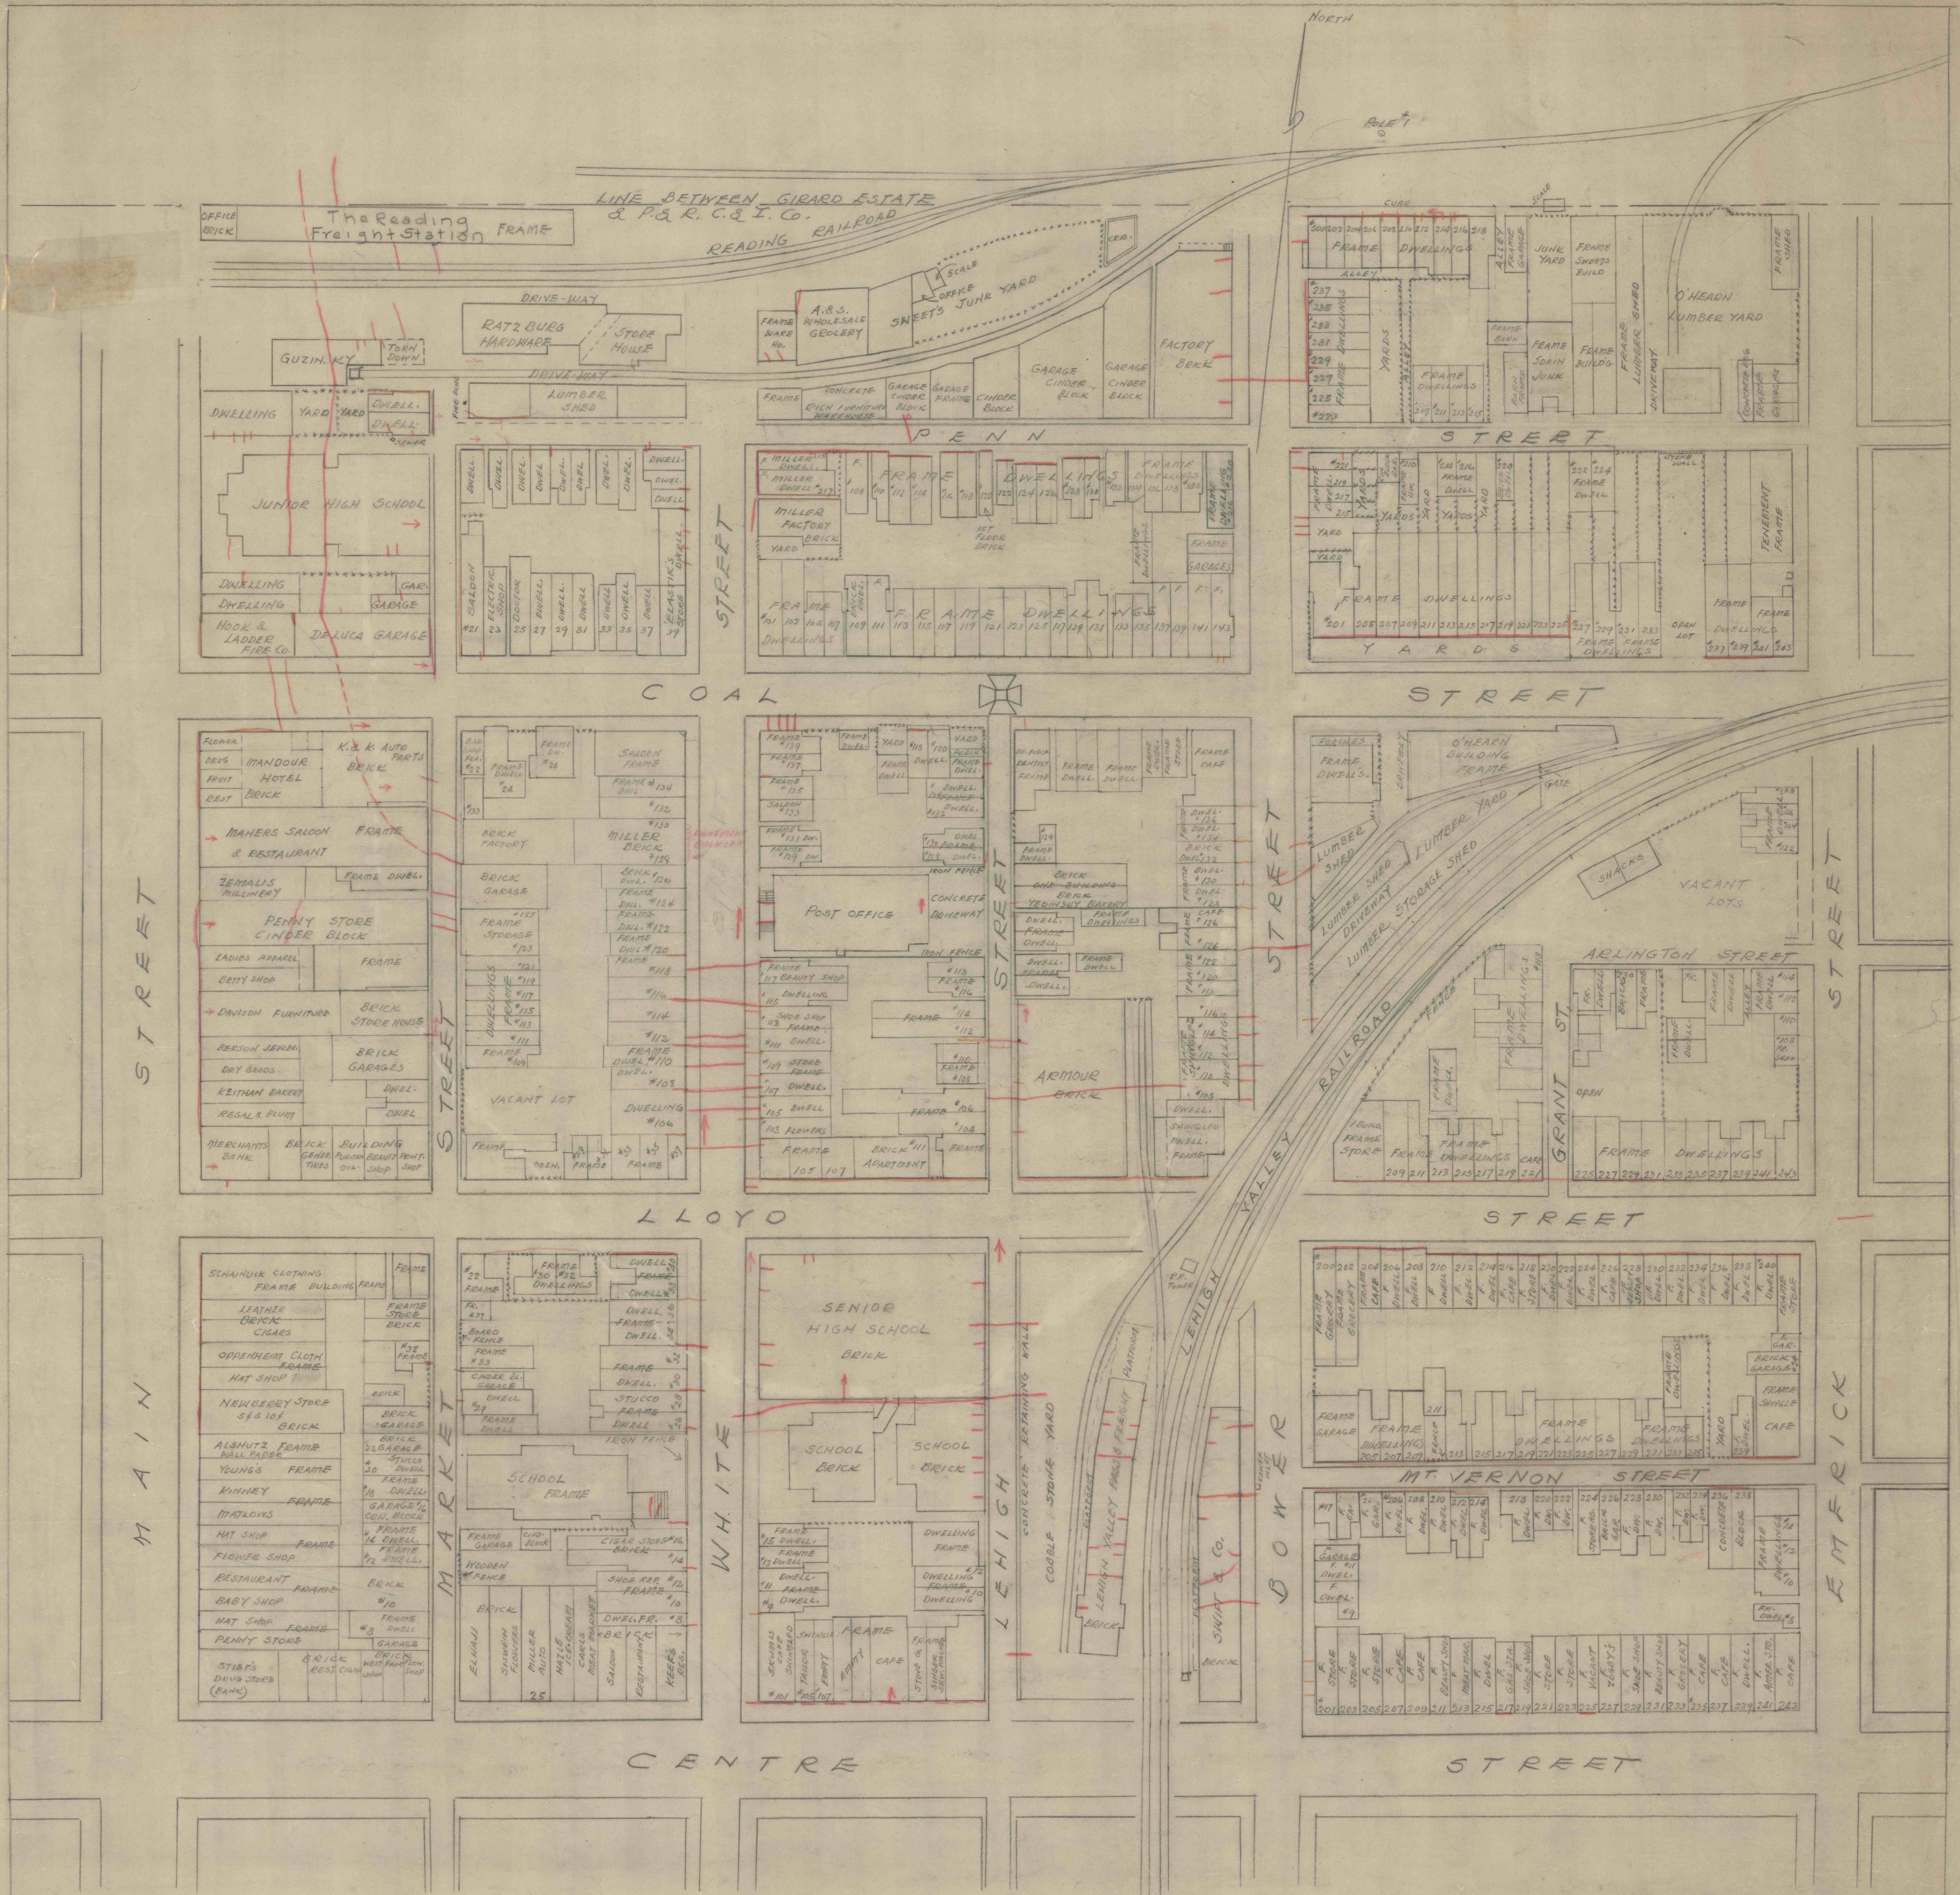

MAP SHOWING
SURVEY OF PORTION OF
SHENANDOAH BOROUGH
SCHUYLKILL COUNTY PA.
STEPHEN GIRARD ESTATE.
W. P. Millington Agent.
Scale 1"=50ft March 7, 1940.