


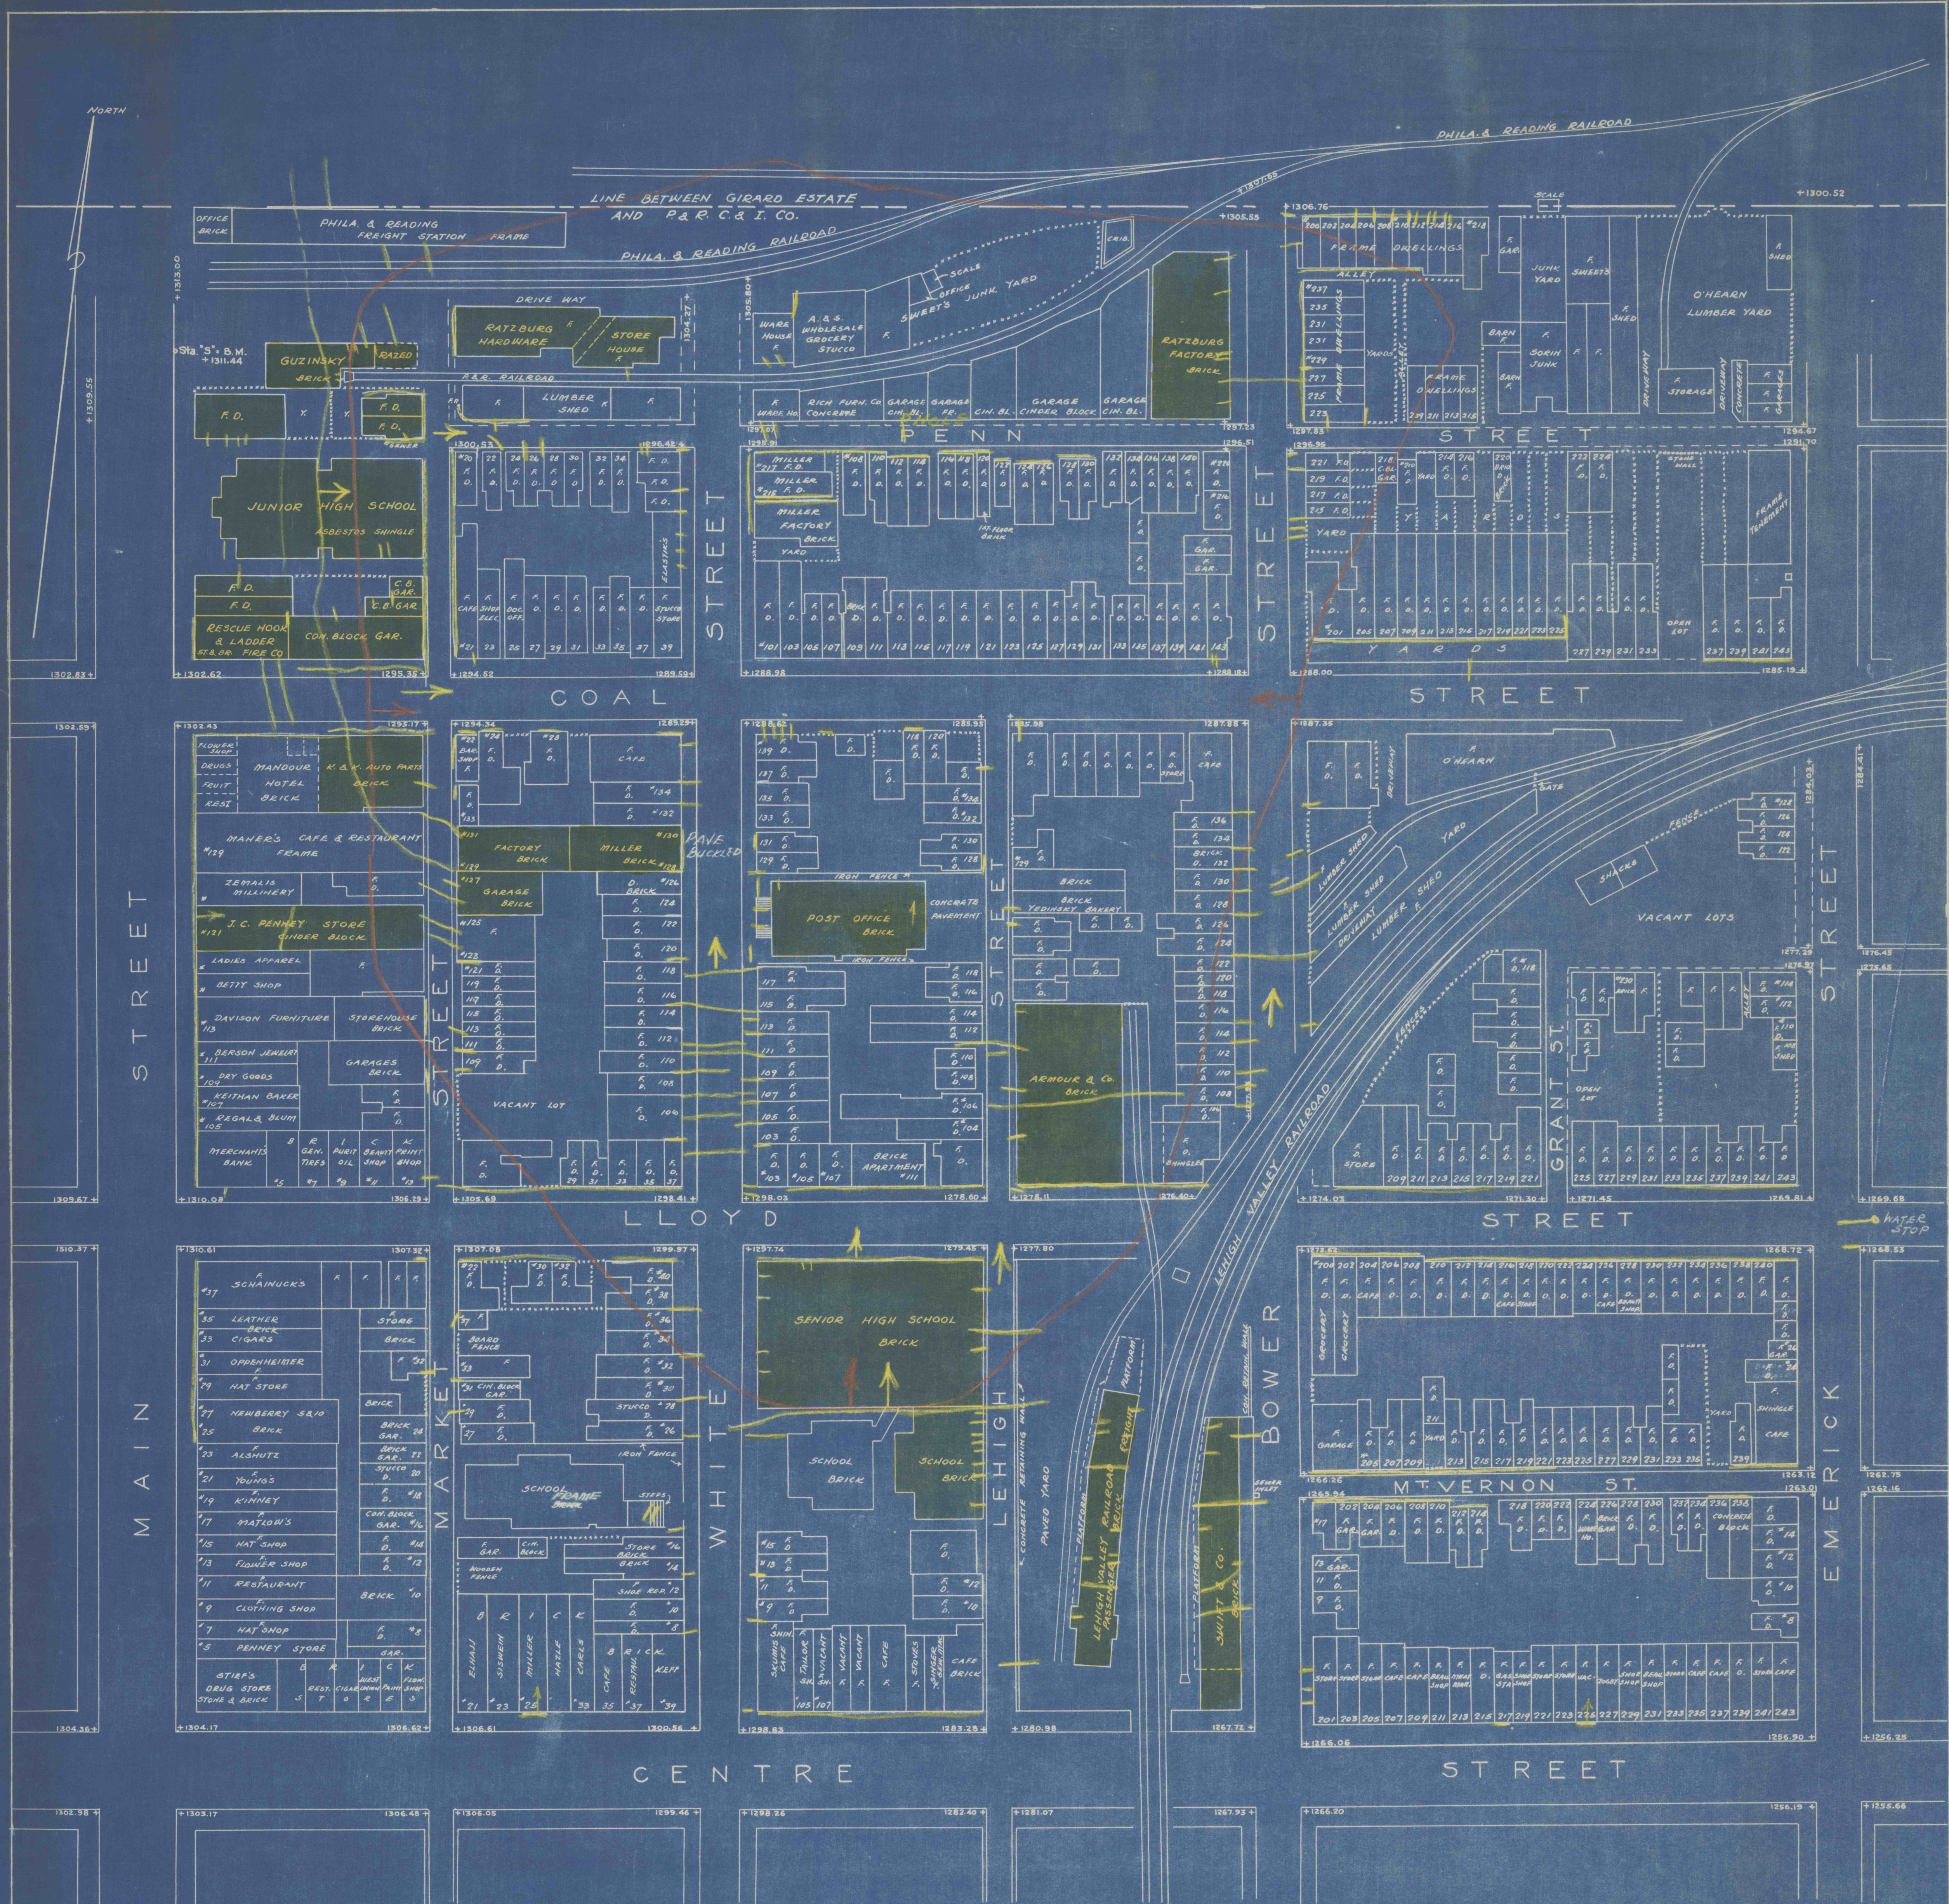

MAP SHOWING
SURVEY OF PORTION OF
SHENANDOAH BOROUGH
SCHUYLKILL COUNTY PA.
MADE FOR
STEPHEN GIRARD ESTATE
W. P. MILLINGTON, AGENT.
Scale 1"=50ft. March 7, 1940. Geo. H. Steidel.