


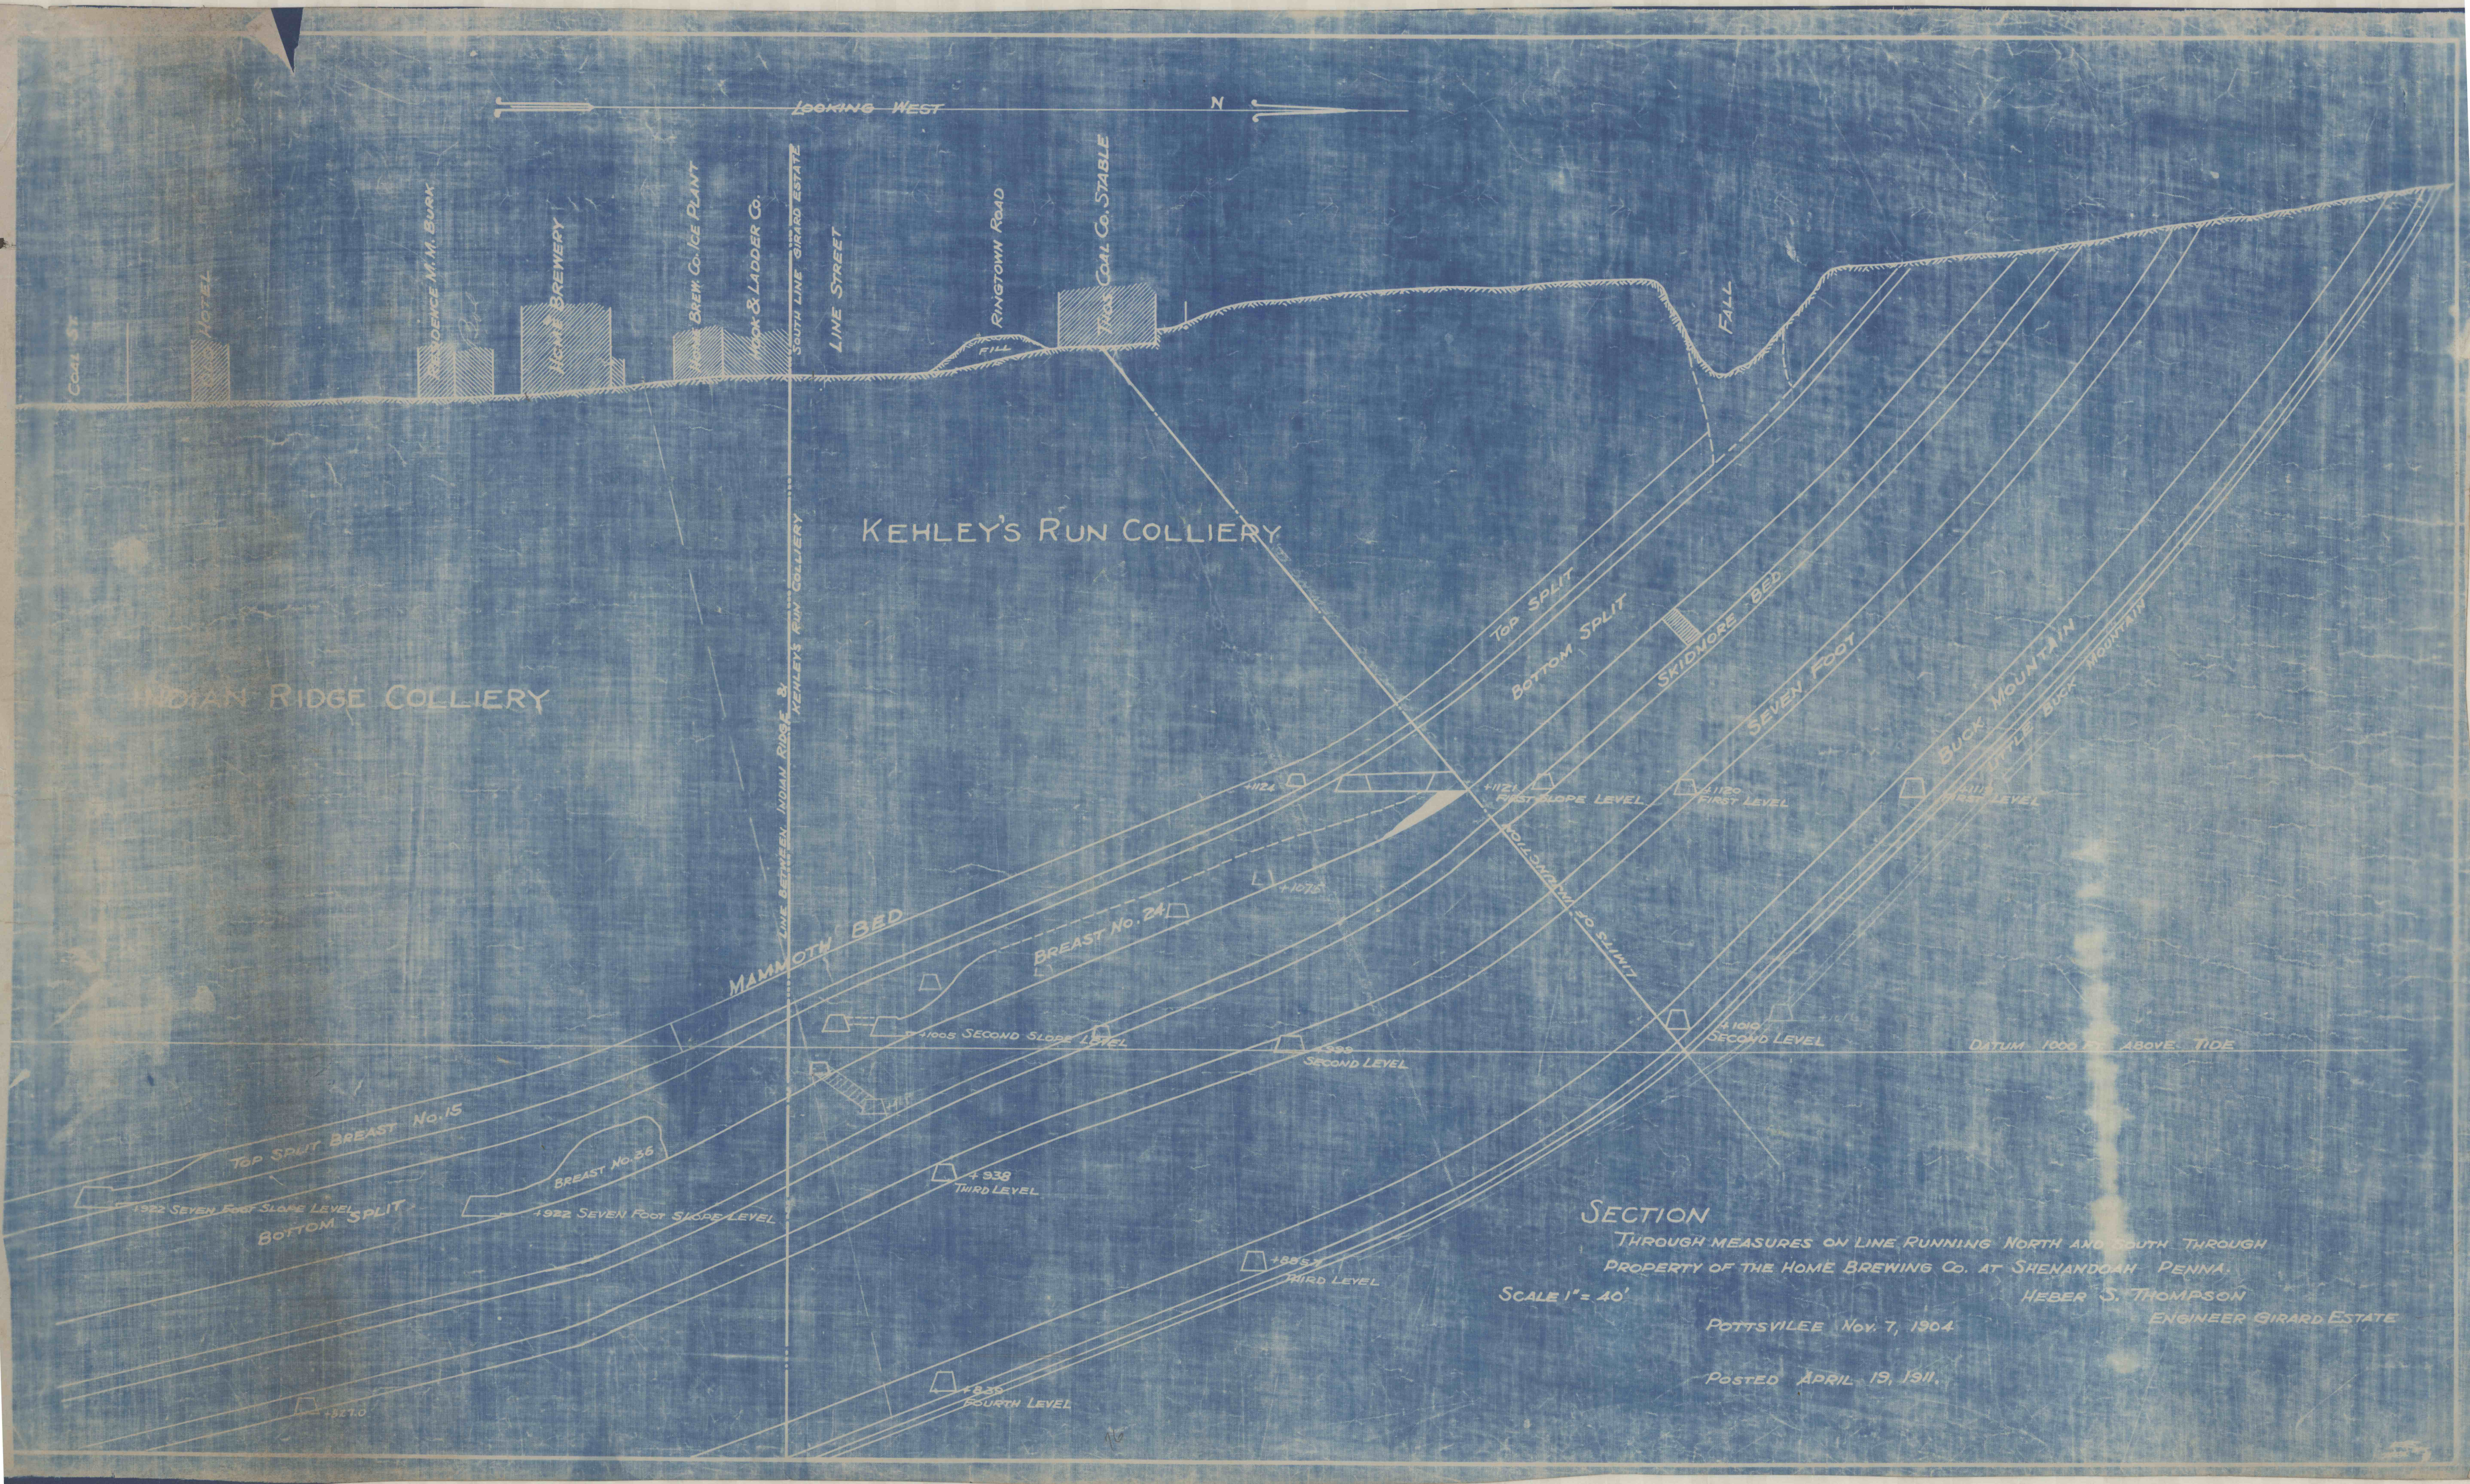

Looking West

N

Coal St

Hotel

Residence M. M. Burk

Home Brewery

Home Brew Co. Ice Plant

Hook & Ladder Co.

South Line Girard Estate

Line Street

Ringtown Road

Thos Coal Co. Stable

KEHLEY'S RUN COLLIERY

INDIAN RIDGE COLLIERY

LINE BETWEEN INDIAN RIDGE & KEHLEY'S RUN COLLIERY

FALL

TOP SPLIT
BOTTOM SPLIT

SKIDMORE BED

SEVEN FOOT

BUCK MOUNTAIN
LITTLE BUCK MOUNTAIN

MAMMOTH BED

BREAST No. 24

TOP SPLIT BREAST No. 15

BREAST No. 36

1922 SEVEN FOOT SLOPE LEVEL
BOTTOM SPLIT

1922 SEVEN FOOT SLOPE LEVEL

1005 SECOND SLOPE LEVEL

999 SECOND LEVEL

1010 SECOND LEVEL

DATUM 1000 FT. ABOVE TIDE

938 THIRD LEVEL

885-7 THIRD LEVEL

835 FOURTH LEVEL

821.0

SECTION

THROUGH MEASURES ON LINE RUNNING NORTH AND SOUTH THROUGH
PROPERTY OF THE HOME BREWING CO. AT SHENANDOAH PENNA.

SCALE 1" = 40'

HEBER S. THOMPSON

ENGINEER GIRARD ESTATE

POTTSVILLE Nov. 7, 1904

Posted April 19, 1911.