

KEHLEY'S RUN COLLIERY  
Mammoth Bed  
Scale 1"=100'

E. 19000  
NORTH

E. 20,000

"D" SECTION LINE

SECTION NO 3  
Box 19 TAG 107

Jeremiah


Jackson Tr

WEST MAHANOY TOWNSHIP

Slate Bank

Slate Bank

LOCOMOTIVE RAILWAY

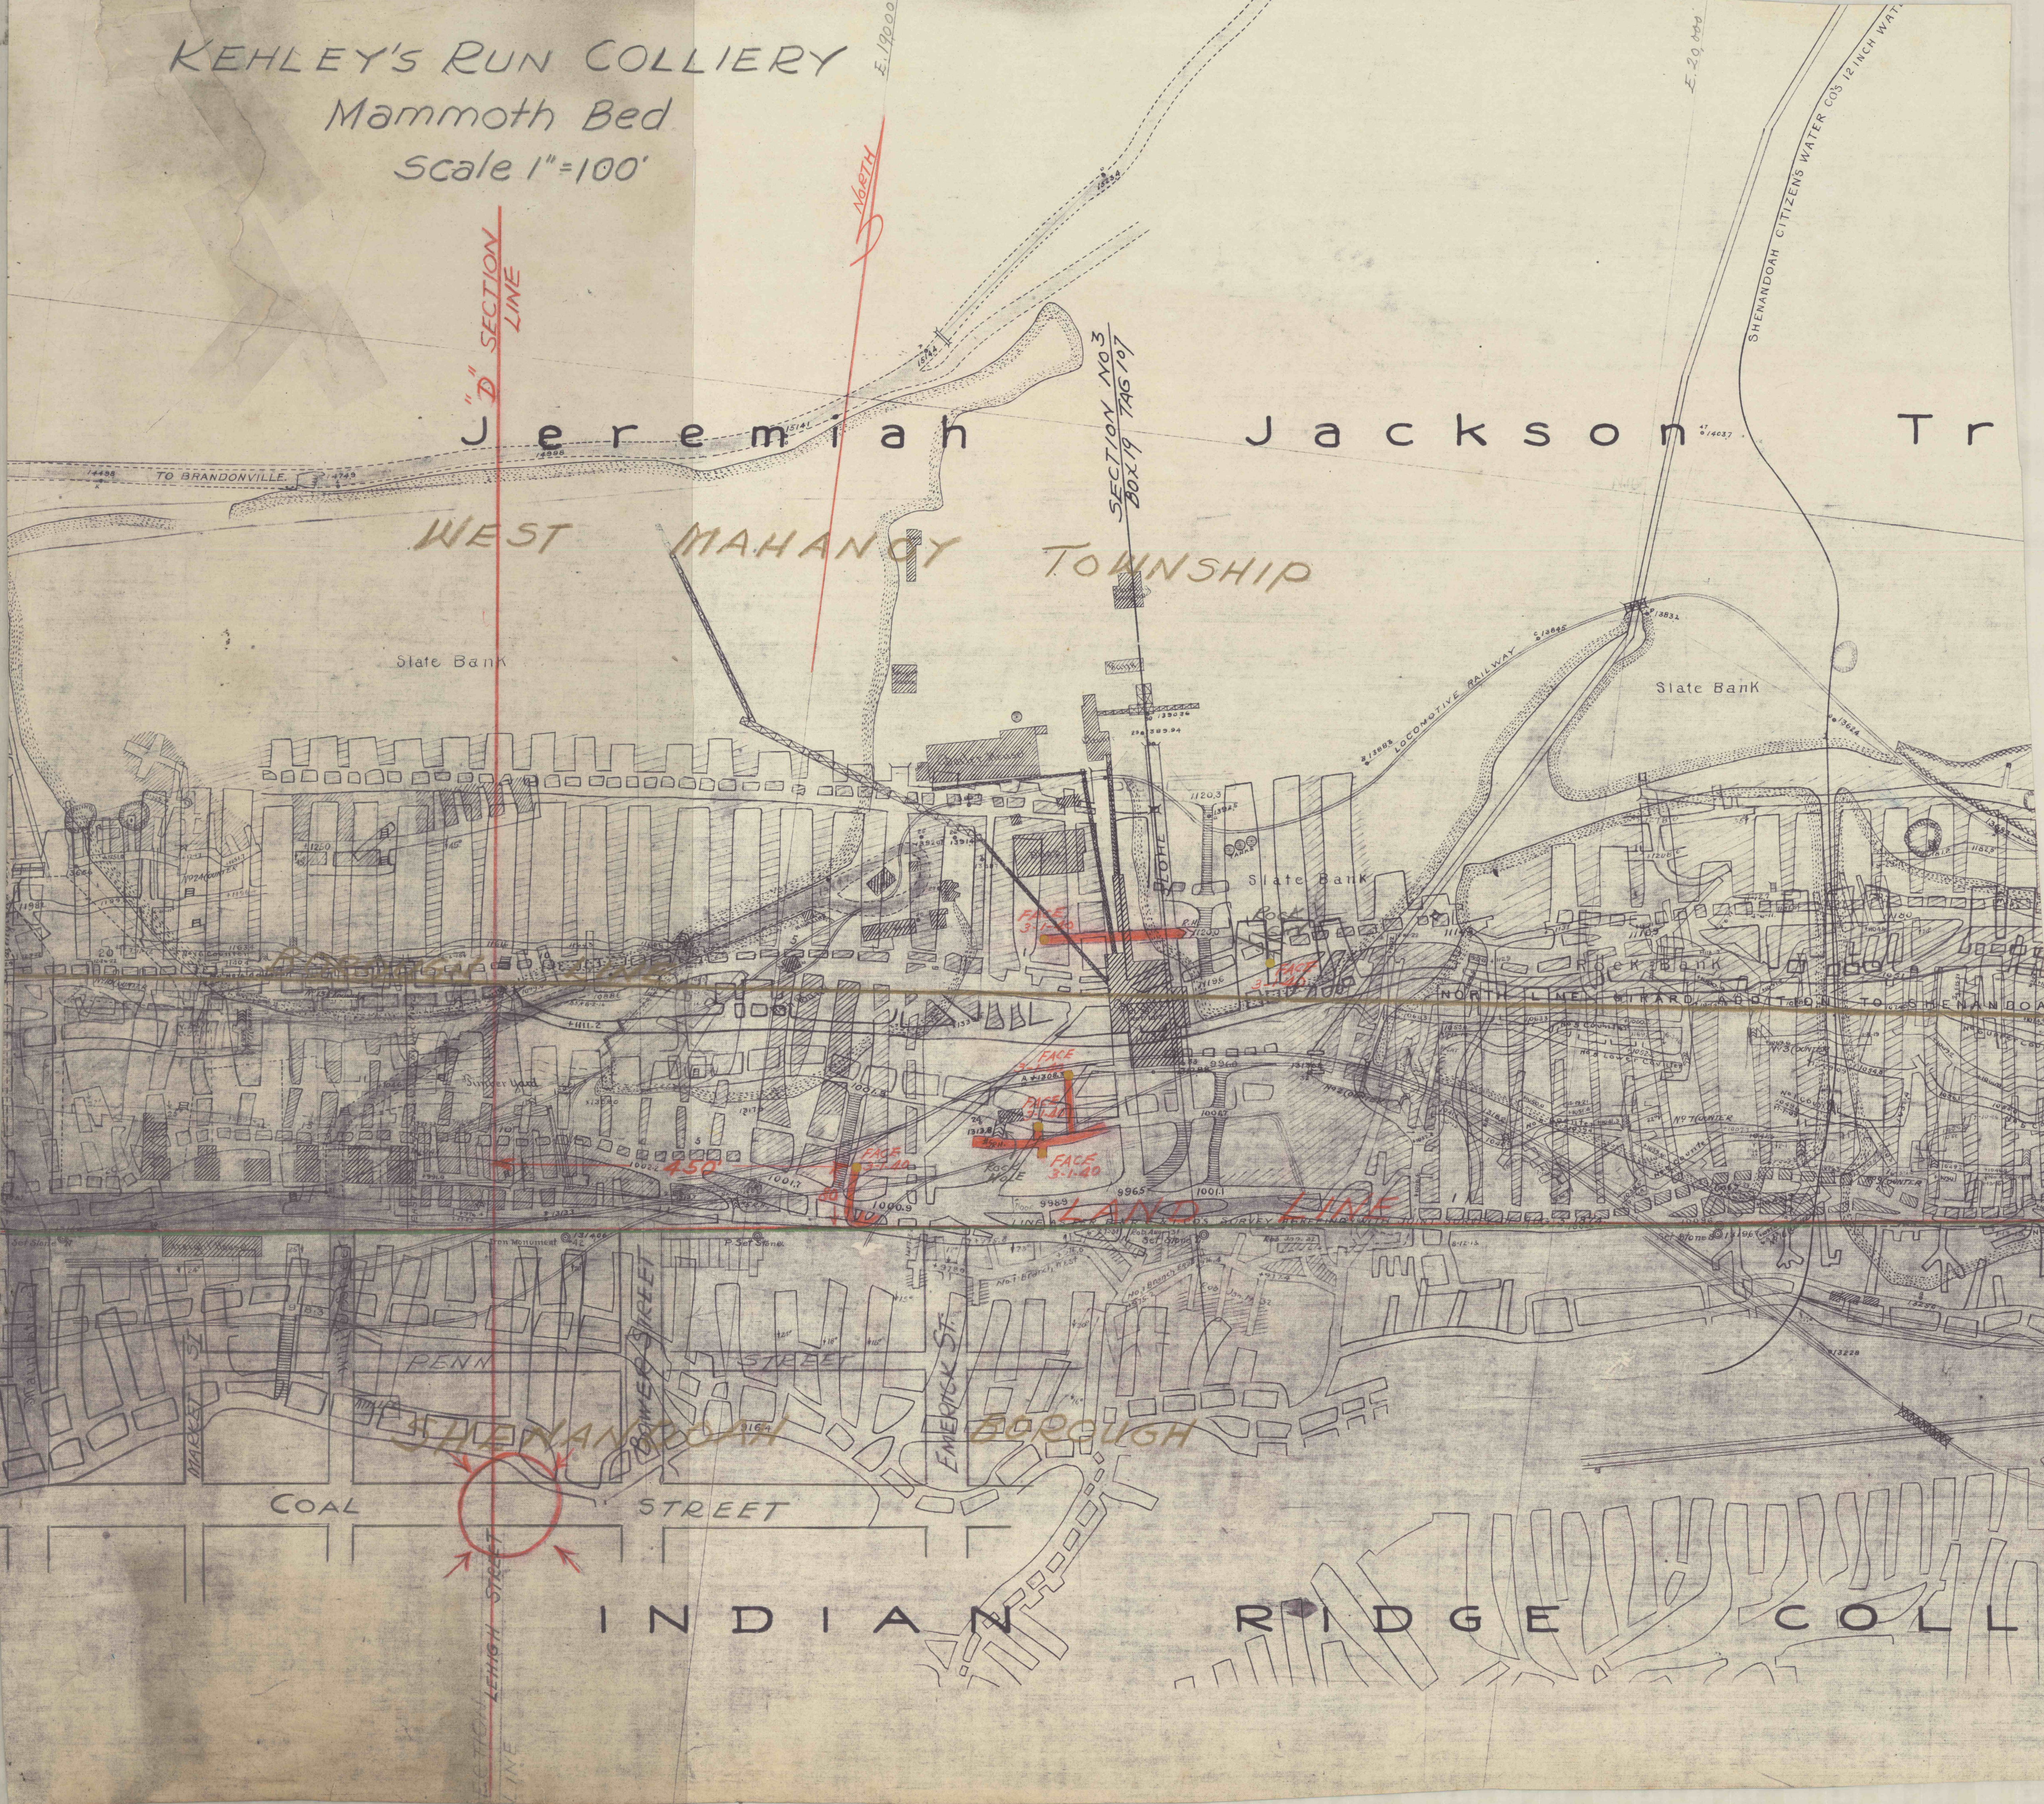

SECTION LEHIGH STREET LINE

INDIAN RIDGE COLLI