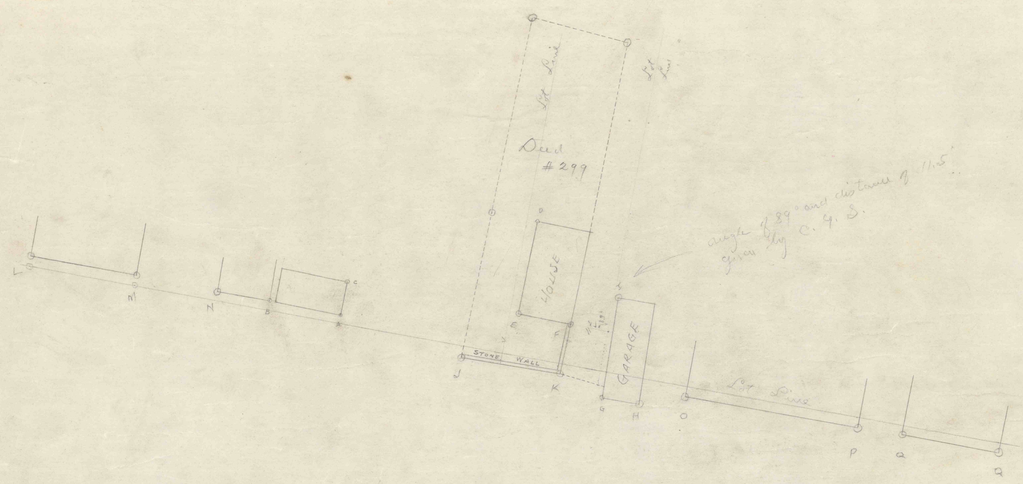Girardville
E. Mahanoy Ave
Deed # 299
Scale 1" = 20'
Dec. 1946