

KIMBERLEY COLLIERY

Skidmore Bed


Scale 1"= 100'

Pottsville Pa.
July 1, 1927.

James Archbald
MINING ENGINEER & AGENT
GIRARD ESTATE

C O N R A D M E R T Z T R A C T

GEORGE FLOWER
TRACT

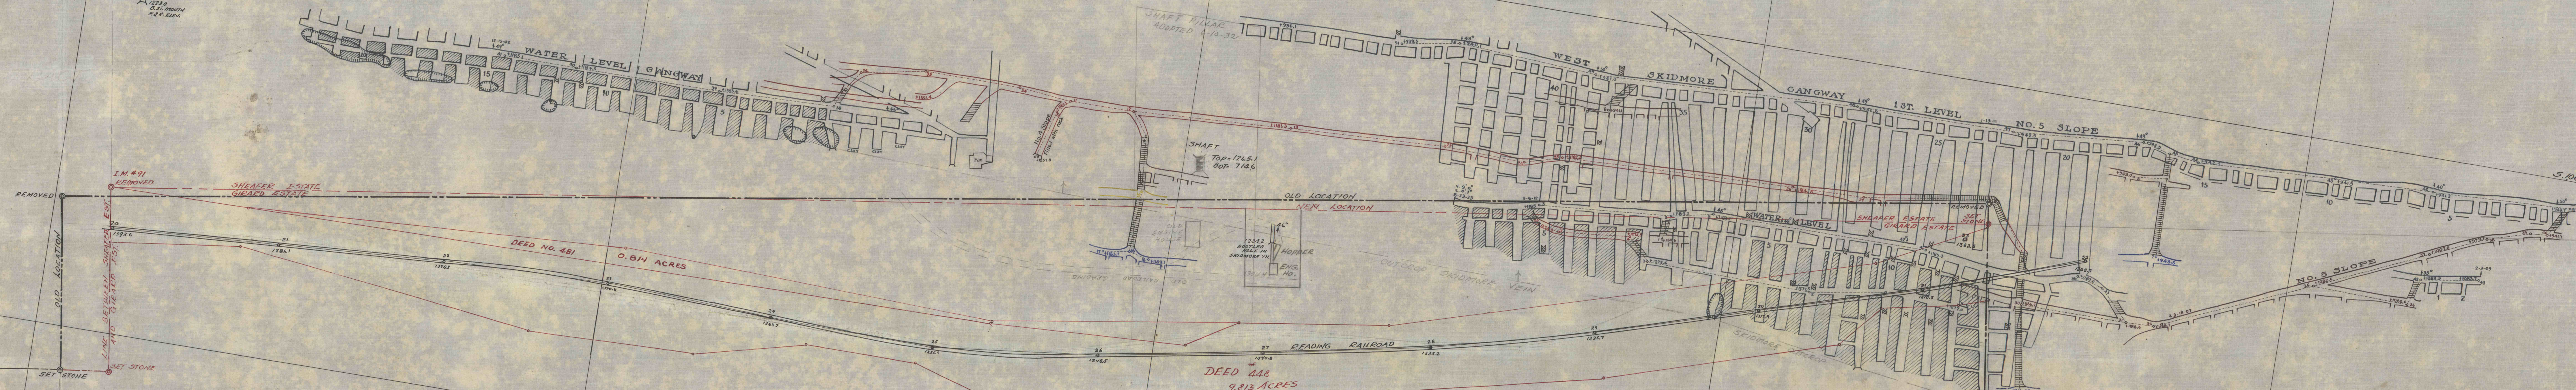

JOHN BLAKEY
TRACT
SOUTHERN PORTION

PETER BENSON TRACT

THOMAS PASCHALL TRACT
SOUTHERN PORTION