


MAP Showing position of SQUATTERS HOUSES Mahanoy Plane Scale 100 feet to 1 Inch

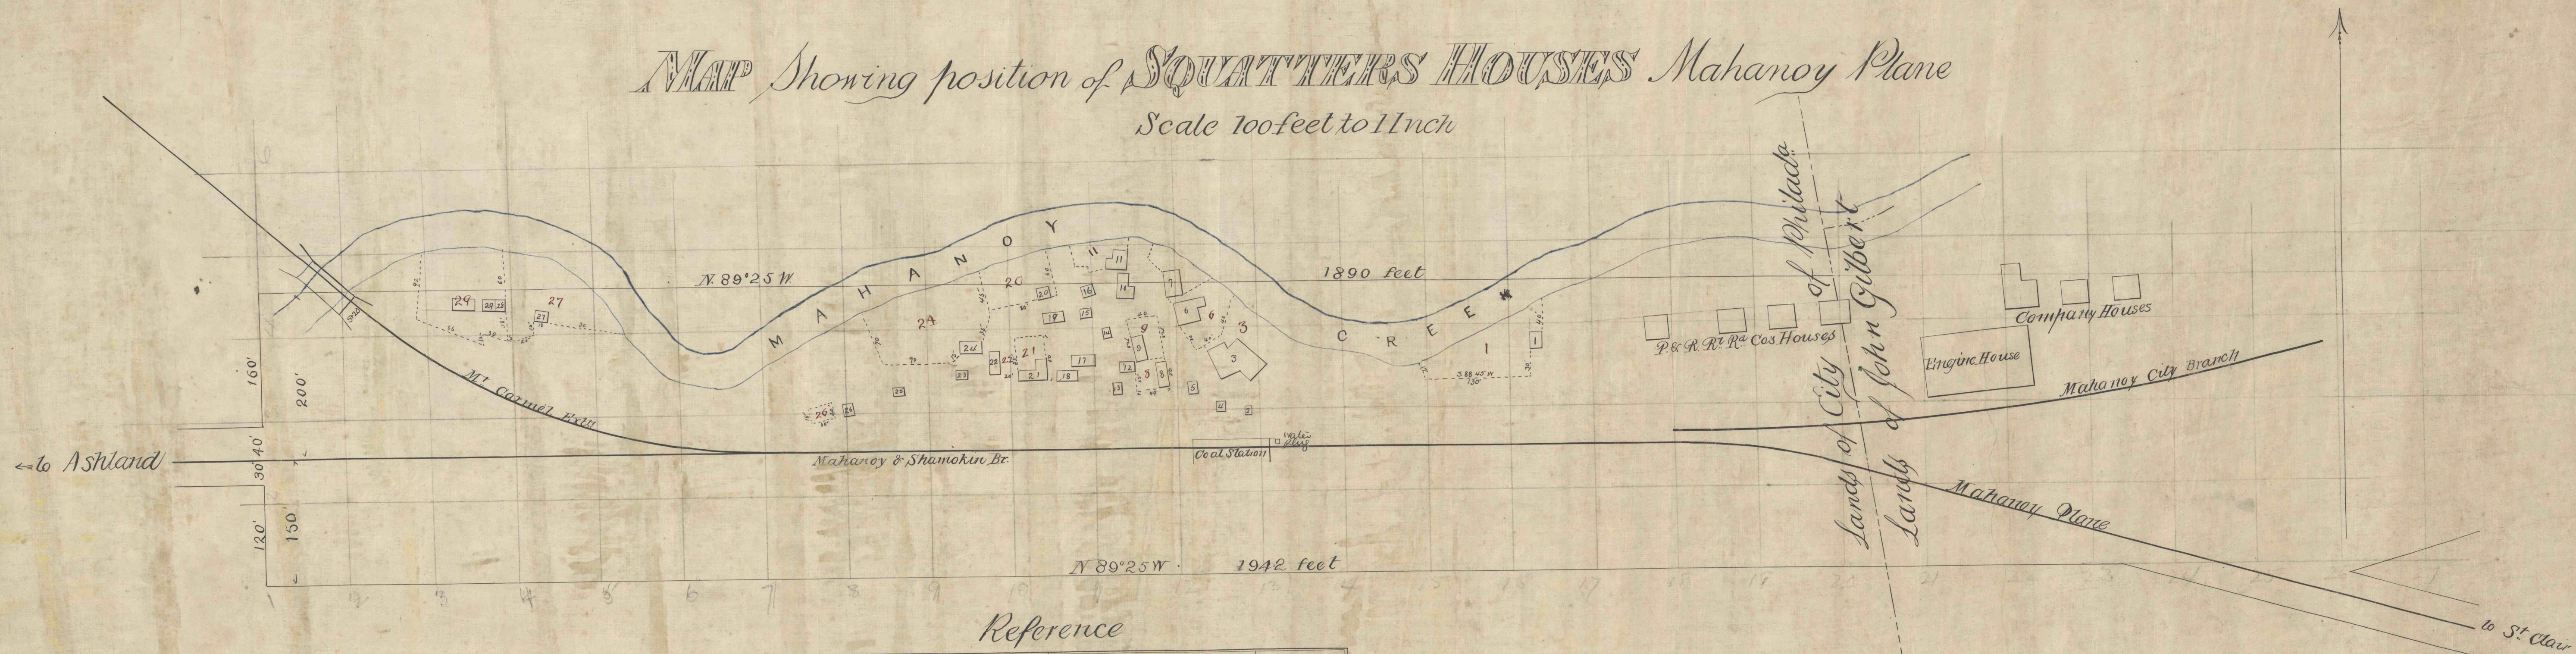

Reference

No of Buildings	Name of Owner	Description	No of Buildings	Name of Owner	Description
1	Cornelius Quinn	Dwelling Ho.	16	Patrick Enmy	Shoemaker Shop
2	Wm. Walker	Shoemaker Shop	17	Patrick Enmy	Dwelling House
3	Wm. Edwards	Hotel & Store	18	Thomas Kirby	" "
4	"	Ice House	19	Edw. M. Doherty	" "
5	"	Dwelling Ho.	20	Mr. Margaret McLean	" "
6	Thomas Murphy	" "	21	James Meade	" "
7	John Fitzpatrick	Store	22	Patrick Joyce	" "
8	Wm. Radley	Dwelling Ho.	23	Henry Muehan	" "
9	Wm. Edwards	Stable	24	"	" "
10	Mrs. Barbara Kelley	Dwelling Ho.	25	Donnick Colahan	" "
11	Mrs. Mary McLaughlin	" "	26	Samuel Burke	" "
12	Patrick Flynn	" "	27	James Hawley	" "
13	Wm. McAndrew	" "	28	Wm. Vaughan	" "
14	Annals O'Malley	" "	29	Edward Laughon	" "
15	Thos. Coe	" "			