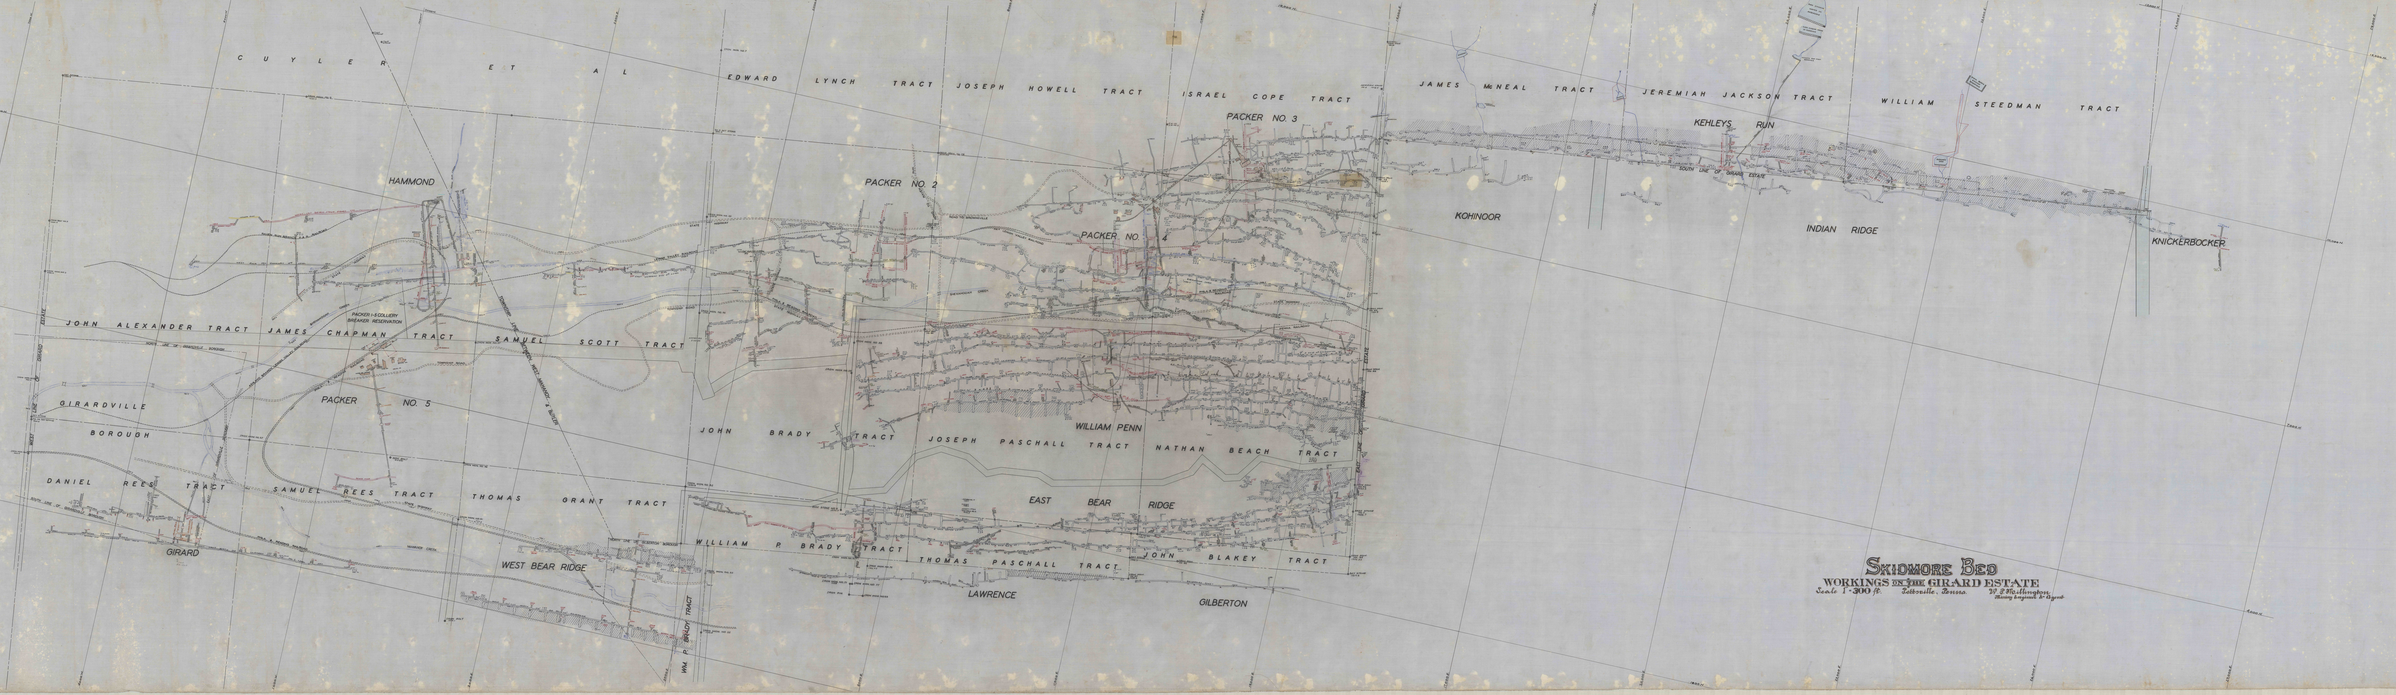

SKIDMORE BED

WORKINGS OF THE GIRARD ESTATE

Scale 1-300 ft. Tottsville, Pennsa. W. P. Hutchinson, Mining Engineer & Surveyor