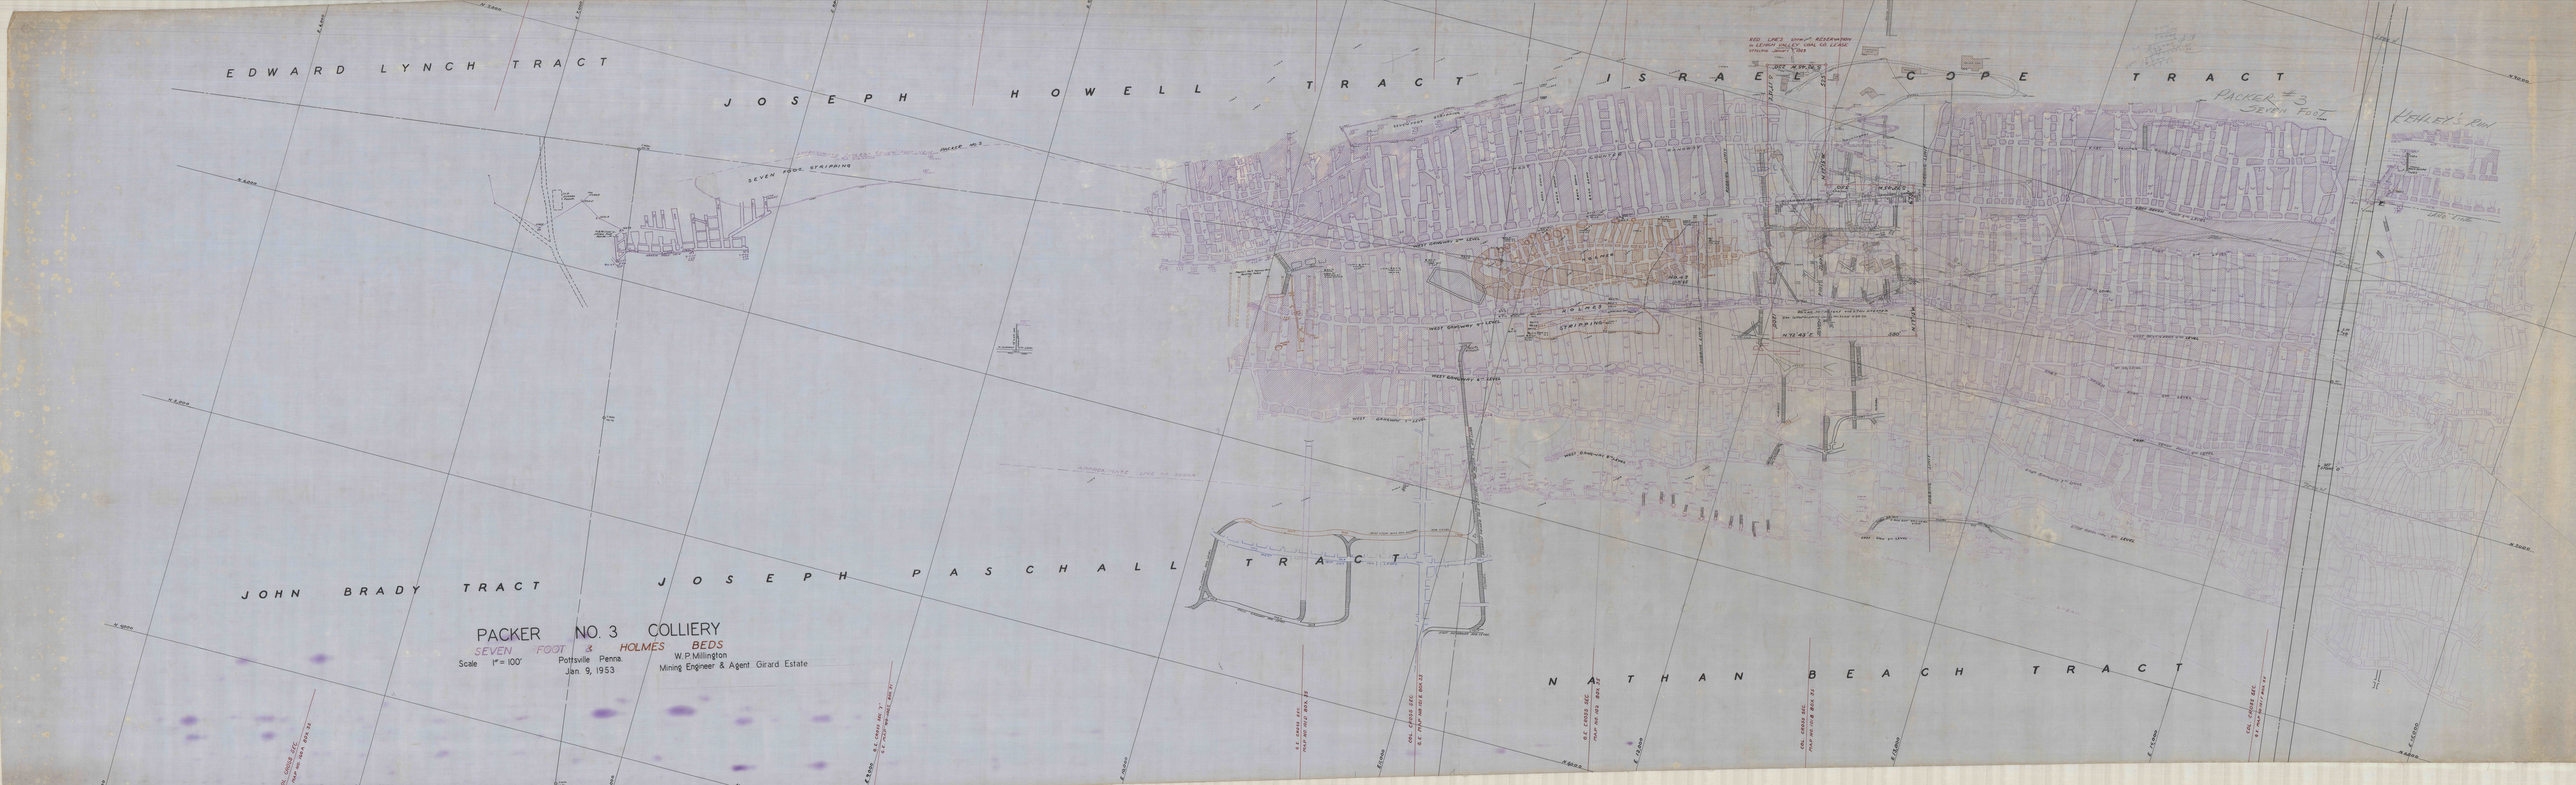

EDWARD LYNCH TRACT
JOSEPH HOWELL TRACT
ISRAEL COPE TRACT
JOHN BRADY TRACT
JOSEPH PASCHALL TRACT
NATHAN BEACH TRACT
PACKER NO. 3 COLLIERY
SEVEN FOOT & HOLMES BEDS
Scale 1" = 100'
Pottsville Penna.
Jan. 9, 1953
W.P. Millington
Mining Engineer & Agent Girard Estate
SEVEN FOOT STRIPPING
HOLMES STRIPPING
PACKER #3 SEVEN FOOT
KEHLER'S RUN