


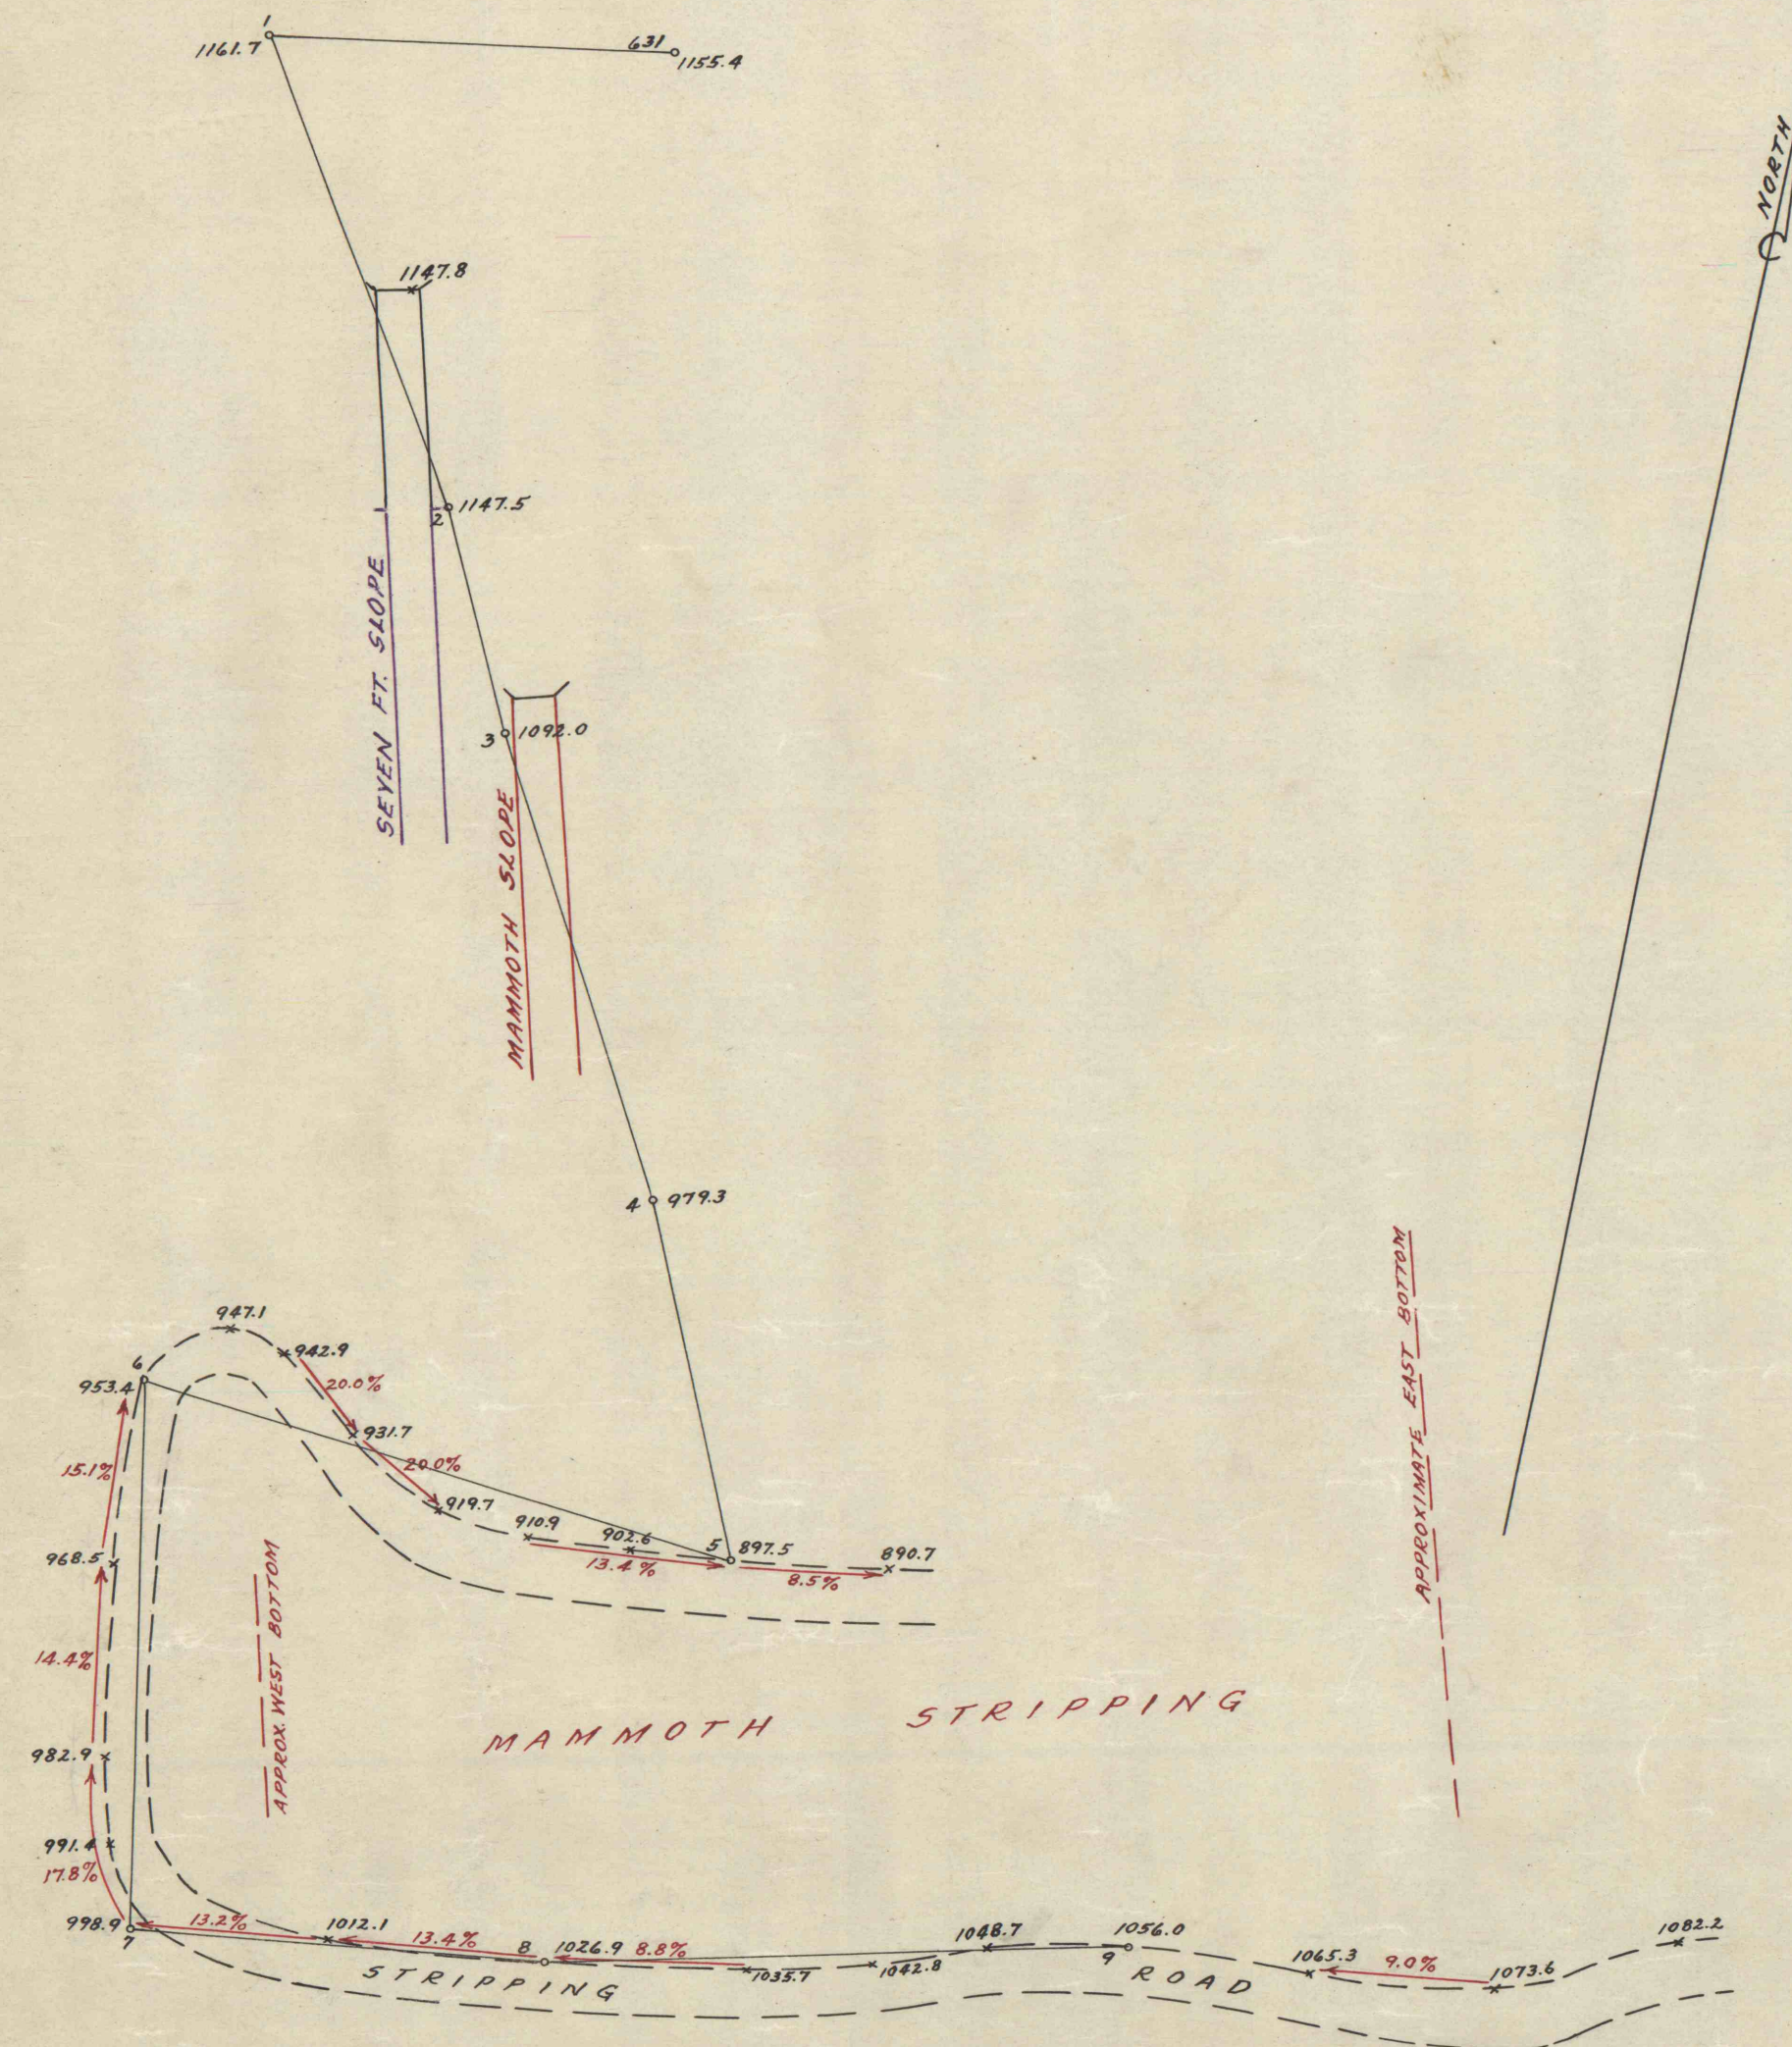

PLAN SHOWING ROAD INTO PACKER #4, No. 10
MAMMOTH STRIPPING

1" = 100'
APRIL 24, 1952

W.P. MILLINGTON
MINING ENGINEER & AGENT