
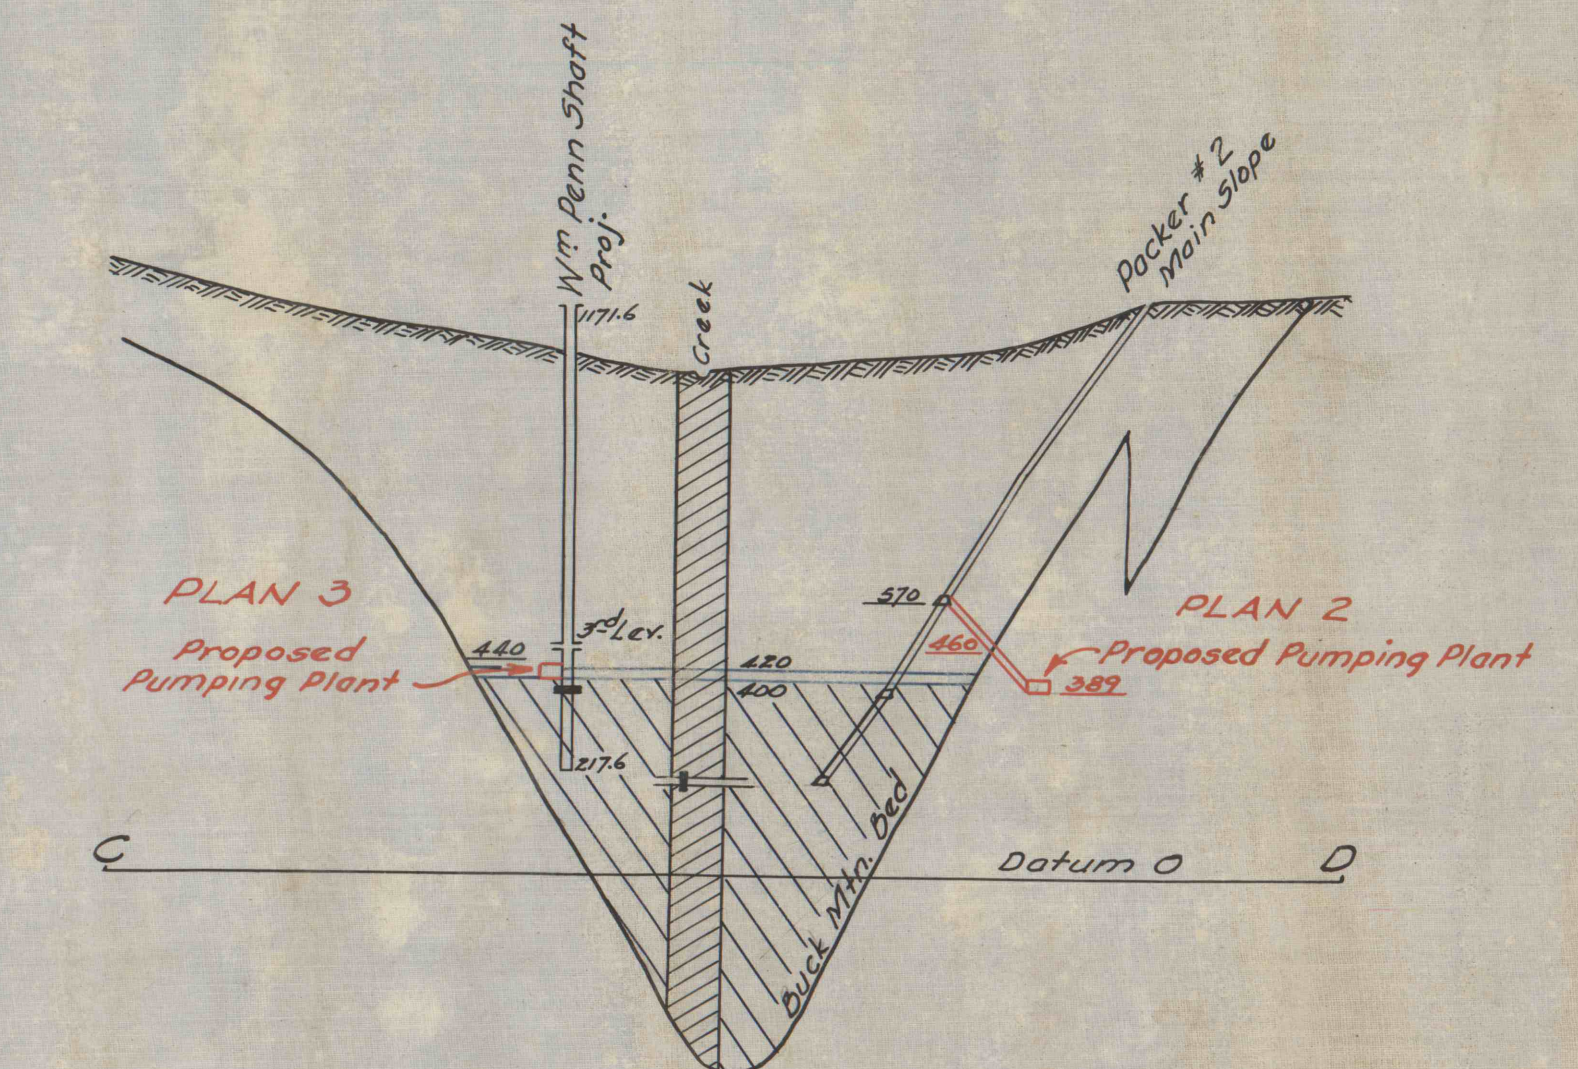
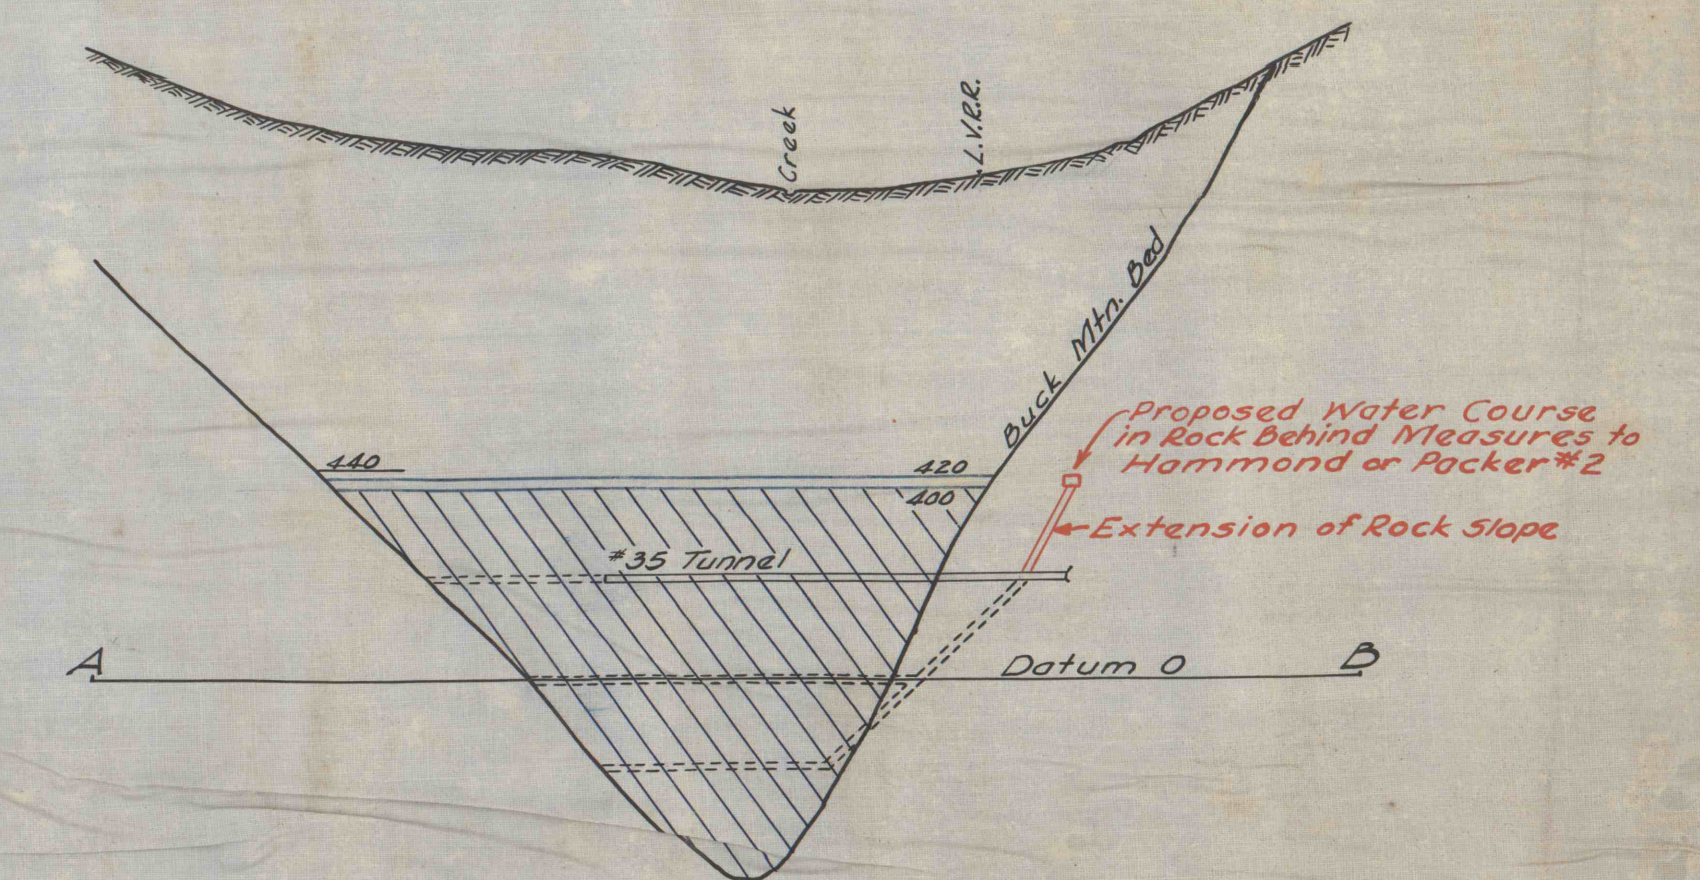
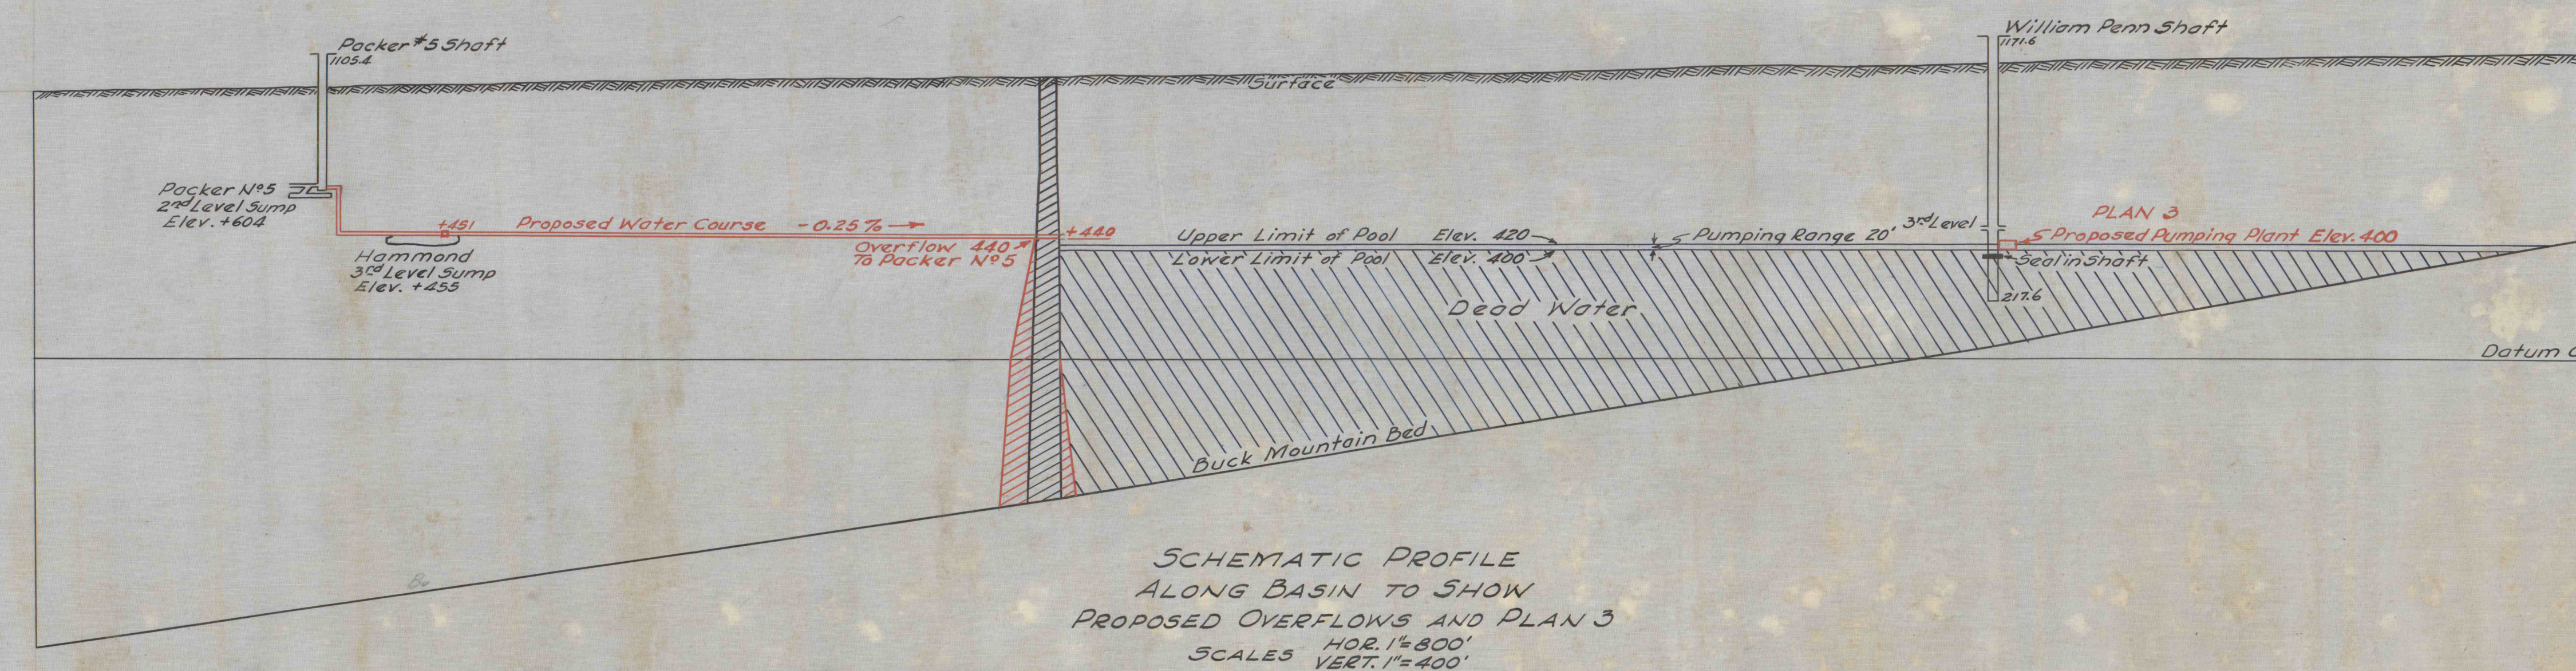
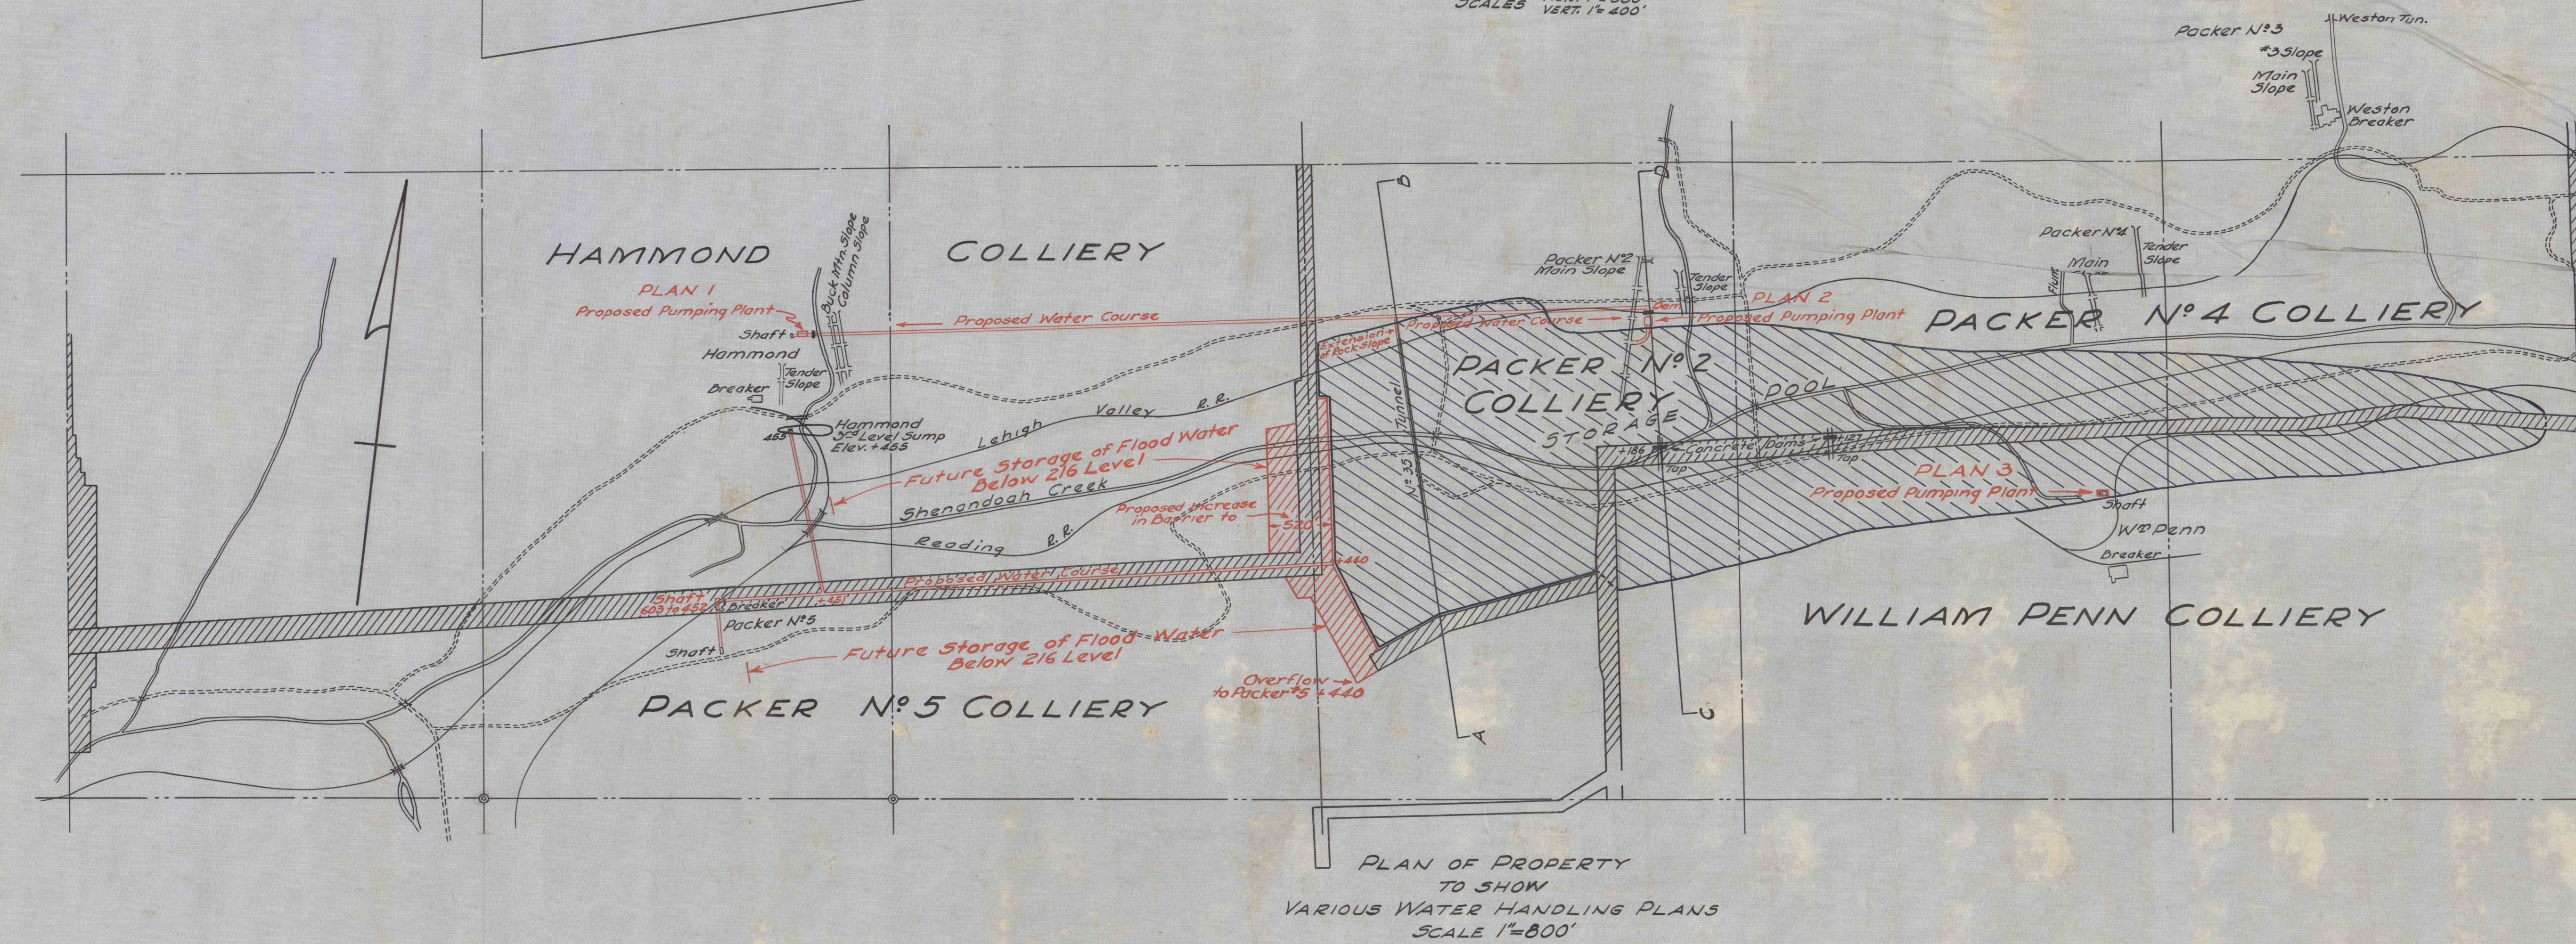


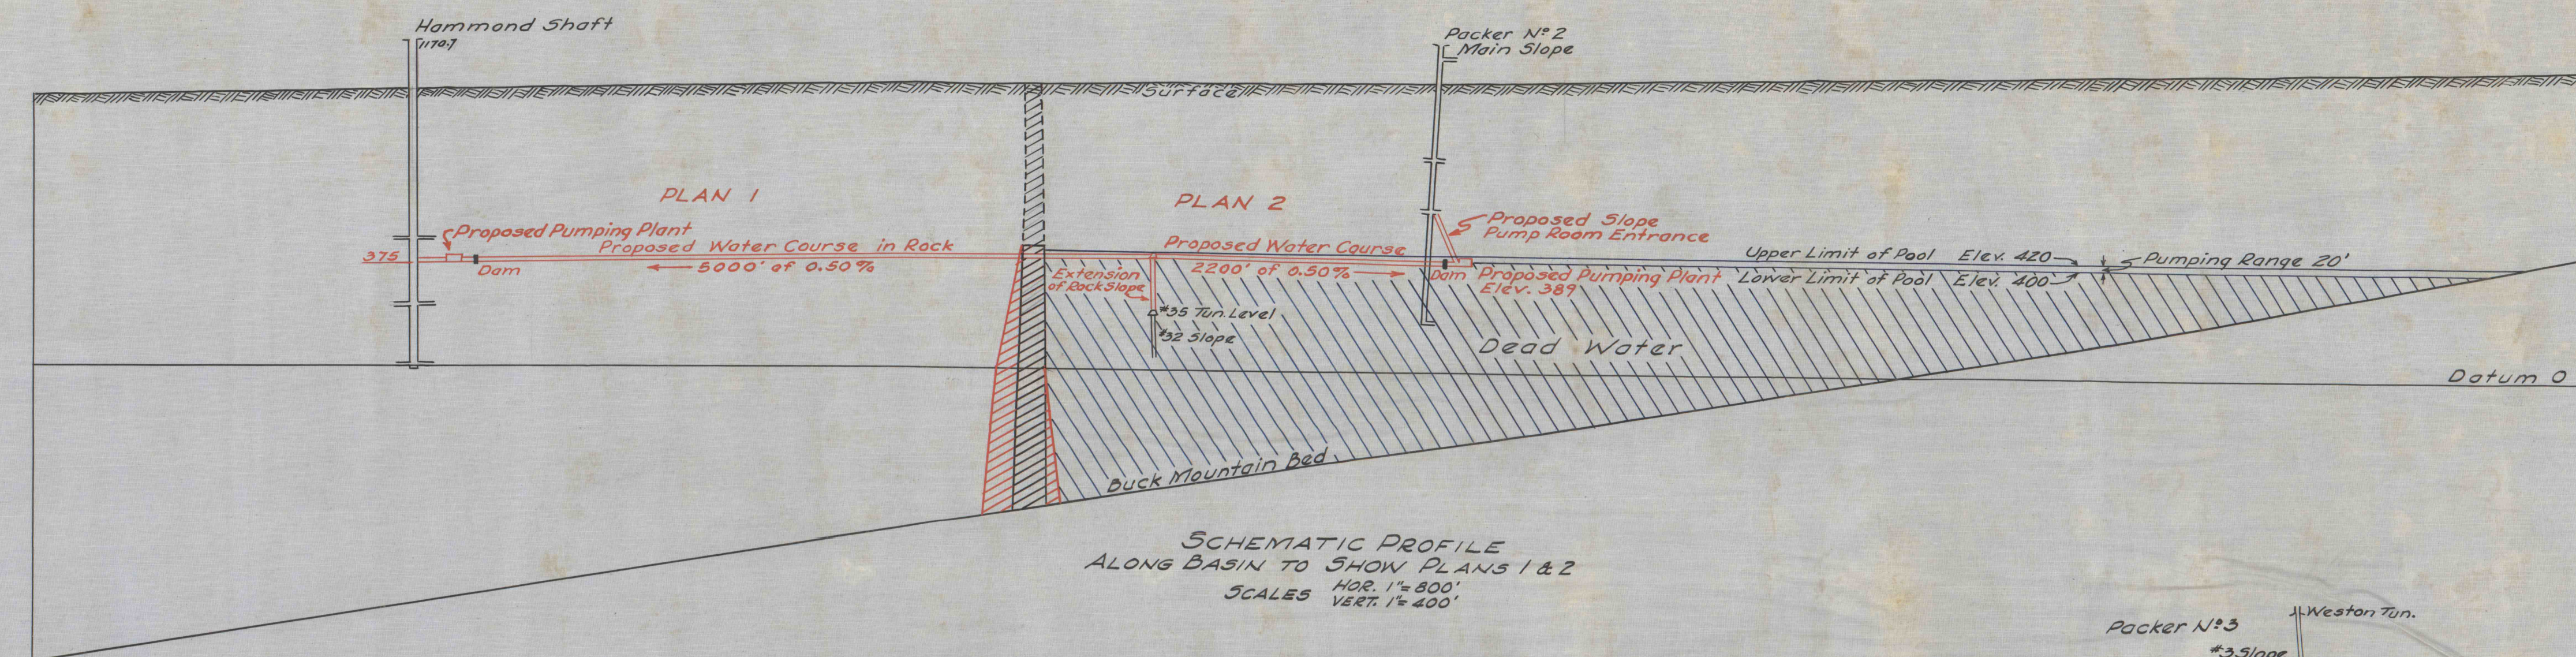

MAP AND SECTIONS
TO ACCOMPANY REPORT ON
PREVENTION OF INFLOW
AND
HANDLING MINE WATER
IN
GIRARD ESTATE PROPERTY
SHENANDOAH TO GIRARDVILLE
J.F.K. BROWN, ENGINEER SCRANTON, PA.
SCEALED AS SHOWN NOVEMBER, 1944