


BOOTLEG SLOPE
IN BUCK MTN YEIN
CONNECTS W. SHEN
TO PACKER NO 4

11837

NO 2 BUCK MTN STRIPPING

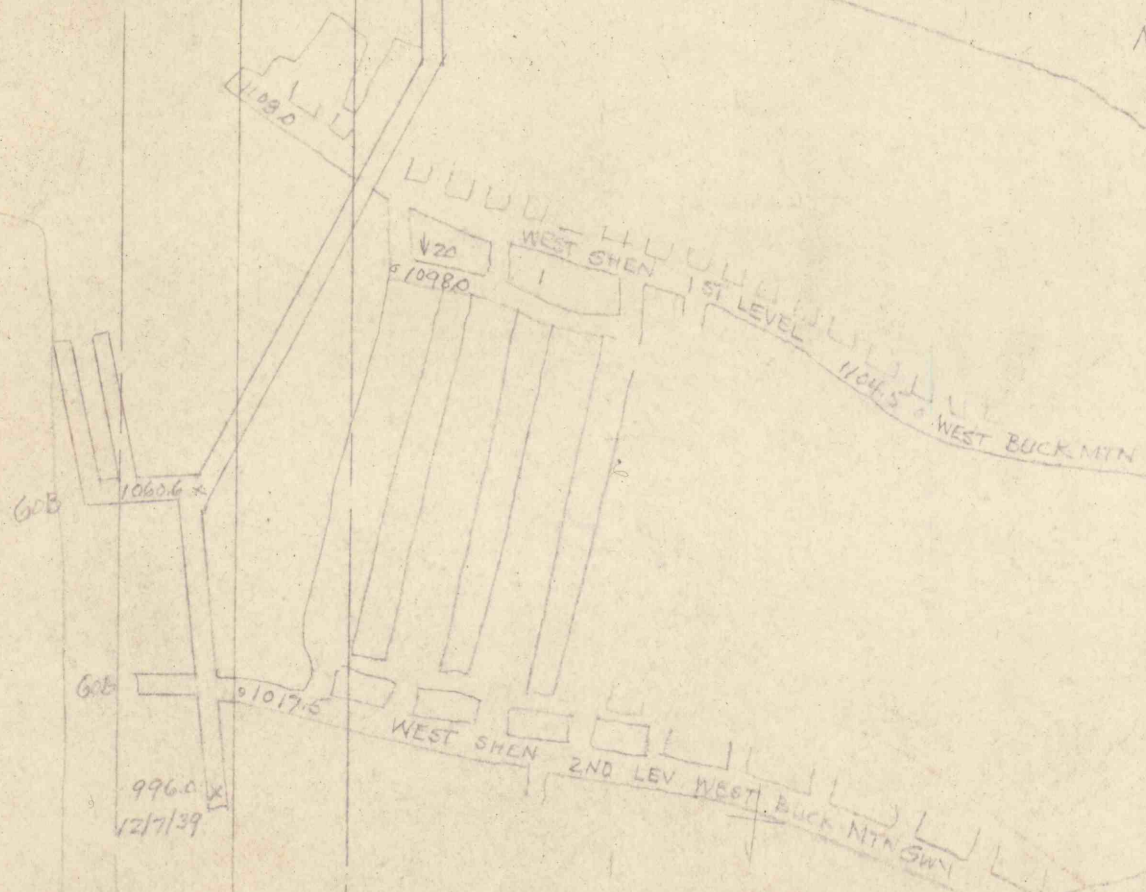

1" = 100'