54

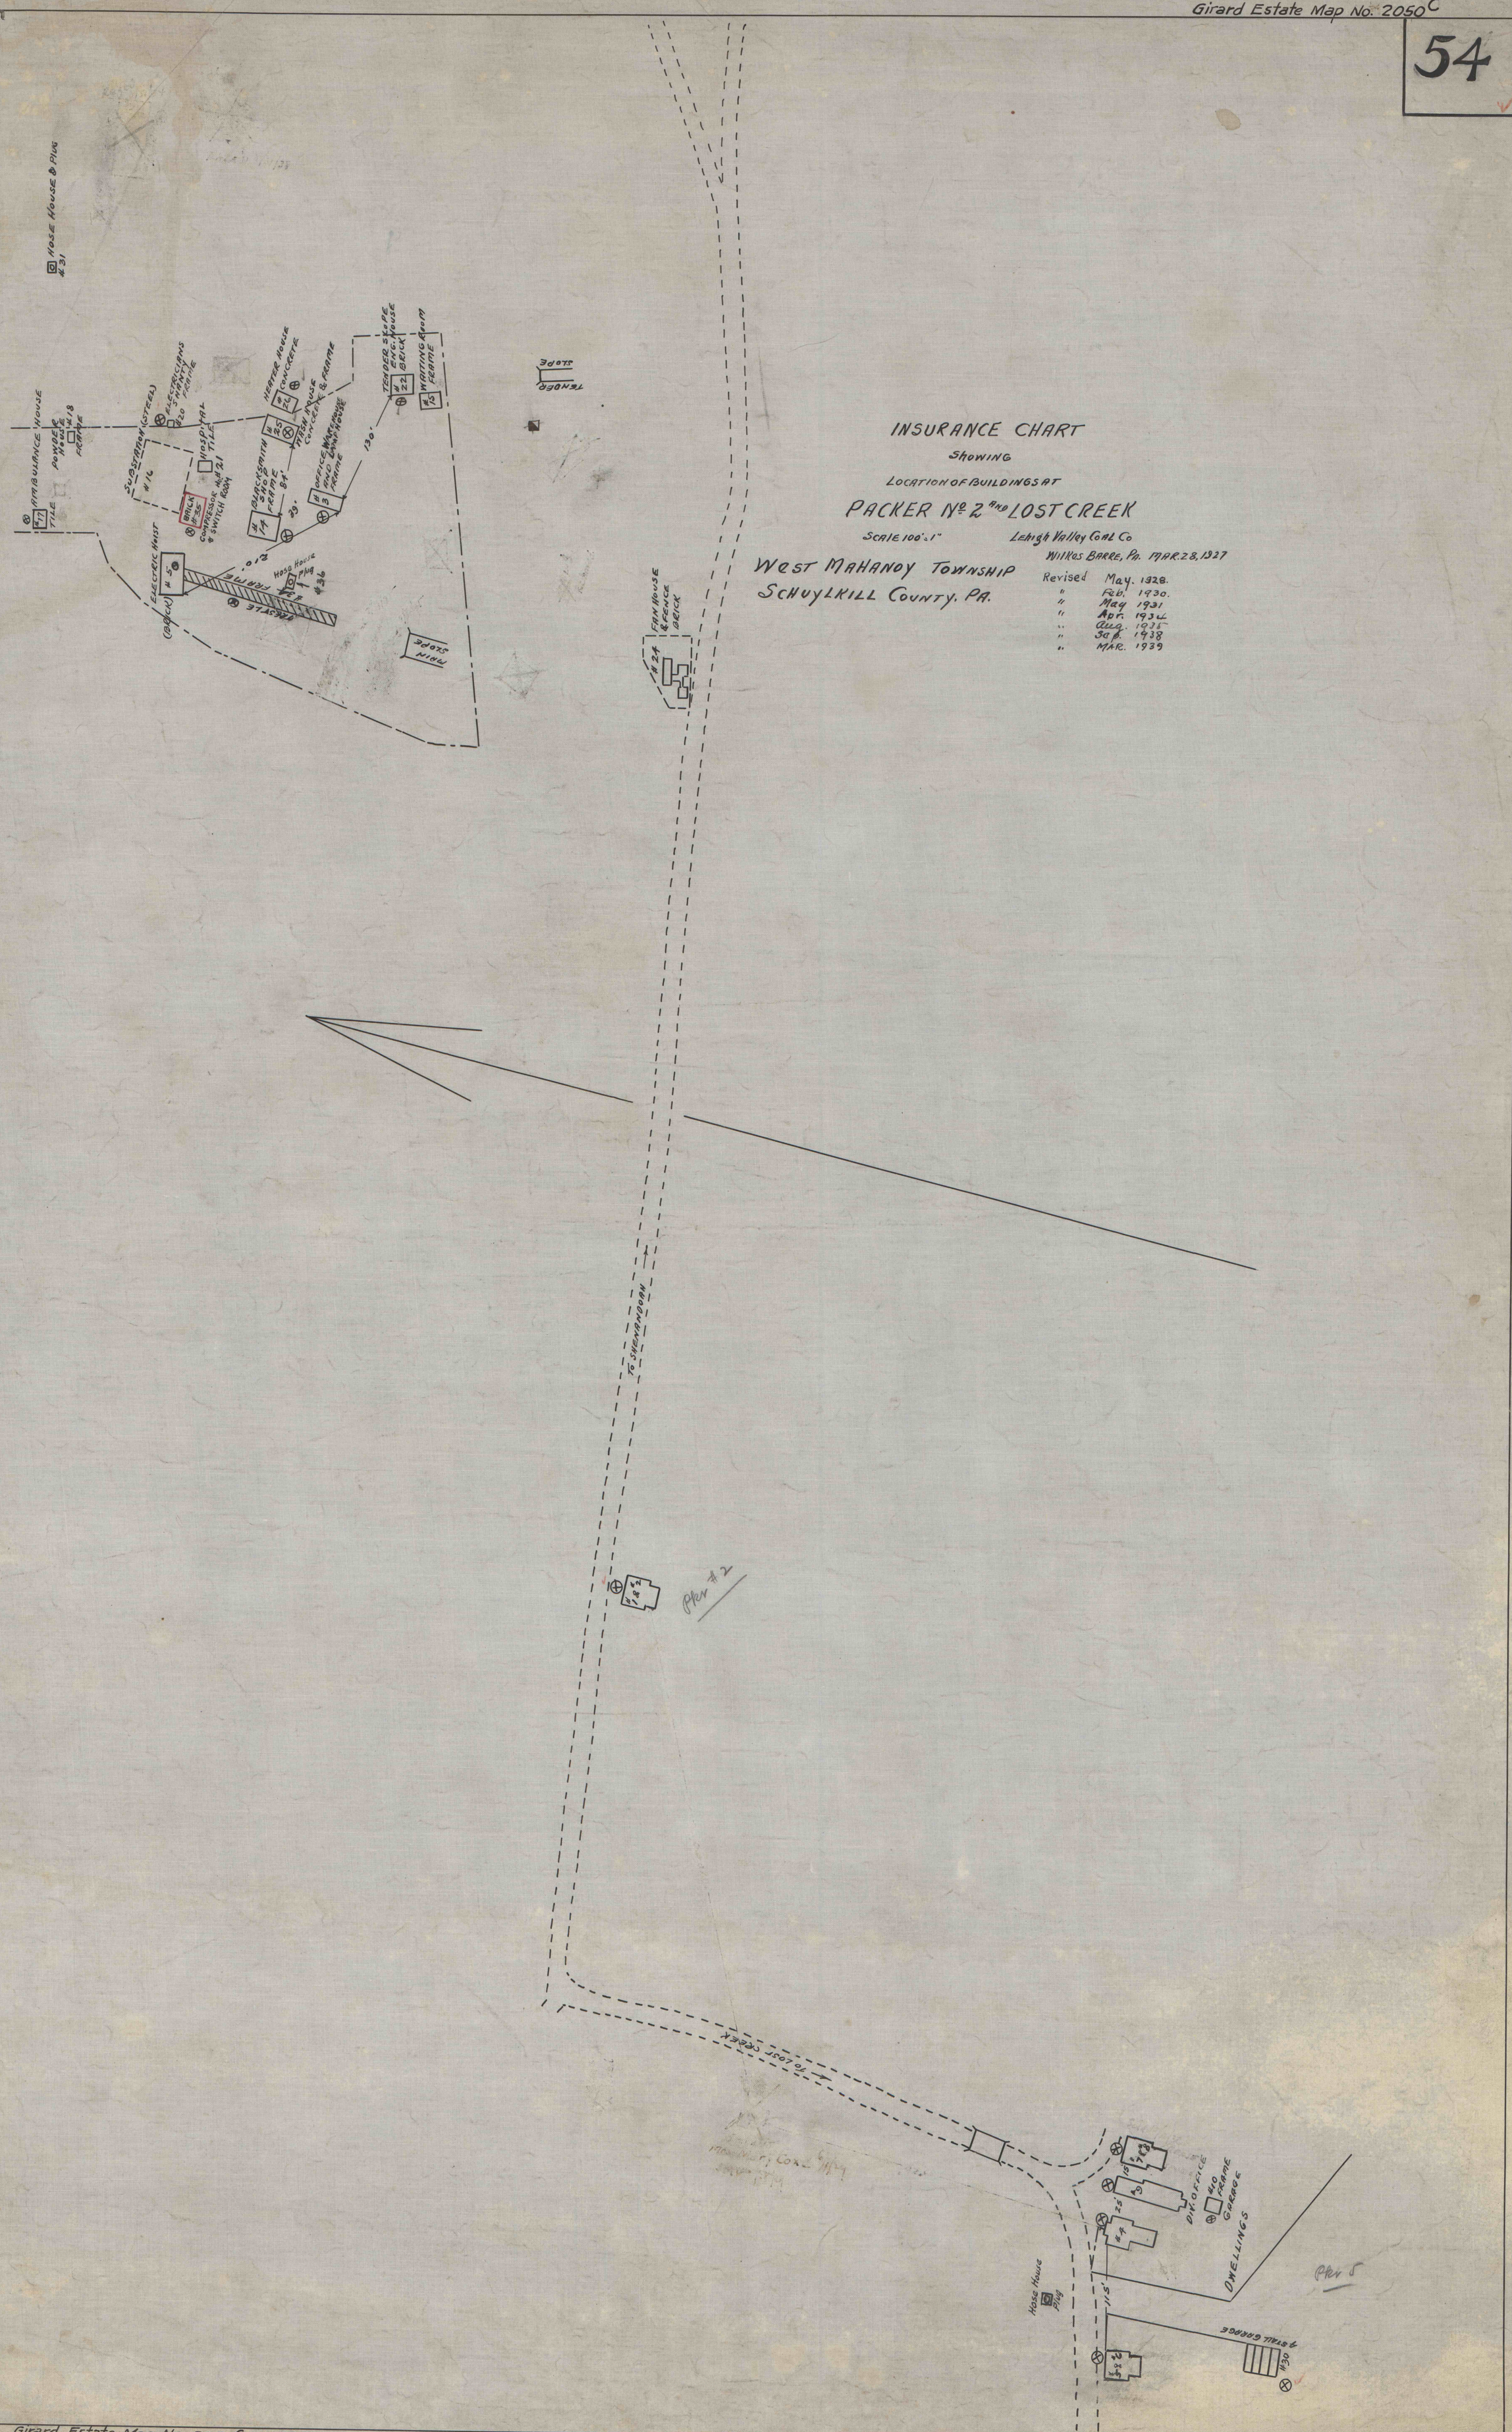
INSURANCE CHART
SHOWING
LOCATION OF BUILDINGS AT
PACKER Nº 2 AND LOST CREEK
SCALE 100'=1"
Lehigh Valley Coal Co
WILKES BARRE, PA. MAR. 28, 1927
WEST MAHANOY TOWNSHIP
SCHUYLKILL COUNTY, PA.
Revised May. 1928.
" Feb. 1930.
" May 1931
" Apr. 1934
" Aug. 1935
" Sep. 1938
" MAR. 1939
HOSE HOUSE & PLUG #31
INSURANCE HOUSE #17 TILE
POWDER HOUSE #18 FRAME
SUBSTATION (STEEL) #16
ELECTRICIANS HANDY #20 FRAME
HOSPITAL #21 TILE
COMPRESSOR & SWITCH ROOM BRICK #35
ELECTRIC HOIST (BRICK) #5
HEATER HOUSE #24 CONCRETE
BLACKSMITH SHOP #14 FRAME
WASH HOUSE CONCRETE & FRAME
OFFICE, WAREHOUSE AND LAMP HOUSE #3 FRAME
TENDER SHOP ENG. HOUSE #22 BRICK
WAITING ROOM #15 FRAME
TENDER SLOPE
MAIN SLOPE
FAN HOUSE & FENCE #24 BRICK
TRESTLE
FRAME
Hose House Plug #36
TO SHENANDOAH
TO LOST CREEK
Pkr #2
#2 Pkr
DW. OFFICE #3
#10 FRAME GARAGE
DWELLINGS
#7
#6
#5
Hose House Plug
4 STALL GARAGE #30
Pkr 5

36