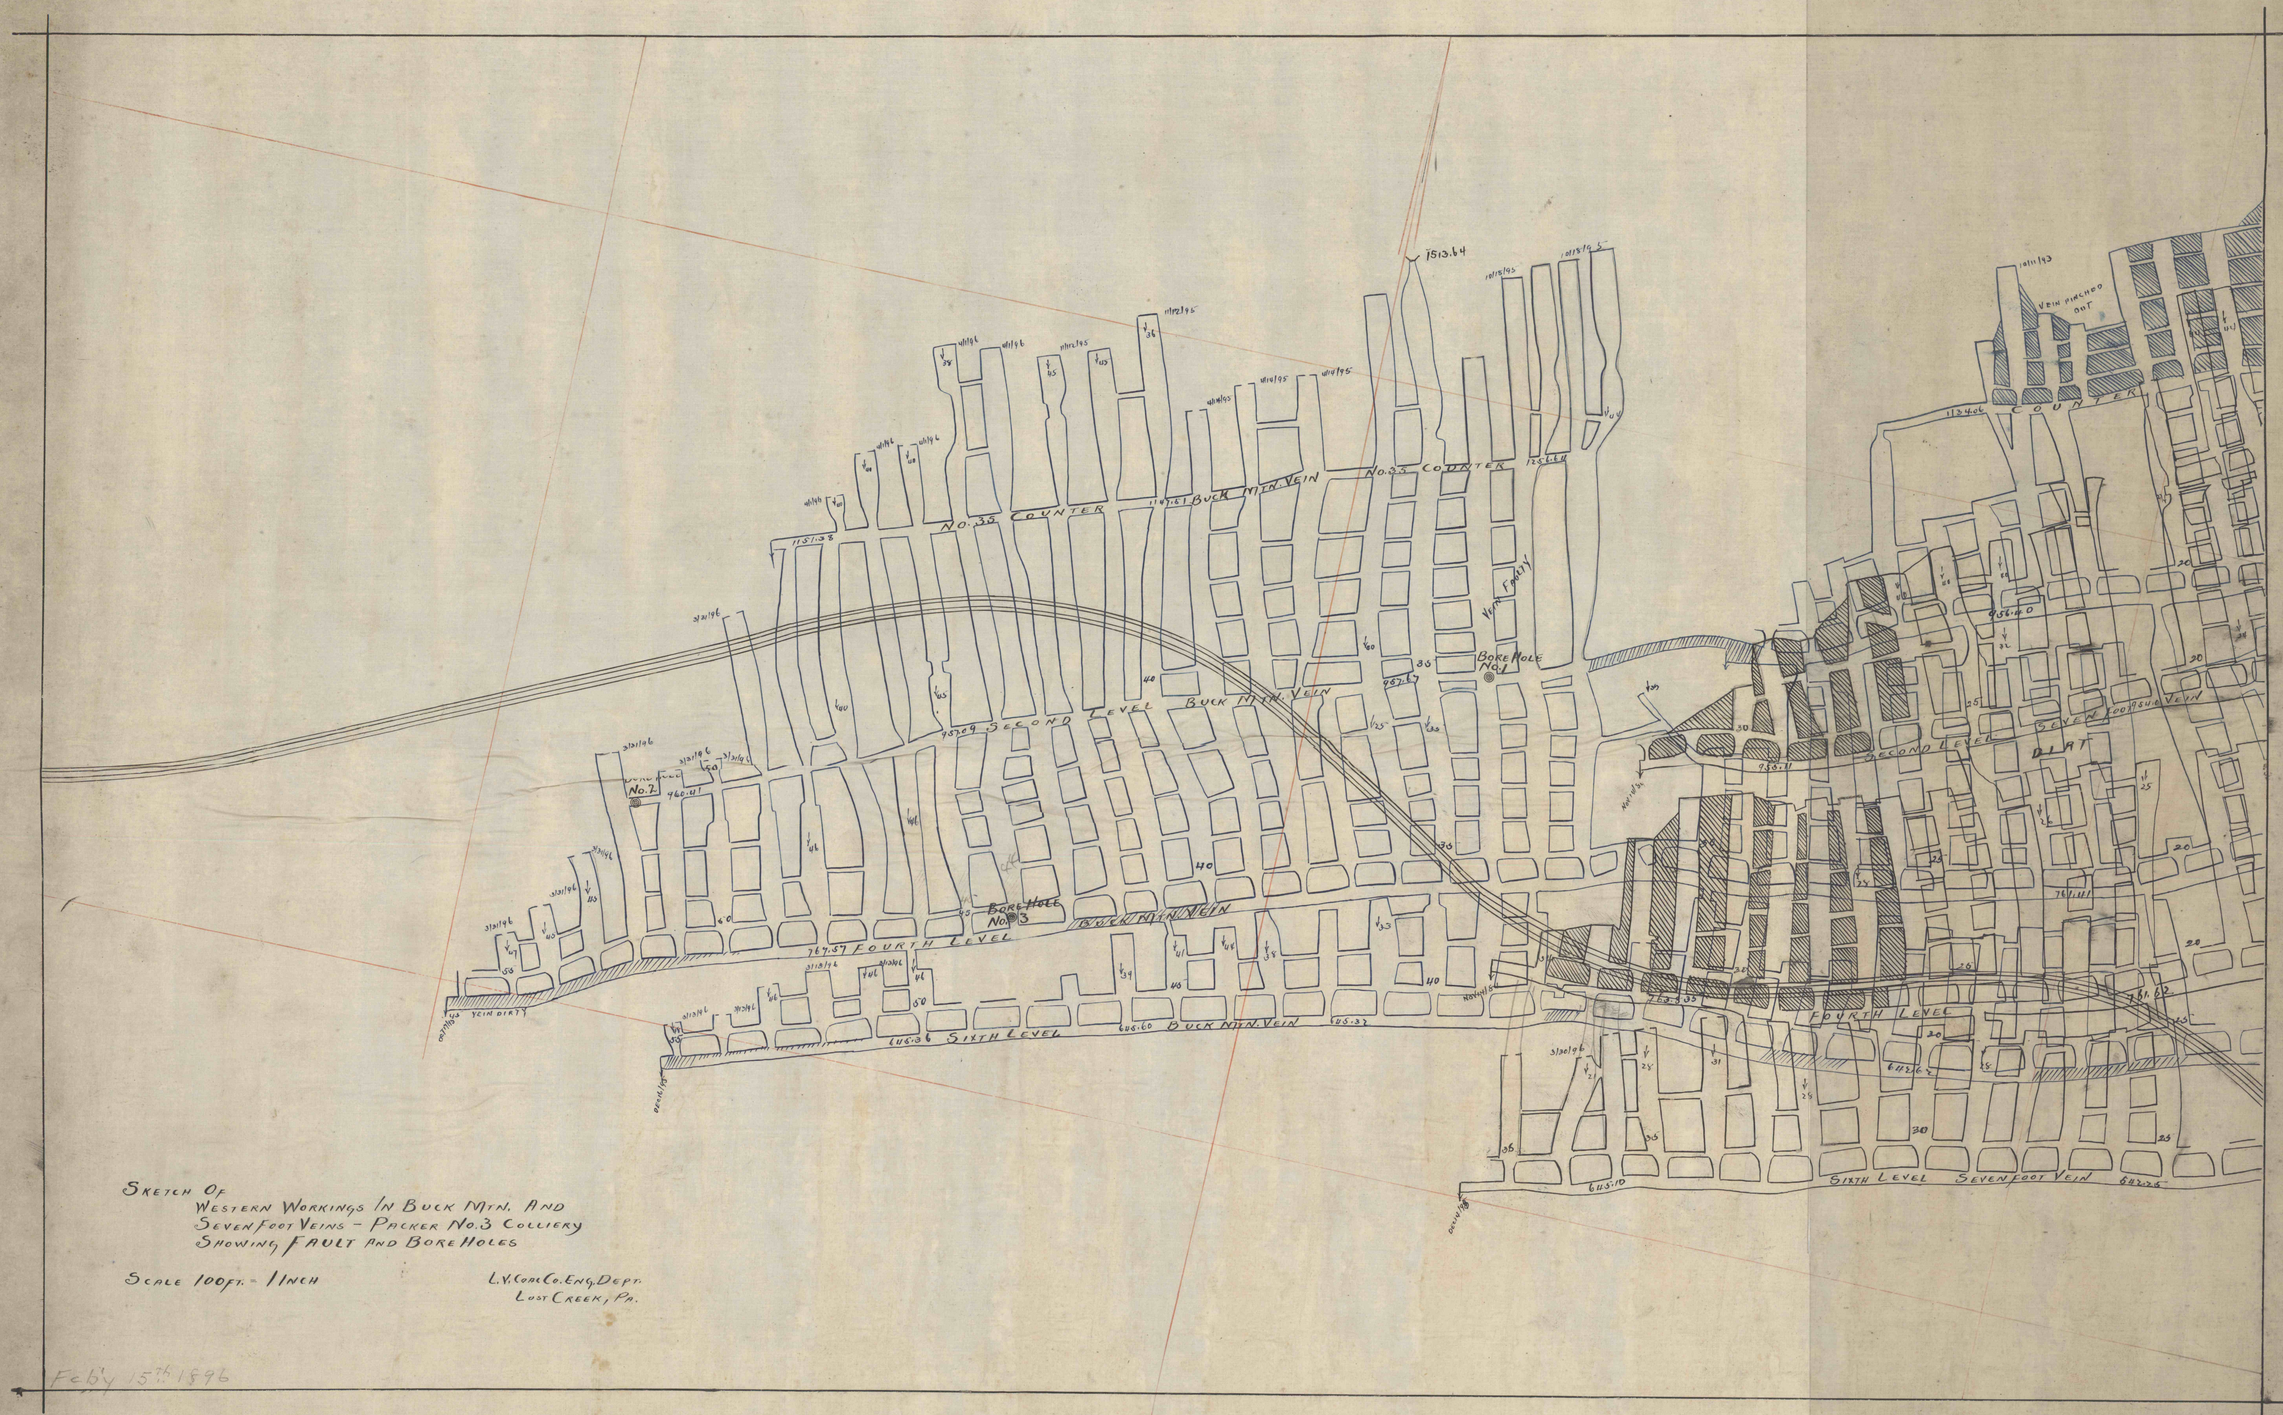

SKETCH OF
WESTERN WORKINGS IN BUCK MTN. AND
SEVEN FOOT VEINS - PACKER No. 3 COLLIERY
SHOWING FAULT AND BORE HOLES

SCALE 100 ft. - 1 INCH

L.V. COAL CO. ENG. DEPT.
LUST CREEK, PA.

Feb'y 15th 1896